

FMCSF 19.3.2  
FMR&R 7.3  
9/1/98

**GROUNDWATER SAMPLING PROGRAM**  
**5-YEAR DATA EVALUATION REPORT**

**FMC CORPORATION  
FORMER FMC PESTICIDE FORMULATION FACILITY  
YAKIMA, WASHINGTON**

*Prepared By:*

ERM-West, Inc.  
915 118th Ave. SE Suite 130  
Bellevue, WA 98005

SEPTEMBER, 1998



# TABLE OF CONTENTS

---

	<u>Page</u>
LIST OF TABLES	iv
LIST OF FIGURES	v
LIST OF ACRONYMS	vi
<b>EXECUTIVE SUMMARY</b>	<b>VII</b>
<b>SECTION 1.0</b>	<b>1-1</b>
INTRODUCTION	1-1
1.1 Site Background	1-1
1.2 Environmental Setting	1-3
1.3 Remedial Objectives	1-3
1.4 Groundwater Monitoring Workplan Modifications	1-5
1.5 Site Hydrogeology	1-6
<b>SECTION 2.0</b>	<b>2-1</b>
SITE CHARACTERIZATION	2-1
2.1 Source Area	2-1
2.1.1 Boundary Zone Between Areas 4 and 5	2-1
2.1.2 Area 6	2-4
2.1.3 Former Disposal Pit Area	2-4
2.1.4 Undiscovered Source Areas	2-5
2.1.5 Discussion	2-5
2.2 Compounds of Concern	2-7
2.3 Extent in Groundwater	2-11
<b>SECTION 3.0</b>	<b>3-1</b>
FATE AND TRANSPORT	3-1
3.1 Transport to Groundwater	3-1
3.1.1 Solubility and Soil Affinity	3-1
3.1.2 Source of Water	3-2
3.1.3 Advective Groundwater Transport	3-5
3.1.4 Colloidal Particle Transport	3-5
3.2 Fate in Groundwater	3-10
<b>SECTION 4.0</b>	<b>4-1</b>
RISK ASSESSMENT	4-1
<b>SECTION 5.0</b>	<b>5-1</b>
DATA EVALUATION	5-1

## TABLE OF CONTENTS

---

	<u>Page</u>
<b>SECTION 6.0</b>	<b>6-1</b>
CONCLUSIONS	6-1
<b>SECTION 7.0</b>	<b>6-1</b>
RECOMMENDATIONS	7-1
<b>SECTION 8.0</b>	<b>8-1</b>
REFERENCES	8-1

## TABLE OF CONTENTS

---

APPENDIX A	GROUNDWATER ANALYTICAL DATA
APPENDIX B	BORING LOGS AND MONITORING WELL AS-BUILTS
APPENDIX C	HELP MODEL OUTPUT

## LIST OF TABLES

---

<u>Tables</u>		<u>Page</u>
TABLE 1-1	Groundwater Elevations (1997)	1-8
TABLE 2-1	Summary of Soil Sample Analytical Results	2-3
TABLE 3-1	VOC Concentrations in Groundwater	3-3
TABLE 3-2	Summary of Water Balance Computations	3-4
TABLE 3-3	Comparison of Filtered and Unfiltered Sample Concentrations in the W-13 October 1997 Sample	3-9

## LIST OF FIGURES

---

<u>Figures</u>		<u>Page</u>
FIGURE 1-1	Topographic Map	1-2
FIGURE 1-2	Potentiometric Surface (1997)	1-4
FIGURE 2-1	RI Area Designations	2-2
FIGURE 2-2	Dieldrin Concentrations in Phase II Pit Excavation Confirmation Samples	2-6
FIGURE 2-3	Concentration of Aldrin plus Dieldrin in Selected Wells	2-8
FIGURE 2-4	Concentration of DD-Series in Selected Wells	2-9
FIGURE 2-5	Concentration of Endosulfans in Selected Wells	2-10
FIGURE 2-6	Organochlorine Compounds in Groundwater October, 1997	2-12
FIGURE 2-7	Organochlorine Compounds in Groundwater, September, 1995	2-13
FIGURE 3-1	Endosulfan Concentration versus Water Level in W-13	3-6
FIGURE 3-2	Dieldrin plus Aldrin Concentration versus Water Level in W-13	3-7
FIGURE 3-3	June, 1995 Ratio of Aldrin to Dieldrin in Groundwater	3-11
FIGURE 4-1	Water Well Survey Locations	4-2

## **LIST OF ACRONYMS**

---

<u>Acronym</u>	<u>Definition</u>
ANOVA	Analysis of Variance
CERCLA	Comprehensive Environmental Response, Compensation, and Liability Act
CR	Carcinogenic risk
FMC	FMC Corporation
HELP	Hydrogeologic Evaluation of Landfill Performance
MDL	Method Detection Limit
NPL	National Priorities List
PQL	Practical qualification limits
RI/FS	Remedial Investigation/Feasibility Study
ROD	Record of Decision
USEPA	United States Environmental Protection Agency
VOC	Volatile Organic Compounds

## **EXECUTIVE SUMMARY**

---

The FMC Yakima Pit site consists of a 58,000 square foot area where pesticide dusts and liquids were processed between 1951 and 1986. From 1952 until 1969 wastes associated with the pesticide processing were disposed of in an onsite pit. After 1969, waste materials were disposed of offsite. Liquid products were blended onsite in the 1970s using solvents, emulsifiers and stabilizers. Accidental releases of the liquid materials contaminated soil and concrete at the site.

A Remedial Investigation (RI) was conducted at the site in 1988, and removal actions consisting of excavating, removing and disposing over 850 tons of contaminated soil were completed in 1988 and 1989. In 1990 a Record of Decision (ROD) for the site was implemented. The ROD addressed the contamination that remained in the process areas and some contaminated soil beneath the former disposal pit. The ROD specified removal of additional pesticide- and metal-contaminated soil, and some buildings and concrete structures. The soil excavation and structure demolition was completed between August and December 1992. Approximately one-third of excavated soil was cobble, which was determined to be clean and returned to excavated areas. The balance of the soil was incinerated or disposed offsite as hazardous waste. The ROD specified a groundwater monitoring program be implemented to monitor the effect of the contaminant source removal on groundwater (Bechtel, 1994).

The groundwater monitoring program has been conducted by ERM since December, 1993 on a quarterly basis. During 1993, quarterly monitoring was completed by others. The program has shown that since completion of the removal actions, the following pesticide compounds that were previously present in groundwater are no longer detected.

- Endrin-series compounds last detected in March, 1995;
- Dicofol, ovex, and perthane last detected in June, 1994.
- 4,4-Methoxychlor last detected in April, 1994;
- Heptachlor epoxide last detected in July, 1993, and heptachlor last detected in April, 1993;
- Chlordane last detected in August, 1992; and,
- Toxaphene and captan last detected in March, 1991.

Pesticides that continue to be detected in groundwater are the organochlorine pesticides DDT, aldrin, dieldrin and endosulfans. Of these compounds, only

dieldrin and DDT are present at concentrations that exceed risk-based ( $10^{-6}$  cancer risk) concentrations.

This report evaluates the groundwater monitoring data collected to date at the site. The extent and seasonal fluctuation in concentration of the organochlorine pesticides still present in groundwater is evaluated. The transport mechanisms that effect organochlorine pesticides in groundwater at the site are discussed, and the ultimate fate of these compounds is determined.

Results of these evaluations suggest that the extent of the organochlorine pesticides still present at the site is stable (i.e., plume positions are not moving). A seasonal fluctuation in concentrations, caused by recharging irrigation water that increases groundwater elevations, is apparent.

There is minimal potential of risk to human health or the environment from these compounds in groundwater provided there is a restriction of on-site use of groundwater. Because of the minimal potential risk, and the stability of the contaminant plumes, the following recommendations are made.

- Institutional controls restricting the use of site groundwater should be implemented.
- Groundwater monitoring should be continued at the site until organochlorine pesticide compounds still present in groundwater at the site are no longer detected. The frequency of sampling, and number of wells sampled, however, should be reduced to reflect the limited area of risk-based exceedances.

## **SECTION 1.0**

---

### **INTRODUCTION**

FMC Corporation (FMC) has completed the removal of approximately 6,000 cubic yards of soil and on-site incineration of approximately 3,800 cubic yards of soil at FMC's former agricultural chemical site in Yakima, Washington. This work was conducted following the *Remedial Action Work Plan* (dated January 30, 1992) approved by the United States Environmental Protection Agency (USEPA) pursuant to the Comprehensive Environmental Response, Compensation, and Liability Act (CERCLA) Record of Decision (ROD). The ROD requires FMC to conduct a five-year groundwater monitoring program to demonstrate the effectiveness of the site remedial actions.

To satisfy requirements for groundwater monitoring during various stages of the site investigation, FMC installed a network of monitoring wells. Fourteen rounds of sampling have been completed to satisfy the ROD requirement. Quarterly monitoring was completed for four years; currently sampling is completed semi-annually. All sampling events have been conducted as described in the report entitled *Long-Term Monitoring Plan* (ERM, June 1994). Analytical results of these sampling events, as well as results from previous sampling events, are presented in Appendix A.


This report evaluates the groundwater monitoring data collected to date. The objective of this evaluation is to support the FMC and USEPA 5-year review of the groundwater monitoring program. The format of the report is as follows:

- Section 1.0 Introduction
- Section 2.0 Potential Source Area Analysis
- Section 3.0 Fate and Transport
- Section 4.0 Data Evaluation
- Section 5.0 Conclusions

#### **1.1 Site Background**

---

The former FMC Yakima pesticide formulation facility is located at Four West Washington Avenue (Figure 1-1), approximately 1 mile east of the Yakima Municipal Airport in Yakima, Washington. The site consists of a 58,000-square-foot fenced area leased from the Union Pacific Railroad. FMC operated the facility from 1951 to 1986. Waste materials and an estimated 2,000 pounds of

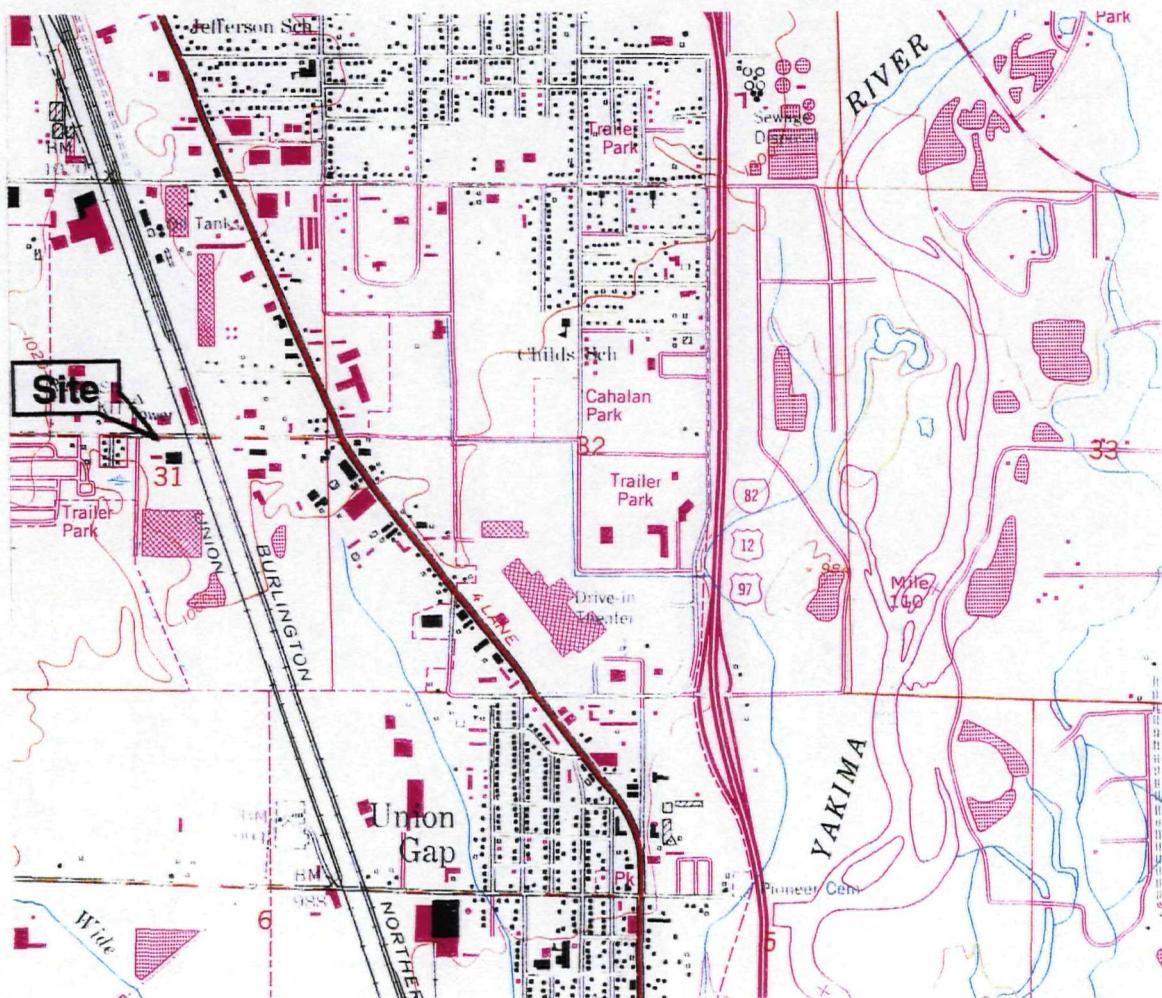

**Figure 1-1**  
**Topographic Map**  
**Former FMC Pesticide Formulation Facility**  
**Yakima, WA**

1" - Approx. 2000'  
0 2000'

Base From USGS  
7.5 Minute Topographic  
Map Series, Yakima East  
Washington Quadrangle (1985)

various chemicals were dumped into an on-site disposal pit between 1952 and 1969.

A preliminary investigation was conducted for USEPA in 1982, and the site was subsequently placed on the National Priorities List (NPL). An Administrative Order issued by the State of Washington in 1983 required a study of the former disposal pit area. USEPA issued a Consent Order in 1987 requiring an RI/FS for the site. The RI/FS was followed by FMC's removal of the pit contents in two phases between 1988 and 1989. A Superfund Record of Decision (ROD) was issued in 1990 to specify selected remedies to address residual site contamination. Subsequent remedial actions included removal of additional contaminated soil and concrete as well as groundwater monitoring.

Structures remaining on the site include an office building, a warehouse with loading dock, and a parking lot. The property was sold by the railroad in 1992. The site currently contains an active metal fabrication facility and parking lot. Figure 1-2 shows these structures, the location of the former disposal pit, and the groundwater monitoring wells.

## **1.2 Environmental Setting**

---

The former FMC Yakima site slopes to the southeast with a grade of less than one percent. The property is outside the 500-year flood plain of the Yakima River 1.5 miles east of the site and Wide Hollow Creek, which is approximately 1 mile south of the site. No surface water bodies or wetlands exist on the property. Vegetation within the fenced site is limited to weedy forbs and grasses.


## **1.3 Remedial Objectives**

---

The remedial objective of the groundwater monitoring program is to demonstrate that previous remedial actions on the site have been successful in protecting human health and the environment. The ROD specified soil cleanup levels for dieldrin, endosulfans and DD-series compounds (DDD, DDE, and DDT) along with a number of additional compounds. ROD specified cleanup levels have been attained for all site soils with the exception of areas discussed in Section 2.0. In addition, the ROD specified a five year groundwater monitoring program to evaluate and confirm contaminant source removal.

In accordance with provisions of the ROD, the Yakima groundwater monitoring program is intended to determine if:

- Health-based concentrations of chemicals are achieved;

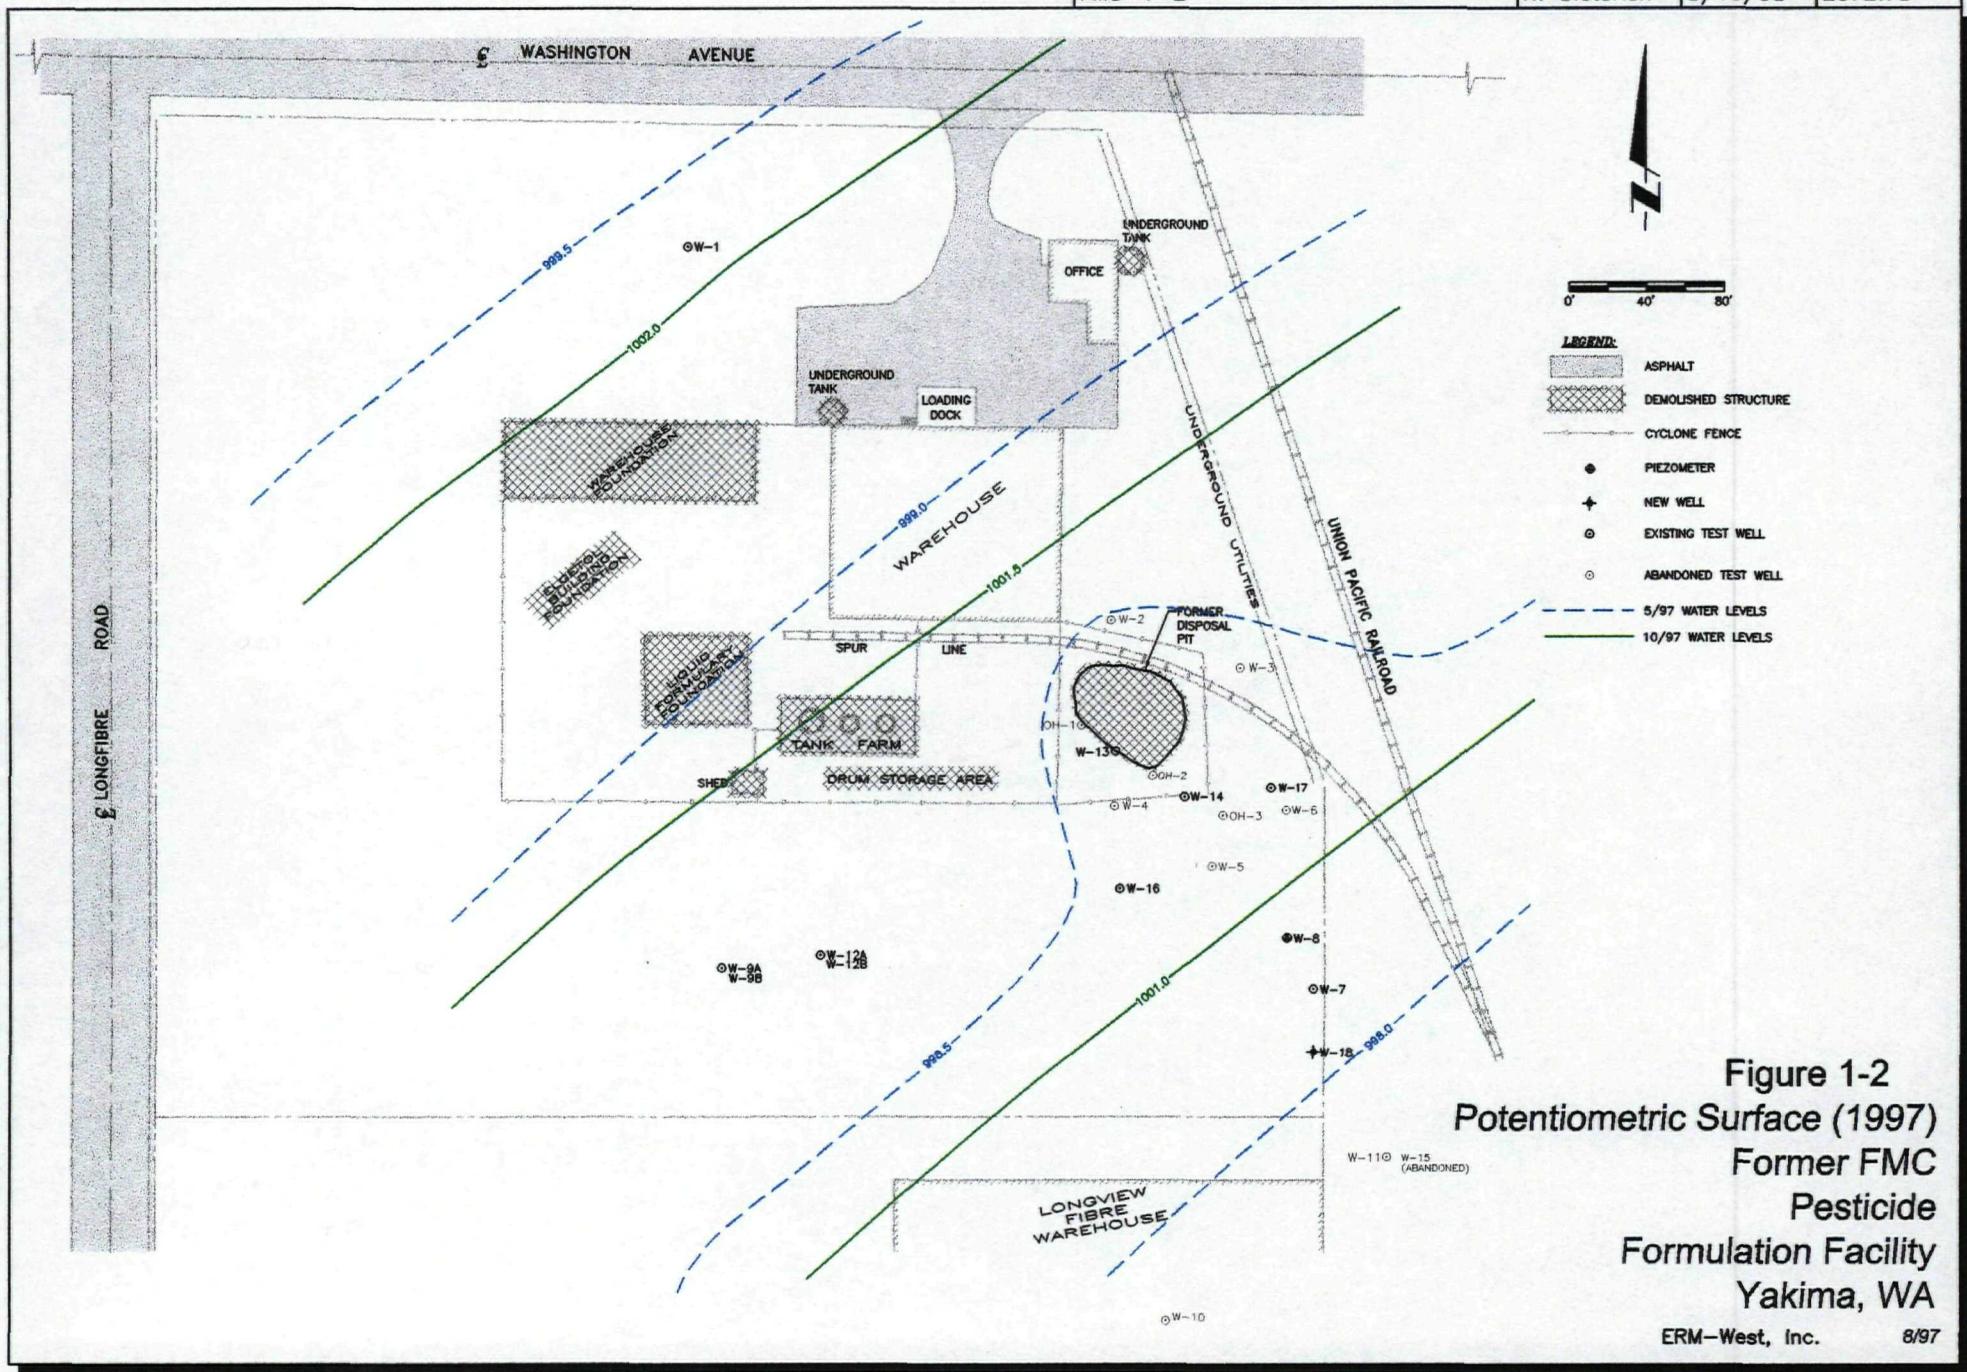

- Chemical concentrations show a declining trend; and
- Sources of groundwater contamination have been removed.

When the ROD was issued, pesticide constituents of concern in groundwater were endosulfans and DD-series compounds (DDD, DDE, and DDT). Since the ROD was issued the non-carcinogenic hazard index for endosulfans has been revised, resulting in a new hazard index risk criterion of 200 µg/l. The concentration of endosulfans in site groundwater is significantly less than 200 µg/l; however, EPA is requiring the continued monitoring of endosulfan because it is suspected to be an endocrine disrupter, and the chronic toxicity of that entire class of chemicals is under review by EPA. In addition, the fact that endosulfan concentrations in groundwater have increased following the removal action is of concern.

The  $10^{-6}$  carcinogenic risk (CR) level for dieldrin is 0.004 µg/l, and the CR level for DDT is 0.2 µg/l. By mutual agreement between EPA and FMC, ROD indicator parameters for comparison with semi-annual sampling data based on the greater of the CR level and laboratory practical qualification limits (PQLs) are currently as follows:

- Dieldrin at 0.05 µg/l; and,
- DDT at 0.2 µg/l.

## **1.4 Groundwater Monitoring Workplan Modifications**

---

To satisfy the remedial objectives, the monitoring plan provides extensive data for the first 2 years of sampling. The well sampling frequency was modified after the first two sampling events (December 1993 and March 1994) as described in the *Long-Term Monitoring Plan*. The modifications included:

- Analyzing only for organochlorine pesticides;
- Abandonment of wells OH-1, OH-2, and OH-3; and
- Installation of replacement wells W-13(OH-1) and W-14(OH-2).

Additional modifications to the sampling plan requested by the USEPA in June 1995 included:

- Addition of monitoring well W-7 and W-1 to the sampling events;
- Replacement of damaged and abandoned monitoring well W-11 with W-15;

- Abandonment of monitoring well W-10; and,
- Replacement of previously abandoned monitoring wells W-2, W-3, W-4, W-5 and W-6 with W- 16 and W-17.
- Use of low-stress, low volume sampling techniques.

USEPA and FMC agreed in January 1996 to modify the sampling event frequency to semi-annually following the second quarter 1996 sampling event. Subsequent sampling events will occur during the second and fourth quarters of each year during the weeks of 15 April and 15 October.

Monitoring well W-15 was irreparably damaged in late November 1996 and has since been abandoned, leaving W-7 as the most downgradient well.

## 1.5 Site Hydrogeology

---

A total of 21 monitoring wells have been installed on the FMC site and the immediate vicinity. Twelve of these monitoring wells are currently monitored semiannually. Other wells have been properly abandoned. A copy of the boring logs and a summary of as-built diagrams for all monitoring wells are included as Appendix B of this report.

Groundwater from the unconfined alluvium aquifer occurs at a seasonally high depth of about 2 to 3 feet below grade and an average depth of 7 to 8 feet below grade. The alluvium aquifer, which extends to 35 to 40 feet below grade, is underlain by cemented basalt.

Groundwater elevations exhibit a five to seven foot seasonal fluctuation at the site. The highest groundwater elevation (999 to 1,002 feet above mean sea level (ft amsl)) typically occurs in September, and the lowest groundwater elevation (995 to 997 ft amsl) occurs in February and March. The contrast is shown in Figure 1-2, which shows the potentiometric surface in May and October, 1997. Groundwater elevations are listed on Table 1-1. The groundwater flow direction in the alluvial aquifer is to the southeast. The horizontal flow ranges from 0.002 to 0.003 feet per foot (ft/ft). The main source of recharge is from crop irrigation; the source of water is primarily surface water through canals. Elevated groundwater elevations caused by recharge of irrigation water occurs from May through September each year. Recharge from precipitation, which is minor compared with recharge from irrigation, occurs primarily from January through April.

Three well nests are present at the site. At each of the well nests, measurements indicate that a downward vertical groundwater flow gradient exists. The average vertical gradient is 0.02 feet per foot (ft/ft). The potentiometric surface is between

0.2 and 0.7 feet higher at the water table surface compared with the base of the aquifer. This variation in head is from hydraulic friction loss along the vertical flow path.

Aquifer characteristics were evaluated by conducting an 8-hour aquifer pumping test on W-7 in 1989. The test was conducted at a discharge rate of 52 gpm. Distance drawdown analysis by Jacob's straight line method results in a calculated transmissivity of 76,300 gpm/ft<sup>2</sup> and a storativity of 0.19 (Lohman, 1979). For an aquifer thickness of 30 feet, calculated hydraulic conductivity is 5,500 gpd/ft<sup>2</sup>. Distance drawdown data is as follows:

Well Number	Distance to Pumping Well (feet)	Maximum Drawdown (feet)
W-7	0	1.32
W-8a	30	0.29
OH-3	103	0.1

For the alluvial aquifer the seepage velocity is calculated to be 7 ft/day. This value is calculated from the hydraulic conductivity estimated from the aquifer test using Darcy's Law ( $v = K [i/n]$ ), assuming a volumetric porosity of 0.25, and an average hydraulic gradient of 0.003 ft/ft.

**TABLE 1-1**  
**1997 Groundwater Elevations**

<b>WELL</b>	<b>Top of Screen</b>	<b>Bottom Screen</b>	<b>Top of Casing</b>	<b>May, 1997</b>	<b>May, 1997</b>	<b>October, 1997</b>	<b>October, 1997</b>
	(ft amsl)	(ft amsl)	(ft amsl)	Depth to Water (ft bgs)	Groundwater Elevation (ft amsl)	Depth to Water (ft bgs)	Groundwater Elevation (ft amsl)
<b>Existing Wells</b>							
W-1	1001.81	996.81	1006.79	7.37	999.42	4.74	1002.05
W-7	984.16	969.16	1004.60	7.15	997.45	4.32	1000.28
W-8A	968.18	967.13	1004.94	--	--	4.53	1000.41
W-8B	981.36	980.31	1005.04	--	--	4.48	1000.56
W-8C	993.27	992.32	1005.11	--	--	4.18	1000.93
W-9A	971.3	966.3	1004.10	5.68	998.42	2.96	1001.14
W-9B	994.8	989.8	1004.39	5.78	998.61	3.06	1001.33
W-12A	990.45	985.45	1004.76	6.40	998.36	3.63	1001.13
W-12B	998.45	993.45	1004.88	6.30	998.58	3.56	1001.32
W-13	999.26	989.26	1004.36	5.91	998.45	3.08	1001.28
W-14	998.68	988.68	1005.29	6.86	998.43	4.1	1001.19
W-16	998.58	988.58	1004.38	5.90	998.48	3.15	1001.23
W-17	998.14	988.14	1004.94	6.60	998.34	3.84	1001.10

## **SECTION 2.0**

---

### **SITE CHARACTERIZATION**

A complete characterization of the former FMC pesticide formulation facility, including historical chemical usage and disposal history and nature and extent of contamination, is included in the Phase 2 Remedial Investigation (RI) report completed in 1990 (Bechtel, 1990). Additional site characterization data is included in individual operable area closure reports. Information on residual soil contamination, and groundwater contamination, is presented in this section.

#### **2.1 Source Area**

---

Potential sources of organochlorine compounds in groundwater at the site are from residual soil contamination. Based on Phase 2 RI and operable area closure reports, the following are areas with residual soil contamination:

- The boundary zone between Area 4 and 5;
- Area 6; and,
- The former Disposal Pit Area;

The remedial investigation area designations and soil sample locations are shown in Figure 2-1. Results of selected soil sample analyses are shown in Table 2-1.

##### **2.1.1 Boundary Zone Between Areas 4 and 5**

Dieldrin and DD-series compounds at concentrations greater than the ROD cleanup levels were detected in post excavation soil samples S-74, S-77, and S-171 obtained in 1990 near boundary of the former drum storage area (Area 4) and the tank farm (Area 5).

To determine whether this area contributed to pesticides detected in groundwater, soil samples were obtained in August 1995 from borings (B-1 and B-2) located adjacent to samples S-74 and S-171. Analytical results, presented in Table 2-1, indicate that dieldrin and DD-series compounds in this area have degraded by a factor of 10 or more to concentrations less than ROD cleanup levels.

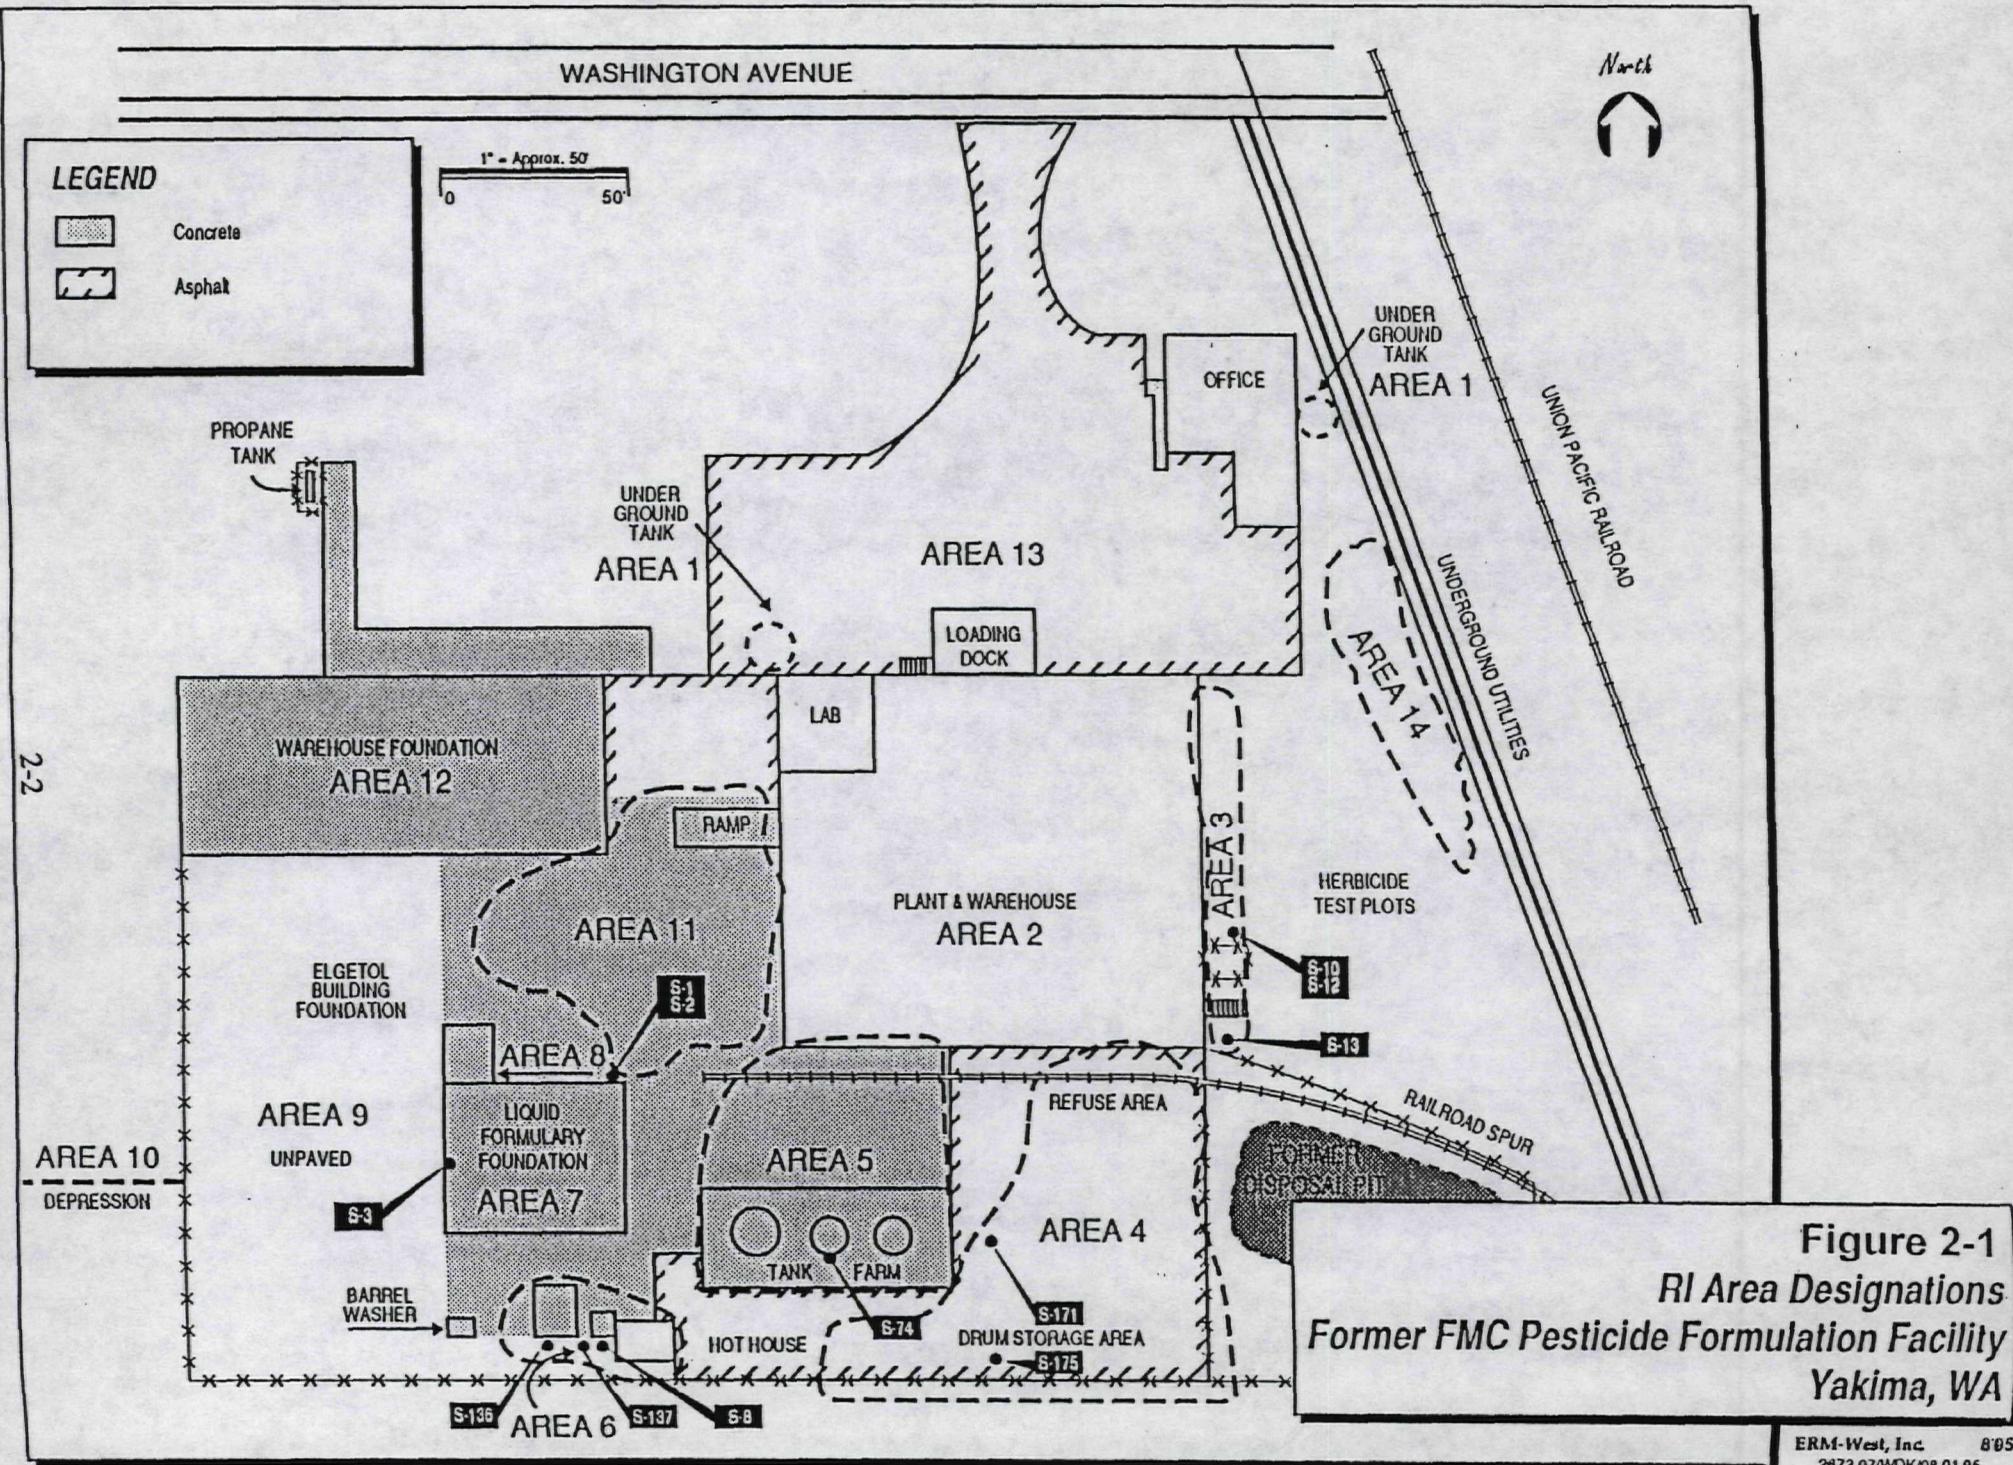


TABLE 2-1

*Summary of Soil Sample Analytical Results*

Sample	Depth of Sample (feet)	4,4'-DDD	4,4'-DDE	4,4'-DDT	Dieldrin	Endosulfans
ROD Cleanup Level (0-2 ft)		5.1	3.6	3.6	0.076	4.2
ROD Cleanup Level (2-7 ft)		25.5	18	18	1	13.5
<b><u>Post-excavation samples exceeding ROD cleanup level.</u></b>						
S-1	1.8	ND	ND	ND	ND	75
S-2	2.5	ND	ND	ND	ND	69
S-3	6.3	ND	ND	ND	ND	186
S-8	5.8	ND	ND	67	40	ND
S-10	1.9	ND	3.1	11	0.19	1.49
S-12	4.9	ND	3.2	23	ND	0.21
S-13	0.0	76	28	210	ND	68
S-74	7.0	150	24	100	47	296
S-77	7.0	32	1	4	4	109
S-136	7.0	22	10	9	10	276
S-137	7.0	22	10	6	10	268
S-171	7.0	52	2	42	30	165
S-175	2.5	7	0.05	0.3	1	0.55
<b><u>Samples collected by hollow-stem auger borings in August, 1995.</u></b>						
B-1 (near S-74)	8	0.64	0.095	0.23	0.29	0.92
B-2 (near S-171)	8	2.8	0.25	0.26	0.56	7.8

ND - Not Detected

All values are shown in micrograms per kilogram.

Areas 4, 5 and 6 were backfilled with cobbles that were excavated at the site and screened. The backfill is more permeable since the fines (silt and sand) were removed. As a result, groundwater flows through this area more easily than before the excavation, and at a faster rate than surrounding areas. This is especially true when the groundwater levels are elevated during the summer and fall irrigation season. Since the cobbles are more permeable than the surrounding soils, groundwater elevations are slightly lower within this area immediately adjacent to and above soil with residual organochlorine compound contamination. As a result, excess groundwater is pulled through those residually contaminated soils into the cobble backfill and drawn in a cross-gradient direction toward the former disposal pit area.

### **2.1.2 Area 6**

Dieldrin at concentrations greater than the ROD cleanup levels was detected in subsurface soil samples S-136 and S-137 (obtained in 1992) in Area 6. The detected concentrations, however, were considerably lower than those in the boundary zone between Areas 4 and 5. In addition, dieldrin has not been detected in downgradient monitoring wells W-9a, W-9b, W-12a or W-12b since October 1994. Consequently, it is not likely that dieldrin and DD-series compounds in soil from Area 6 contribute to groundwater contamination.

### **2.1.3 Former Disposal Pit Area**

The former disposal pit is shown in the southeast part of the site in Figure 1-2. The initial remedial excavation of the disposal pit occurred in June 1988 and removed contamination to a depth of 4 feet below grade where groundwater was encountered. A subsequent remedial excavation, completed in March of 1989, stopped at a depth of 7 feet below grade when groundwater was encountered. Closure samples confirmed that contamination remained above ROD cleanup levels in a 3,600 square foot area in the former disposal pit area. USEPA agreed at the time that further excavation was not warranted or practical. In the 1989 removal action, dieldrin concentrations in soil samples obtained from the limits of the excavation ranged from 0.02 to 4.0 mg/kg; DDT concentrations ranged from 0.2 to 38 mg/kg. All other parameters were less than ROD cleanup levels. Soil sample location and analytical results are presented in Figure 2-2.

As discussed in Section 1.5, groundwater elevation fluctuates between 2 and 8 feet below grade. Residual soil contamination at the base of the excavation, which is 7 feet below grade, is in direct contact with groundwater during periods

of average and seasonally high groundwater levels. Elevated groundwater levels caused by recharge of irrigation water occur from May through September each year. The highest groundwater elevation (999 to 1,002 ft amsl) typically occurs in September, and the lowest groundwater elevation (995 to 997 ft amsl) occurs in February and March. A comparison of these elevations with the elevations of the disposal pit excavation, shown on Figure 2-2, shows that during the annual high water table event, groundwater is in direct contact with contaminated soil that remains at the base of the excavation.


Maximum concentrations of dieldrin and endosulfan are typically detected in the fall after the annual high water table event. Groundwater monitoring wells W-13 and W-14 are hydraulically downgradient from the disposal pit. These two monitoring wells have had the greatest and most persistent detections of organochlorine compounds at the site. This indicates that the source of the remaining dieldrin and endosulfan plumes is the former disposal pit area.

#### **2.1.4 Undiscovered Source Areas**

Site remedial investigation activities have included soil boring, monitoring well installation, grid sampling, historic research and interviews with former site personnel. None of these site investigation activities have revealed source areas, other than the former disposal pit, that would explain the groundwater detections. In addition, the groundwater detections to date are fully explained by contaminated soil residuals from the base and sidewalls of the former disposal pit. Finally, the fact that an active disposal pit was present at the site from 1952 until 1969 (providing a convenient method for disposal of chemicals and waste) makes it unlikely that alternate disposal areas would have been created.

#### **2.1.5 Discussion**

Groundwater contamination at the site is the result of residual soil contamination left in place after excavation and subsequent backfilling of the former disposal pit and other nearby areas. FMC and USEPA agreed to halt removal excavations at a depth of approximately 7 feet below grade where groundwater was encountered. Analytical results from post-excavation samples indicate soil concentrations of organochlorine compounds greater than ROD cleanup levels are present in soils beneath the bottom of the excavation. Residual soil contamination at the base of the excavation is in direct contact with groundwater during periods of average and seasonally high groundwater levels. Backfilling with cobbles increased the permeability of the soil above the residual soil contamination, and created a "bathtub" effect where locally higher groundwater levels occur. As a result, maximum concentrations of organochlorine compounds are typically detected in monitoring wells immediately downgradient from the disposal pit after the seasonal high water table occurs.

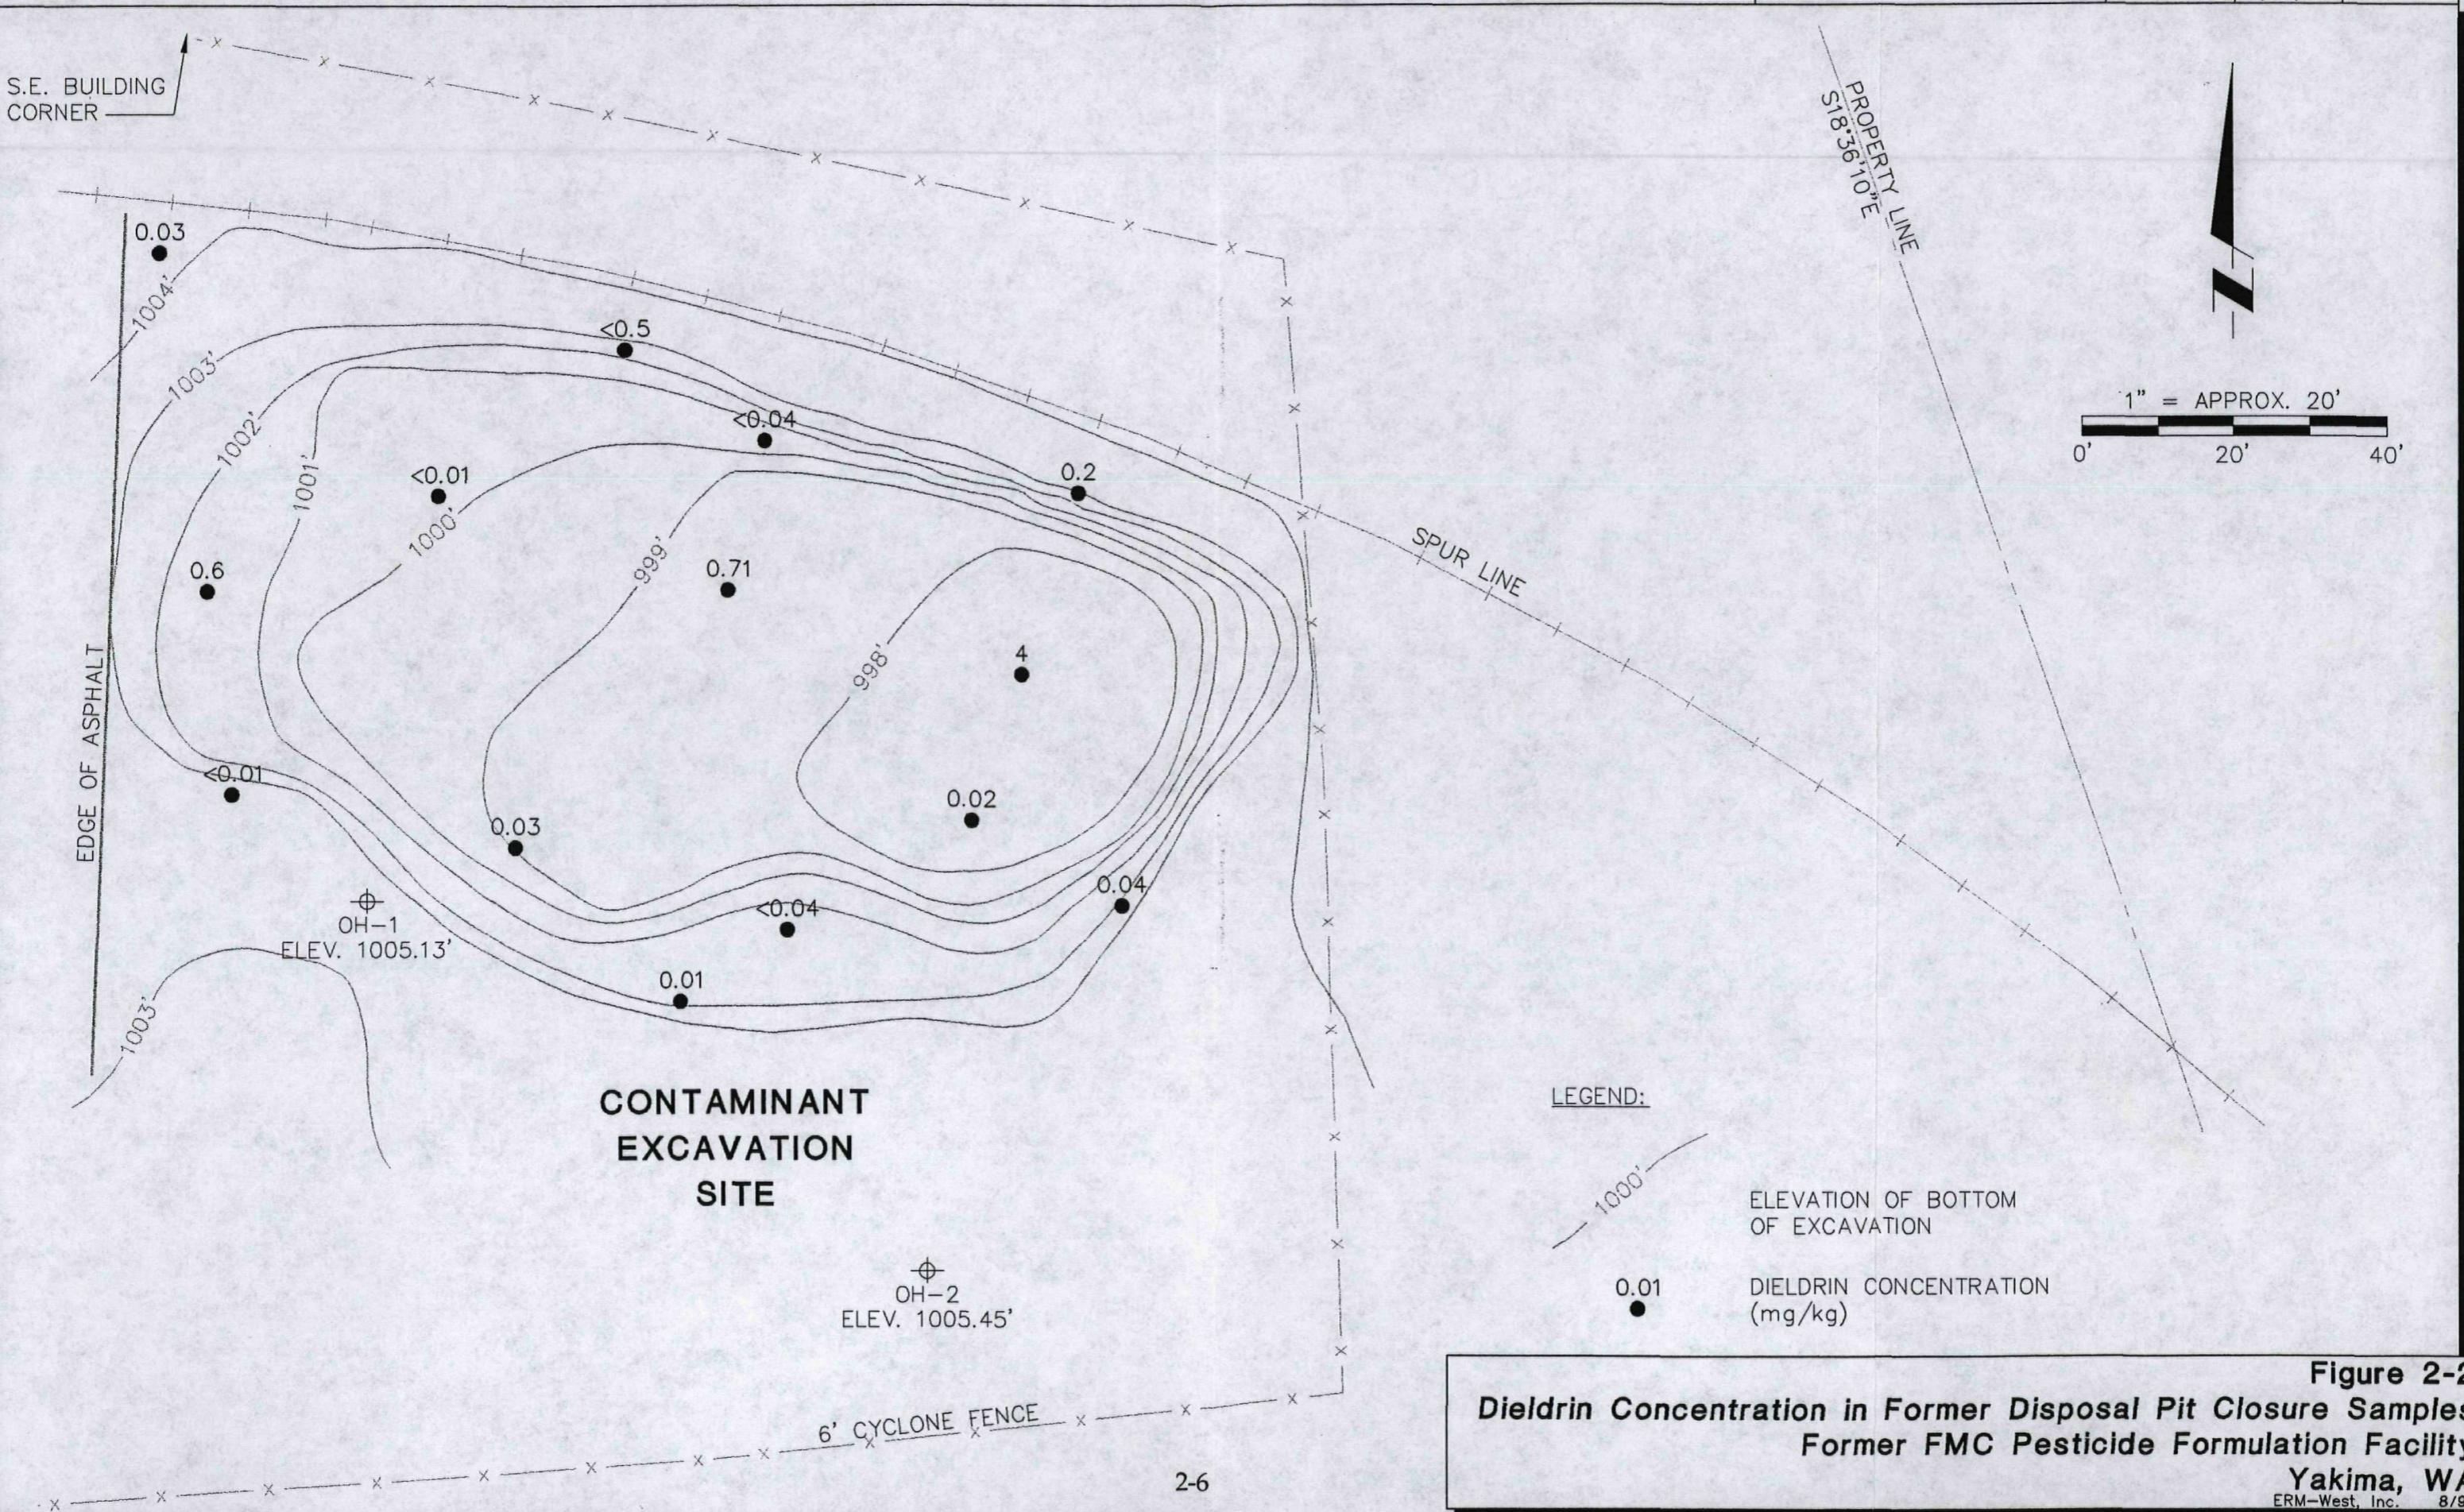

## **2.2 Compounds of Concern**

---

DDT and dieldrin are the remaining risked-based compounds of concern at the site. DDT has been detected infrequently (about once each year) in W-13/OH-1. Dieldrin has consistently been detected above the ROD trigger level of 0.05 µg/l at the monitoring well site W-13/OH-1, and infrequently detected at the other source well site W-14/OH-2. Concentrations over time are shown in Figure 2-3. The concentration curve presented on this figure is affected by the timing of sampling events. For example, the seasonal early fall high peak of dieldrin would presumably also appear in 1996 if the wells had been sampled in the early fall.

Aldrin has also been detected at concentrations above risk-based concentrations in W-13/OH-1. Aldrin was never used at the site, but is a product of the degradation of dieldrin. Aldrin and dieldrin are persistent, non-systemic organochlorine insecticides used for control of termites, locusts, and insect pests. Both dieldrin and aldrin bioaccumulate and are suspected carcinogens.

DDT is detected infrequently at monitoring well site W-13/OH-1 at concentrations below the ROD CR level of 0.2 µg/l. The concentration of DD-series compounds (DDT, DDE and DDD) over time is shown in Figure 2-4. In October, 1997, DDT was detected at 0.07 µg/l. Prior to that, DDT was detected in May 1996 at 0.06 µg/l. Other DD-series compounds were last detected at the site during the December 1995 sampling event.


The only other organochlorine compounds currently present in groundwater at the site are Endosulfans (Endosulfan I, Endosulfan II and Endosulfan Sulfate). Endosulfans in groundwater in the former disposal pit area have been and continue to be elevated since the removal action relative to concentrations present in groundwater prior to the removal action. This is especially true during the early fall when groundwater levels have been high (and presumably in contact with contaminated soils) for a prolonged period of time. Endosulfan concentrations, however, are significantly less than risk-based concentrations of concern. Concentration of endosulfans over time are shown in Figure 2-5. The concentration curve presented on this figure is affected by the timing of sampling events. For example, the seasonal early fall high peak of endosulfan would presumably also appear in 1996 if the wells had been sampled in the early fall.

Other chemicals of concern that have been detected in groundwater at the site include:


- Endrin-series compounds last detected in March, 1995;
- Dicofol, ovex, and perthane last detected in June, 1994.

**FIGURE 2-3**

*Concentration of Aldrin plus Dieldrin in Selected Wells*

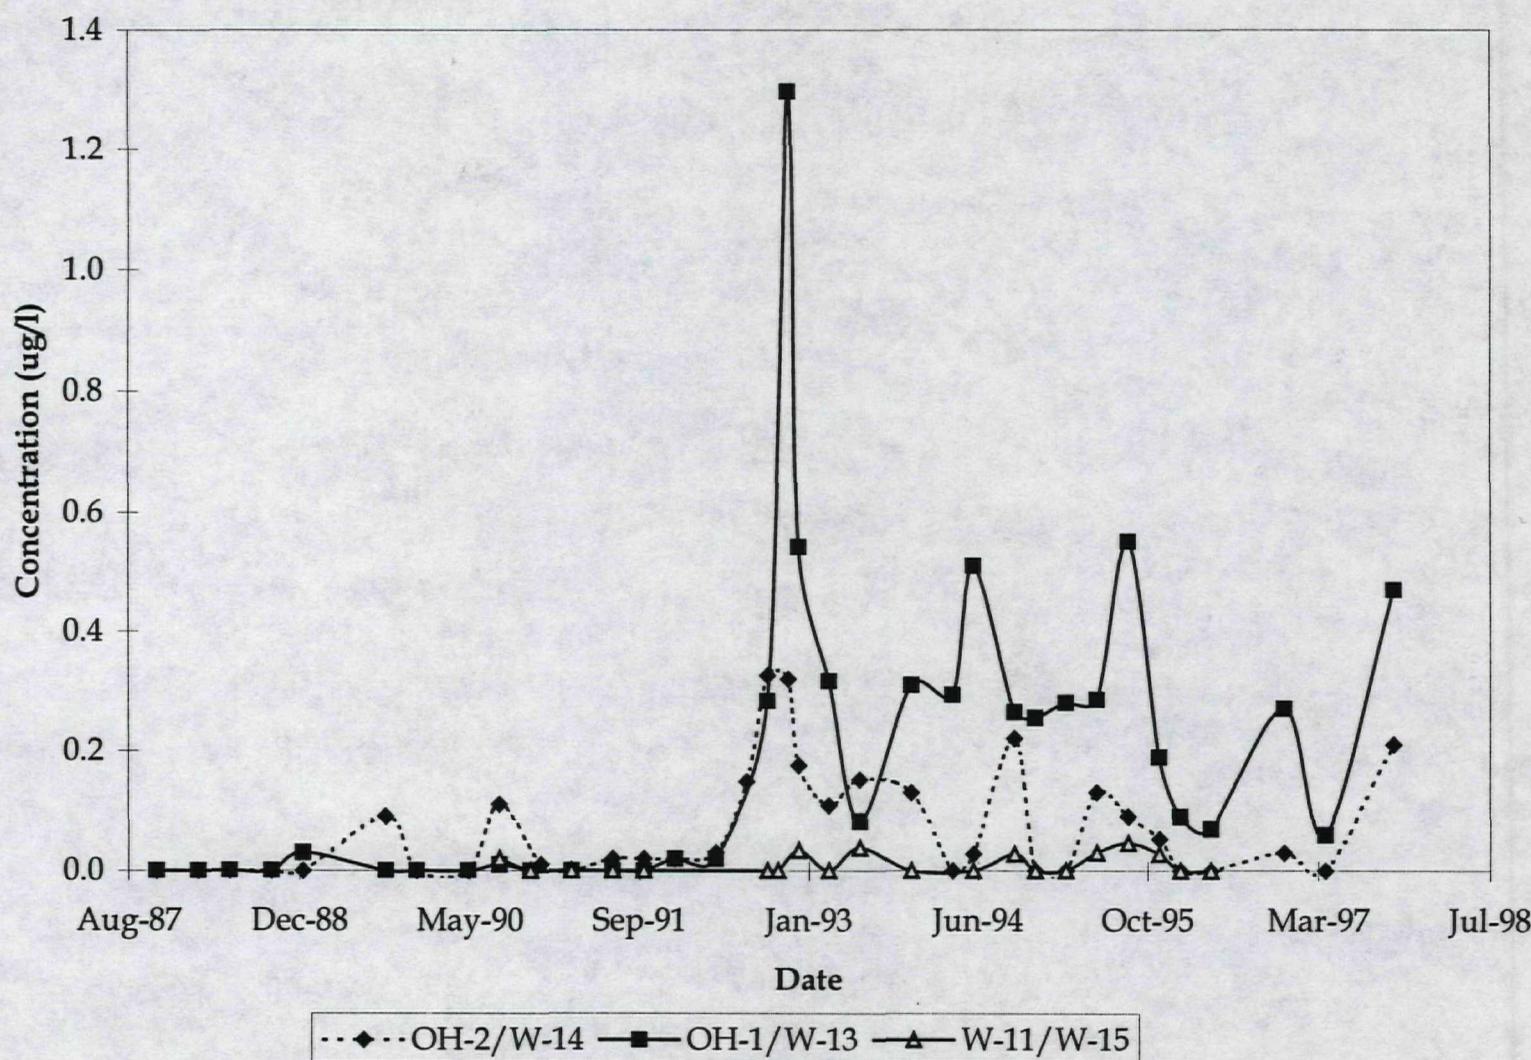


**FIGURE 2-4**  
*Concentration of DD-series in Selected Wells*

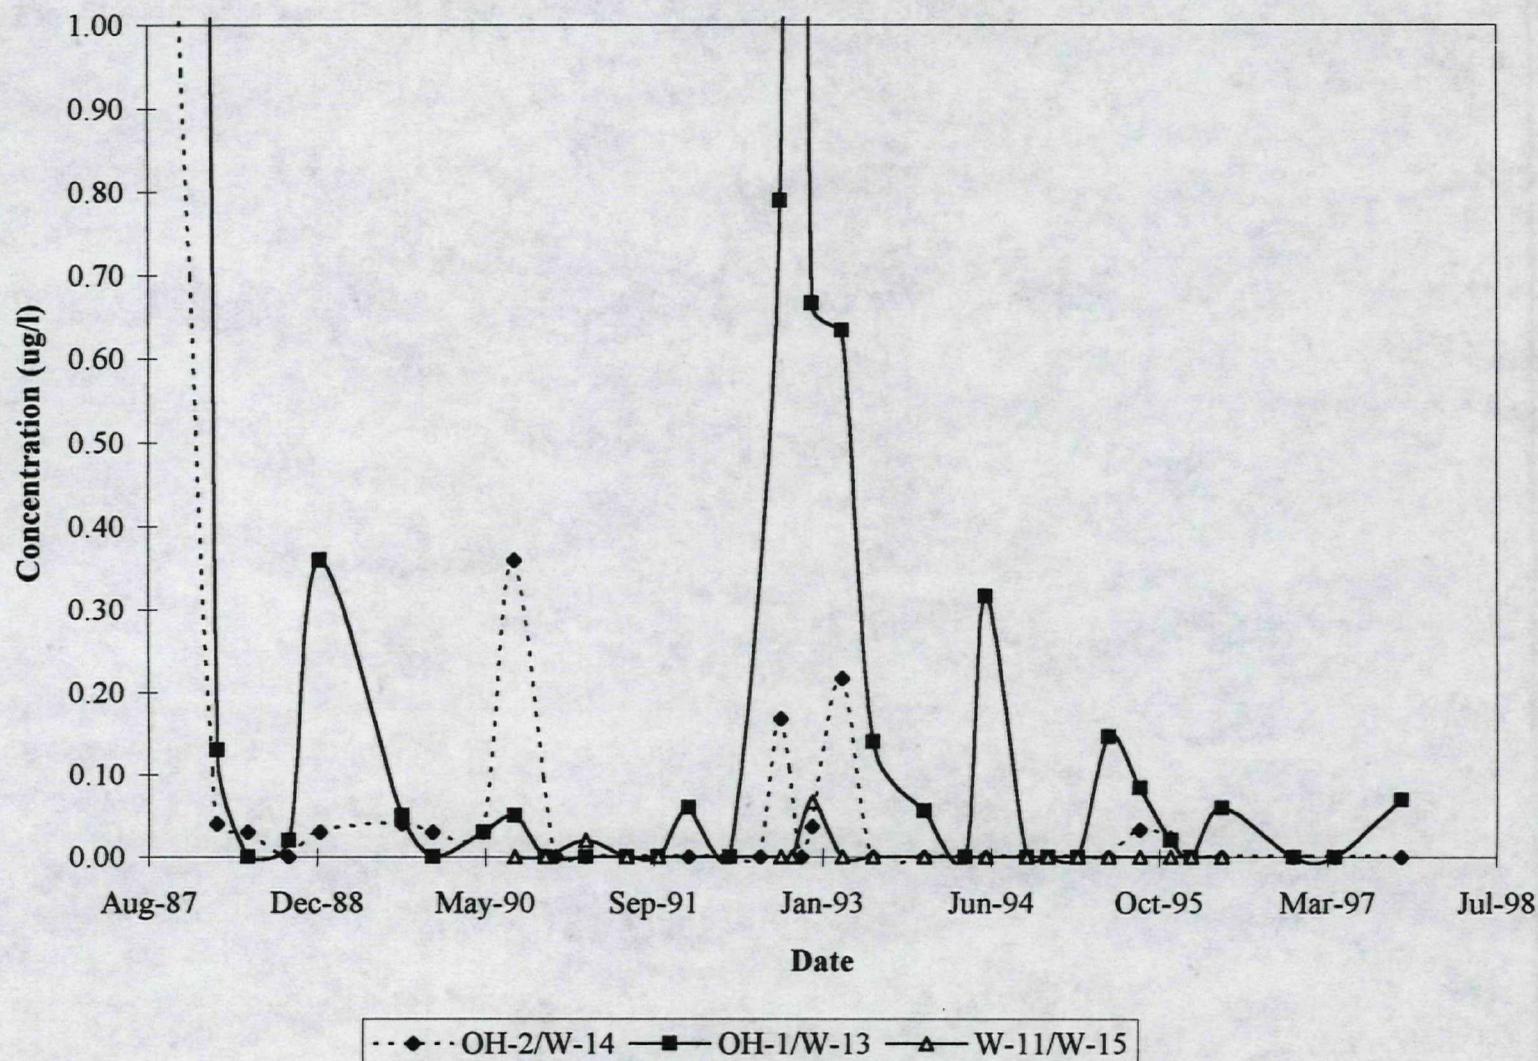

**FIGURE 2-5**

*Concentration of Total Endosulfans in Selected Wells*

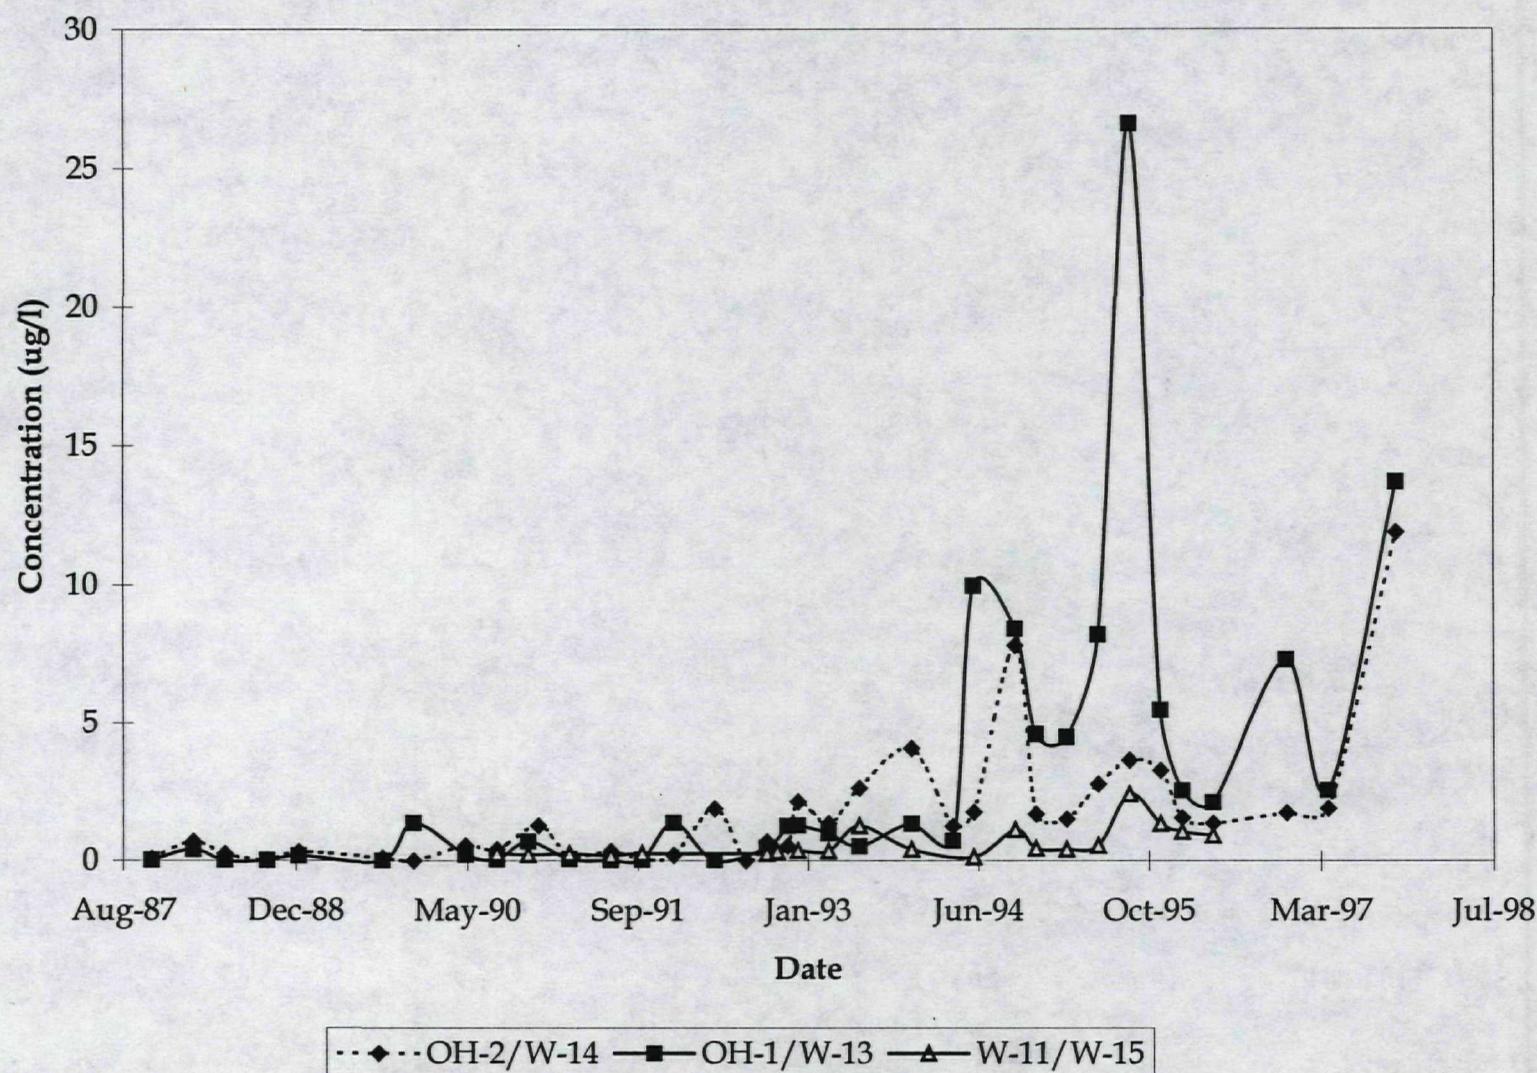

- 4,4-Methoxychlor last detected in April, 1994;
- Heptachlor epoxide last detected in July, 1993, and heptachlor last detected in April, 1993;
- Chlordane last detected in August, 1992; and,
- Toxaphene and captan last detected in March, 1991.

Since these compounds are no longer present in groundwater at the site, no further evaluations of these compounds are made. Remaining chemicals of concern at the site are dieldrin and DDT.

## **2.3 Extent in Groundwater**

---

Dieldrin, DD-series compounds, and total endosulfan detected in October 1997 are shown in Figure 2-6. The extent of organochlorine compounds has remained stable since the February 1996 sample event. Prior to that sampling event, the extent of dieldrin was larger as shown in Figure 2-7.

Dieldrin and DDT are detected only in the monitoring wells closest to the disposal pit area. The W-13 and W-14 locations are immediately downgradient of the disposal pit.

In well W-13, dieldrin has been consistently detected at concentrations ranging from 0.06 to 0.5 µg/l over the last few years. During the relatively higher groundwater elevation event that typically occurs in late summer and fall, dieldrin is detected in W-14. Dieldrin was detected after the removal action in several source wells at concentrations that exceeded concentrations detected prior to the removal action. During the most recent sampling event in October 1997, dieldrin was detected in W-13 at a concentration of 0.47 µg/l and at 0.21 µg/l in W-14.

WASHINGTON AVENUE

0' 40' 80'

LEGEND:	
ASPHALT	
DEMOLISHED STRUCTURE	
CYCLONE FENCE	
OW-13 2.56 D.08 0.37	L-DDT DIELDRIN AND ALDRIN ENDOSULFAN WELL NAME
ND = NOT DETECTED	
NQ = NOT QUANTIFIED	
EXTENT OF ENDOSULFAN	
EXTENT OF DIELDRIN	
EXTENT OF DOT	
CONCENTRATIONS IN $\mu\text{g/l}$	

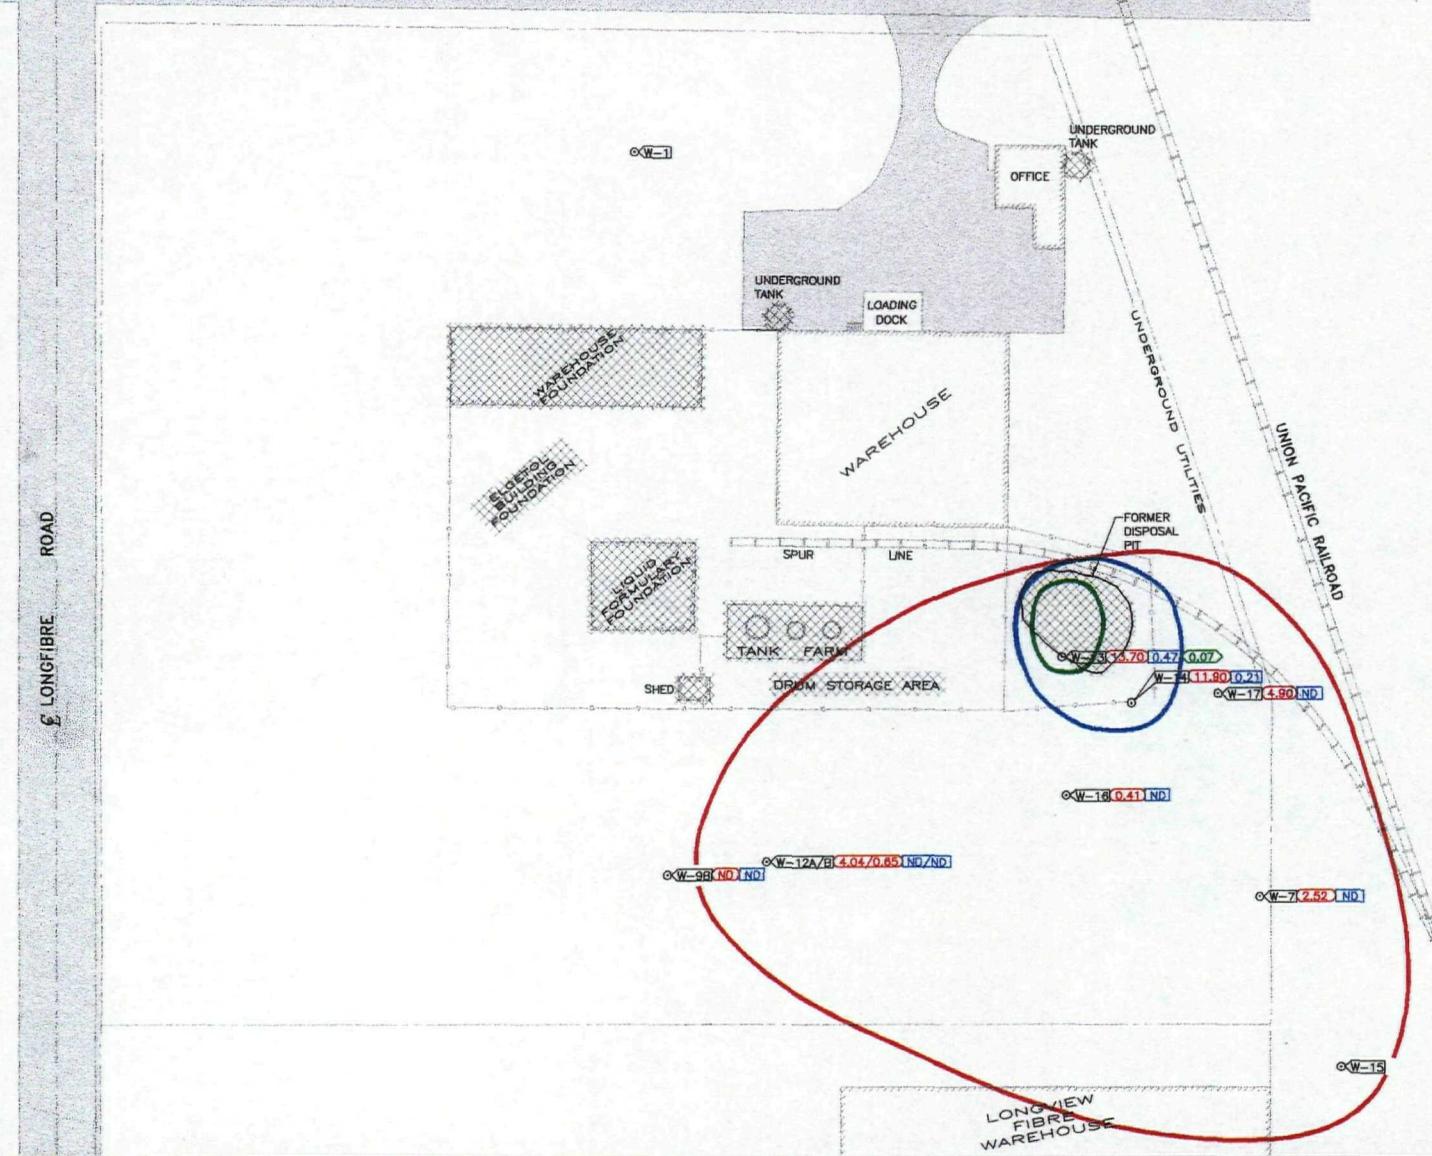


Figure 2-6  
Organochlorine Compounds in Groundwater, October 1997  
Former FMC Pesticide Formulation Facility

Yakima, WA  
ERM-West, Inc. 8/97

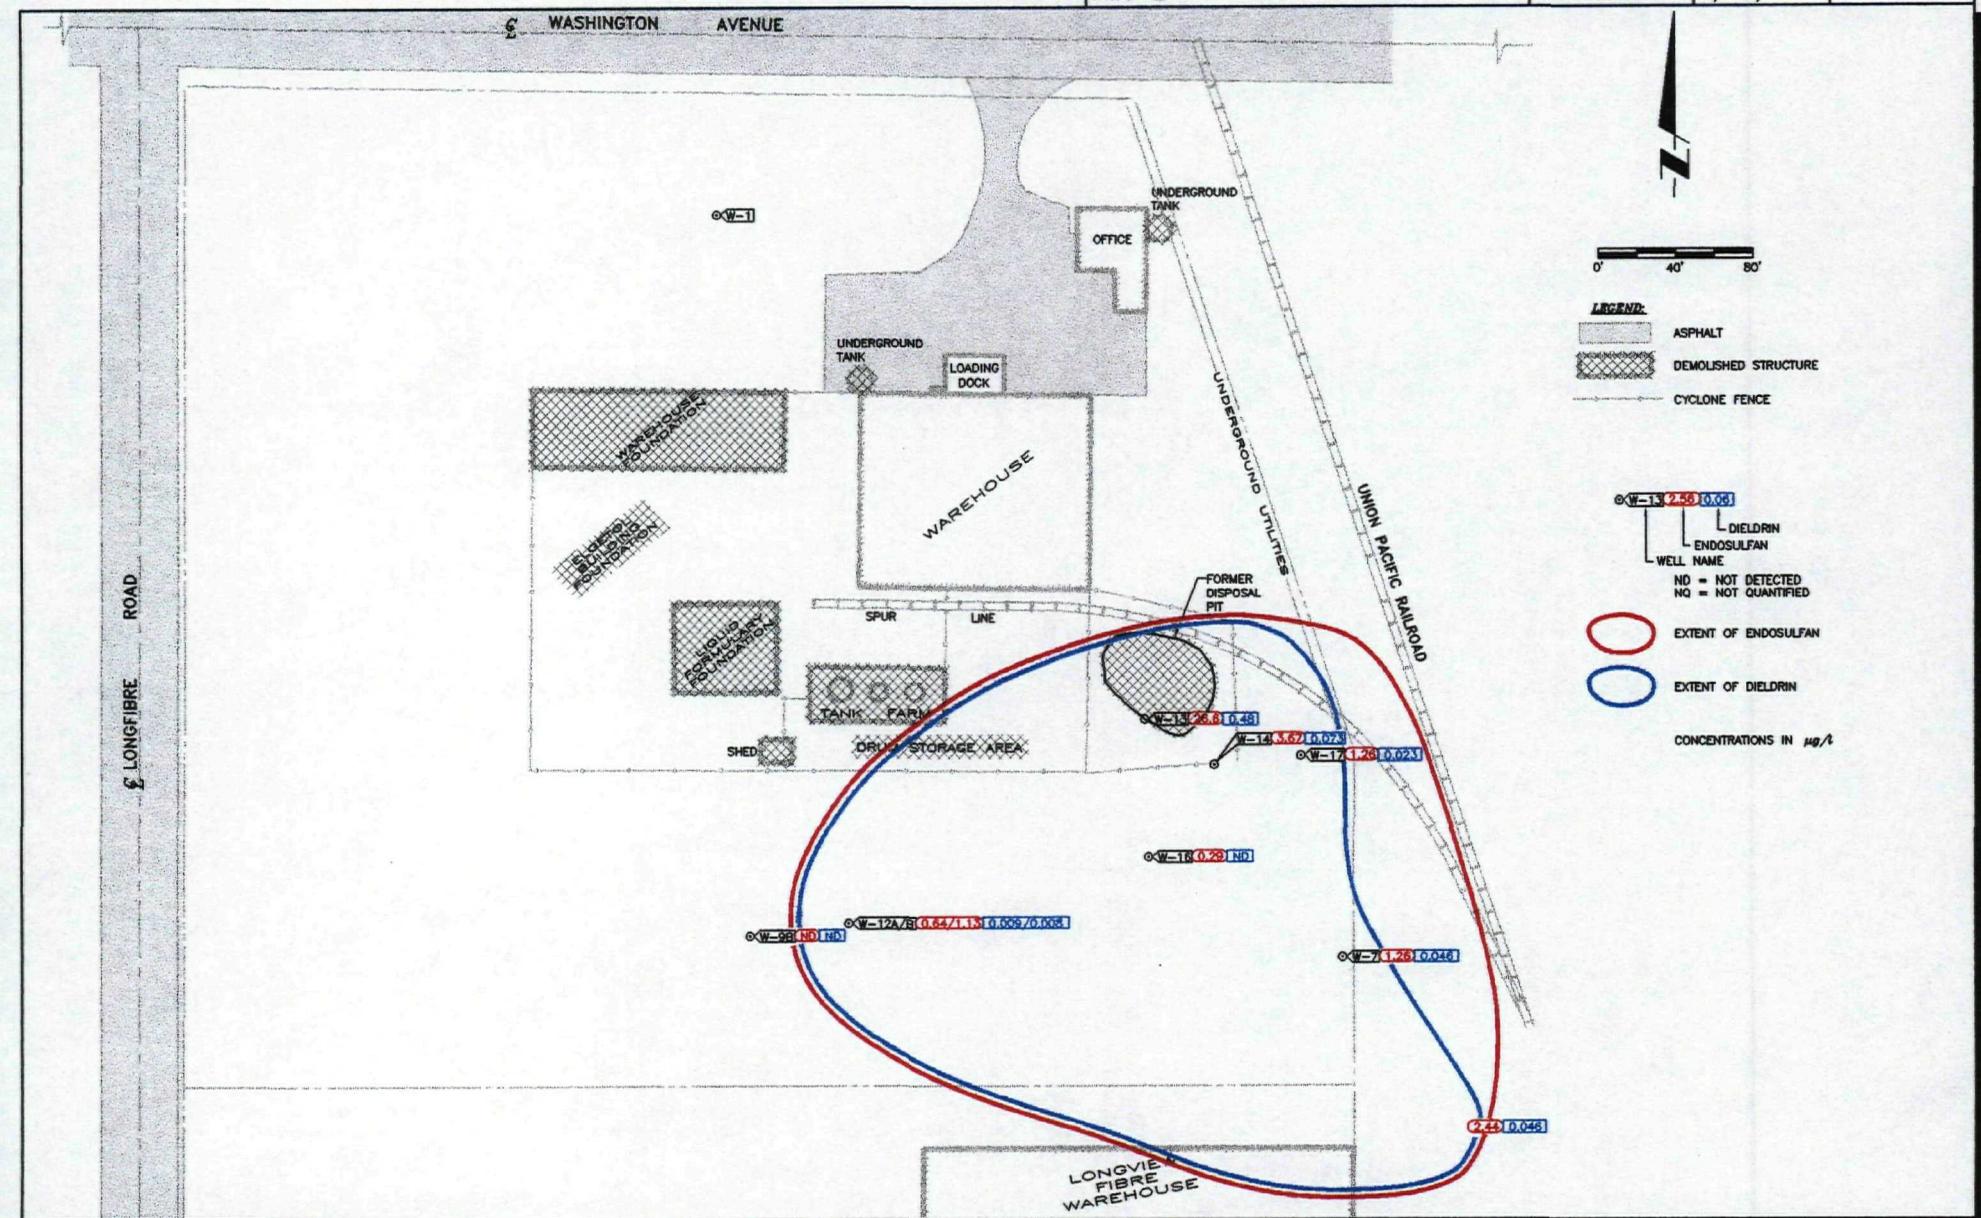


Figure 2-7

**Organochlorine Compounds in Groundwater, September 1995**  
**Former FMC Pesticide Formulation Facility**

**Yakima, WA**  
ERM-West, Inc. 8/97

## **SECTION 3.0**

---

### **FATE AND TRANSPORT**

#### **3.1 Transport to Groundwater**

---

The partitioning of organochlorine compounds from soil to water at the site is controlled by:

- the volume and concentration of contaminated soil exposed to water;
- the solubility of the compounds; and,
- the affinity of the compounds to soil.

##### **3.1.1 Solubility and Soil Affinity**

The solubility of a compound is an indicator of how much of that compound potentially can dissolve into water. The affinity for soils is an indicator of how persistent the compound will be within an aquifer. These processes compete at the site, and the resulting groundwater concentration reflects the equilibrium or effective solubility in groundwater. The solubilities and soil adsorption rate (from the log Koc values) for the compounds of interest are presented below:

<b><u>Compound</u></b>	<b><u>Solubility</u></b>	<b><u>log Koc Value</u></b>
dieldrin/aldrin	20 - 200 µg/l	4.08 - 4.69
DDT	3 µg/l	4.96 - 6.44
endosulfans	117 - 530 µg/l	3.31 - 3.36

Endosulfan compounds tend to be more soluble and have a lower affinity to soils than dieldrin and DDT. These values indicate that endosulfan is more mobile (i.e., less prone to be absorbed to soil particles) in groundwater compared with dieldrin. This is reflected at the site by the continued detection of endosulfans in downgradient monitor wells.

The Koc of dieldrin and DDT are so great that the continued detection in W-13 should not theoretically occur. One conceivable way that these compounds could still occur is if the solubility were enhanced by other organic chemicals. At the site, however, other volatile organic compounds (VOCs) analyzed from 1987

through 1990 were detected at concentrations much too low to facilitate dissolution of pesticides. VOC concentrations detected at the site are summarized in Table 3-1.

Another possible explanation for the continued persistence of dieldrin in groundwater is by colloidal-facilitated transport. This is further discussed in Section 3.1.4.

### **3.1.2 Source of Water**

The source of water contacting contaminated soil at the base of the former disposal pit is either infiltrating surface water or groundwater or both. To evaluate the source of water, climatological data from the Yakima airport were used to estimate the volume of surface water infiltration by water balance computation. The water balance portion of USEPA's Hydrogeologic Evaluation of Landfill Performance (HELP) Model 3.01 includes hydraulic properties for soil types that are similar to those at the site, and uses 5 years of local climate data measured at the Yakima airport. Information on surface topography and ground cover is entered to estimate water storage values and the percentage of surface water leaching to groundwater.

Water balance computations are included as Appendix C and summarized in Table 3-2. Results indicate that recharge from precipitation varies from a low of 0.008 inches per month in November and December to a maximum of 0.012 inches per month in January. Over the approximately one-quarter acre area of the former disposal pit the volume of infiltration from precipitation varies from 56 gallons per month to 84 gallons per month. The results indicate a negative total change in water storage (-3.7 %) for the former disposal pit area. A negative value for water storage indicates that evapotranspiration values are greater than infiltration values, and that infiltration of surface water to groundwater only occurs when snow melt or rainfall intensity is greater than evapotranspiration over a short period of time.

The large seasonal groundwater elevation fluctuations at the site are not explained by the relatively small variations in infiltration. When infiltration from precipitation is at a maximum (from January through May), groundwater elevation is at a minimum. The large seasonal groundwater elevation fluctuations, and the cause for groundwater elevations at the site above approximately 8 feet below grade, is recharge from crop irrigation. Enormous volumes of surface water from reservoirs and rivers are diverted through canals and applied by irrigation to barley and hops fields upgradient of the site. The irrigation season begins in late April or May and extends into September.

Soil contaminated by organochlorine compounds, therefore, is exposed to water at the base and sidewalls of the former disposal pit during the irrigation season. The

**TABLE 3-1**  
*VOC Concentrations in Groundwater*

Well	Date	Acetone			Tetrachloroethene			Toluene			Methylene Chloride			Carbon Disulfide			2-Butanone			2-Hexanone		
		Sample Result	Reporting Limit	Flag	Sample Result	Reporting Limit	Flag	Sample Result	Reporting Limit	Flag	Sample Result	Reporting Limit	Flag	Sample Result	Reporting Limit	Flag	Sample Result	Reporting Limit	Flag	Sample Result	Reporting Limit	Flag
W-1	Oct-83	24	10	B, J	4	5	J	10	5		7	5	B	ND	5		ND	5		ND	10	
W-2	Oct-83	17	10		ND	5		6	5		5	5	B	ND	5		ND	5		2	10	J
W-3	Oct-83	100	10		3	5	J	ND	5		6	5	B	ND	5		ND	5		ND	10	
W-4	Oct-83	3900	10		ND	100		ND	100		160	5	B	ND	5		ND	5		ND	10	
W-5	Oct-83	130	10	B	4	5	J	4	5	J	7	5	B	ND	5		ND	5		ND	10	
W-6	Oct-83	16000	10		ND	500		ND	500		820	5	B	ND	5		ND	5		ND	10	
OH-1	Oct-83	24	10	B	4	5	J	10	5		7	5	B	ND	5		ND	5		ND	10	
OH-2	Oct-83	1200	10	B	ND	5		ND	5		85	5	B	ND	5		ND	5		ND	10	
OH-3	Oct-83	1500	10	B	ND	50		ND	50		86	5	B	ND	5		ND	5		ND	10	
W-1	May-84	ND	10		ND	5		ND	5		ND	5		ND	5		ND	5		ND	10	
W-2	May-84	ND	10		ND	5		ND	5		ND	5		ND	5		ND	5		ND	10	
W-3	May-84	ND	10		ND	5		ND	5		ND	5		ND	5		ND	5		ND	10	
W-4	May-84	ND	10		ND	5		ND	5		ND	5		ND	5		ND	5		ND	10	
W-5	May-84	ND	10		ND	5		ND	5		ND	5		ND	5		ND	5		ND	10	
W-6	May-84	ND	10		ND	5		ND	5		ND	5		ND	5		ND	5		ND	10	
OH-1	May-84	ND	10		ND	5		ND	5		ND	5		ND	5		ND	5		ND	10	
OH-2	May-84	ND	10		ND	5		ND	5		ND	5		ND	5		ND	5		ND	10	
OH-3	May-84	ND	10		ND	5		ND	5		J	5	J, B	ND	5		ND	5		ND	10	
W-1	Sep-84	14	10	B	3	5	B, J	ND	5		ND	5		ND	5		1	5	B, J	ND	10	
W-2	Sep-84	5	10	B, J	3	5	J	ND	5		ND	5		ND	5		ND	5		ND	10	
W-3	Sep-84	6	10	B, J	ND	2		ND	5		ND	5		ND	5		ND	5		1	10	B, J
W-4	Sep-84	7	10	B, J	ND	5		ND	5		ND	5		ND	5		ND	5		ND	10	
W-5	Sep-84	12	10	B	3	5	J	ND	5		ND	5		ND	5		ND	5		ND	10	
W-6	Sep-84	6	10	B, J	2	5	J	ND	5		ND	5		ND	5		3	5	B, J	ND	10	
OH-1	Sep-84	10	10	B	3	5	J	ND	5		ND	5		ND	5		2	5	B, J	ND	10	
OH-2	Sep-84	ND	10		3	5	J	ND	5		ND	5		ND	5		4	5	B, J	2	10	J
OH-3	Sep-84	8	10	B, J	3	5	J	ND	5		ND	5		ND	5		3	5	B, J	ND	10	
W-1	Aug-85	18	10	B	3	5	J	ND	5		ND	5		ND	5		ND	5		ND	10	
W-2	Aug-85	30	10	B	5	5		2	5	J	ND	5		4	5	J	ND	5		ND	10	
W-3	Aug-85	11	10	B	4	5	J	ND	5		ND	5		ND	5		ND	5		ND	10	
W-4	Aug-85	29	10	B	4	5	J	ND	5		ND	5		8	5		ND	5		ND	10	
W-5	Aug-85	16	10	B	3	5	J	ND	5		ND	5		3	5	J	ND	5		ND	10	
W-6	Aug-85	5	10	B, J	4	5	J	ND	5		ND	5		2	5	J	ND	5		ND	10	
W-7	Aug-85	9	10	B, J	5	5		ND	5		ND	5		ND	5		ND	5		ND	10	
OH-1	Aug-85	5	10	J	5	5		ND	5		ND	5		ND	5		ND	5		ND	10	
OH-2	Aug-85	16	10		4	5	J	ND	5		ND	5		25	5		ND	5		ND	10	
OH-3	Aug-85	12	10		4	5	J	ND	5		ND	5		ND	5		ND	5		ND	10	
W-1	Nov-85	ND	10		3	5	J	ND	5		ND	5		4	5	J	ND	5		ND	10	
W-2	Nov-85	ND	10		3	5	J	ND	5		ND	5		ND	5		ND	5		ND	10	
W-3	Nov-85	ND	10		3	5	J	ND	5		ND	5		ND	5		ND	5		ND	10	
W-4	Nov-85	ND	10		3	5	J	ND	5		ND	5		ND	5		ND	5		ND	10	
W-5	Nov-85	ND	10		2	5	J	1	5	J	ND	5		ND	5		ND	5		ND	10	
W-6	Nov-85	ND	10		2	5	J	ND	5		ND	5		ND	5		ND	5		ND	10	
W-7	Nov-85	ND	10		2	5	J	ND	5		ND	5		ND	5		ND	5		ND	10	
OH-1	Nov-85	1	10	B, J	3	5	J	ND	5		ND	5		ND	5		ND	5		ND	10	
OH-2	Nov-85	9	10	B, J	2	5	J	6	5		ND	5		ND	5		2	5	B, J	ND	10	
OH-3	Nov-85	ND	10		2	5	J	1	5	J	ND	5		ND	5		ND	5		ND	10	
W-1	Apr-86	3	10	J	3	5	J	ND	5		ND	5		ND	5		ND	5		ND	10	
W-2	Apr-86	ND	10		2	5	J	ND	5		ND	5		ND	5		ND	5		ND	10	
W-3	Apr-86	6	10	J	2	5	J	ND	5		ND	5		ND	5		ND	5		ND	10	
W-4	Apr-86	ND	10		3	5	J	ND	5		ND	5		ND	5		ND	5		ND	10	
W-5	Apr-86	ND	10		3	5	J	ND	5		ND	5		ND	5		ND	5		ND	10	
W-6	Apr-86	ND	10		3	5	J	ND	5		ND	5		ND	5		ND	5		ND	10	
W-7	Apr-86	ND	10		2	5	J	ND	5		ND	5		ND	5		ND	5		ND	10	
OH-1	Apr-86	ND	10		3	5	J	ND	5		ND	5		ND	5		ND	5		ND	10	
OH-2	Apr-86	ND	10		2	5	J	ND	5		ND	5		69	5		ND	5		ND	10	
OH-3	Apr-86	ND	10		3	5	J	ND	5		ND	5		ND	5		ND	5		ND	10	
W-9B	May-86	ND	10		1	5	J	ND	5		ND	5		ND	5		ND	5		ND	10	
W-10	May-86	7	10	J	2	5	J	ND	5		ND	5		ND	5		ND	5		ND	10	

Notes:

Units are ug/L.

ND = Non detect

B = Analyte found in blank

J = Concentration below detection limit, value is an estimate

**TABLE 3-2***Summary of Water Balance Computations*

AVERAGE MONTHLY VALUES IN INCHES FOR YEARS 1974 THROUGH 1978

	JAN	FEB	MAR	APR	MAY	JUN	JUL	AUG	SEP	OCT	NOV	DEC
PRECIPITATION	1.38	0.89	0.71	0.62	0.41	0.37	0.18	0.83	0.34	0.3	0.44	0.98
RUNOFF (0.5% SLOPE)	0.568	0.224	0.005	0.005	0	0	0	0.015	0	0	0	0.337
EVAPOTRANSPIRATION	0.467	0.656	1.318	0.727	0.553	0.36	0.263	0.622	0.481	0.217	0.352	0.417
PERCOLATION TO GROUNDWATER	0.0116	0.0101	0.0108	0.0101	0.01	0.0094	0.0095	0.0093	0.0087	0.0083	0.0083	0.0084

base of the disposal pit ranges from 998 to 1001 feet amsl. Water level elevation in W-13, which is adjacent to the former disposal pit, is above 999 ft amsl during the irrigation season. Groundwater elevations during the fall sampling have been measured at elevations of 1,002 ft amsl.

### **3.1.3 Advection Groundwater Transport**

Advection groundwater transport refers to the transport of contaminants along the groundwater flow path associated with the physical movement of dissolved compounds in groundwater. The rate of advective groundwater transport, therefore, is the rate of groundwater flow. For the organochlorine compounds considered herein, the advective transport rate is effected by other processes such as adsorption and degradation.

Fluctuations in endosulfan concentrations are directly related to seasonal fluctuations in groundwater levels as seen in Figure 3-1. The concentration curve presented on this figure is affected by the timing of sampling events. For example, the seasonal early fall high peak of endosulfan would presumably also appear in 1996 if the wells had been sampled in the early fall. The dissolved constituents are transported by advective groundwater flow until sufficient time and adsorption capacity is available for clay and organic particles in the formation to remove the dissolved constituents from solution. Advective groundwater flow velocity at the site is estimated to be 7 ft/day as discussed in Section 1.5.

The maximum estimated distance endosulfan travels along the groundwater flow path (from Figure 2-6) is 270 feet. Groundwater takes approximately 40 days to flow 270 feet. Within that time, therefore, dilution and adsorption effectively reduce endosulfan concentrations to less than analytical detection levels.


Seasonal groundwater fluctuations also correspond to deviations in dieldrin plus aldrin concentrations. Concentrations are shown in Figure 3-2. The concentration curve presented on this figure is affected by the timing of sampling events. For example, the seasonal early fall high peak of dieldrin would presumably also appear in 1996 if the wells had been sampled in the early fall. These compounds are not detected in other monitoring wells frequently enough to make meaningful correlations.

### **3.1.4 Colloidal Particle Transport**

Given the relative insolubility and high affinity to soils of dieldrin and DDT it is possible that the continued detection of dieldrin and aldrin in W-13 is due to dieldrin bonded to colloidal particles suspended in groundwater. In October 1997, a filtered sample of groundwater was collected from W-13 along with an unfiltered sample. Results are compared in Table 3-3. Results indicate that


**FIGURE 3-1**

*Endosulfan Concentration versus Water Level in W-13*

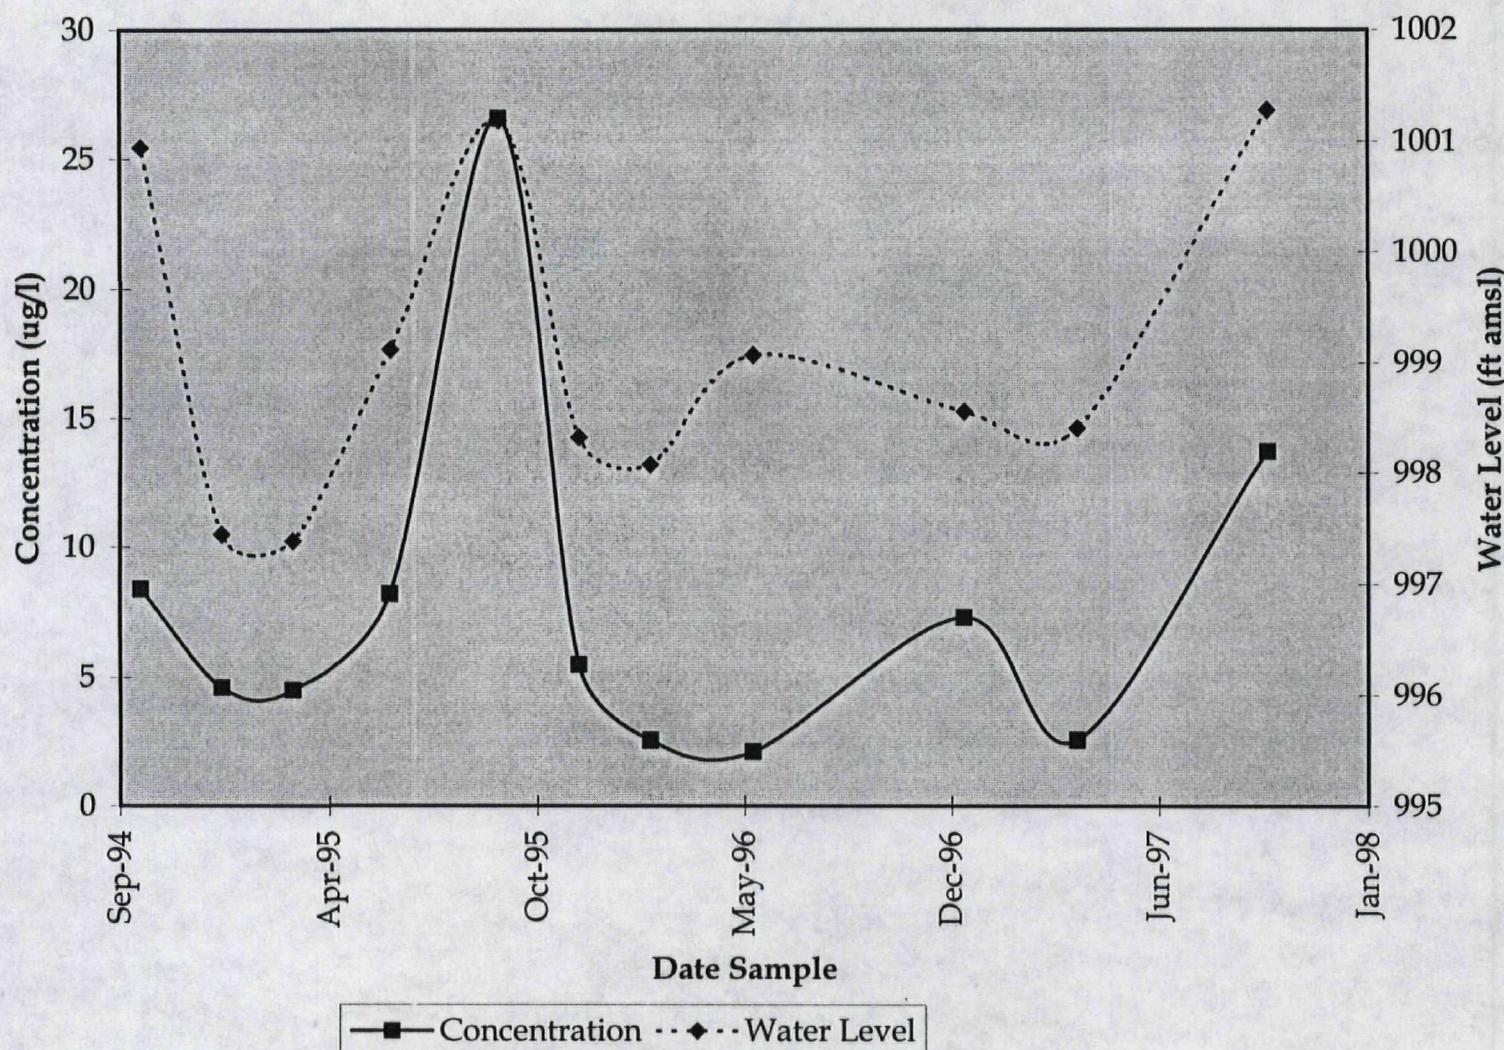

**FIGURE 3-2**

*Dieldrin plus Aldrin Concentration versus Water Level in W-13*

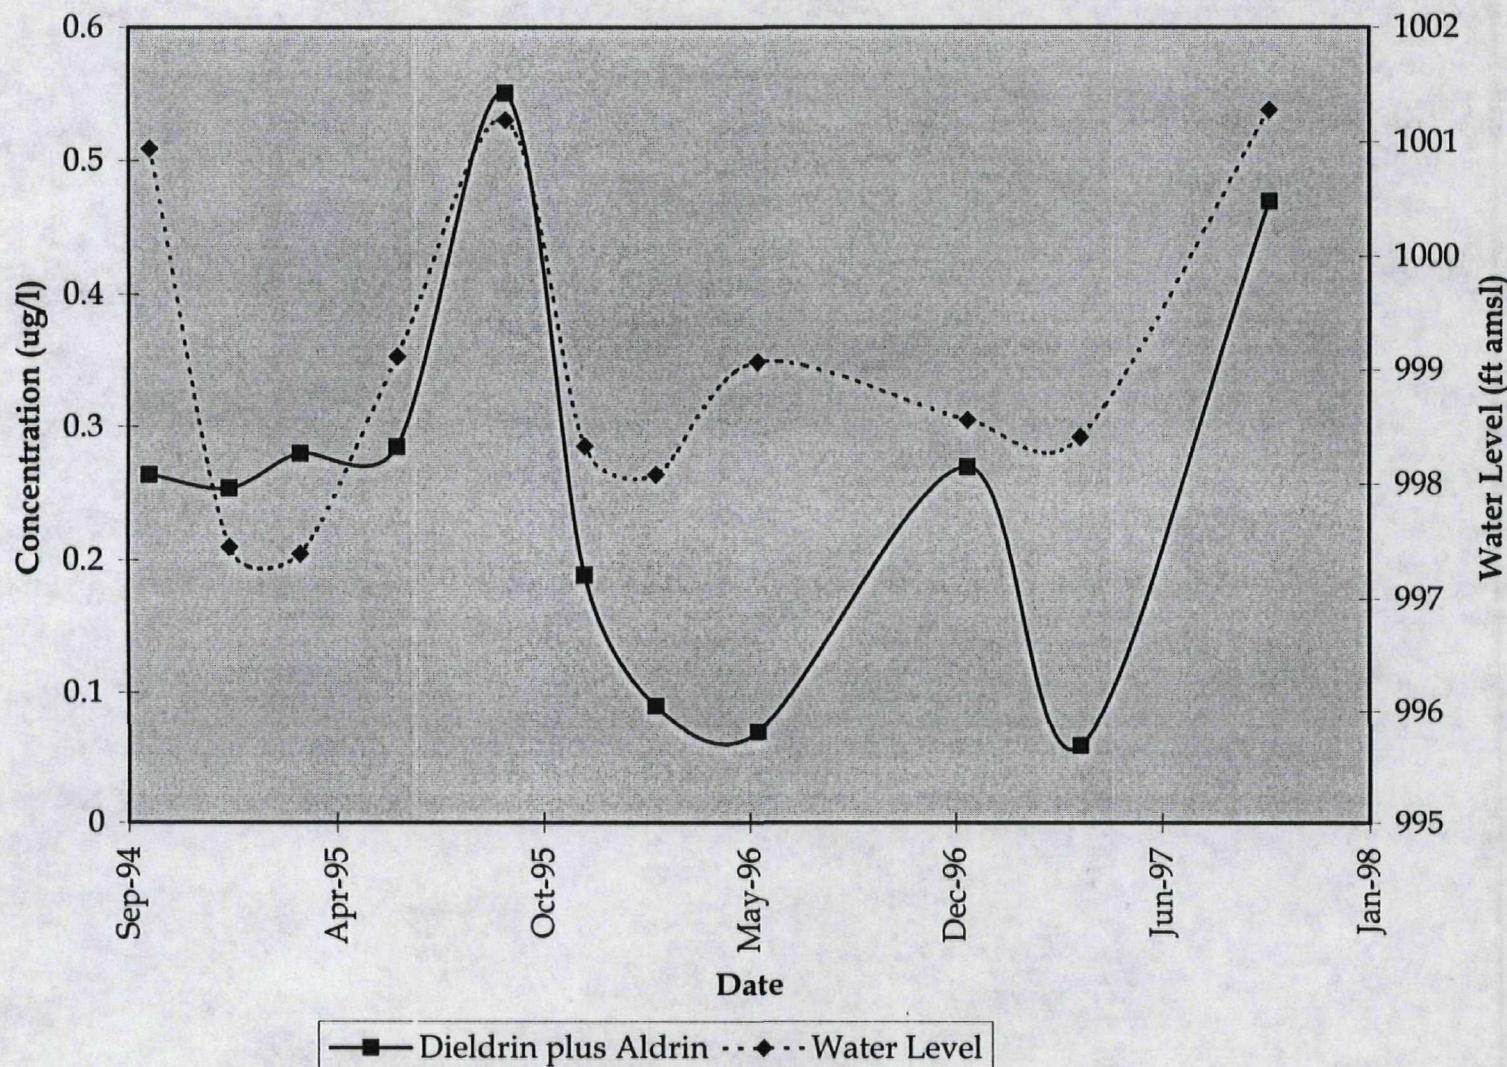

dieldrin and DDT exist on colloidal particles. The filter size was 0.45 microns; therefore, the dieldrin that was detected in the filtered sample is either in solution or absorbed to colloidal particles that are smaller than 0.45 microns.

The difference in concentration between filtered and unfiltered samples is a reflection of the portion of the organochlorine compound absorbed to colloidal particles. Colloidal particles consist of clay sediments and organic materials in the 0.003 to 200 micron range. The use of a 0.45 micron filter removes a significant portion of the colloidal particles from the sample. The resulting filtered sample only contains the dissolved portion of compound plus the portion absorbed to colloidal particles that are smaller than 0.45 microns.

The transport of colloidal particles along the groundwater flow pathway is limited. The ability of colloidal particles to migrate along the groundwater flow path is impeded by the variety of pore sizes and the tortuous flow path a particle must take through the formation at the site. The alluvium aquifer at the site consists of highly angular particles, and the resulting pore space distribution limits the distance a colloidal or clay particle can travel before becoming trapped or wedged within a pore space.

Historically, the concentration of dieldrin has been less than 0.05 µg/l except in monitoring wells that are immediately downgradient (i.e., source wells) of the former disposal pit. Historical detections of dieldrin in downgradient wells W-7, W-12 and W-15 may reflect dissolved dieldrin concentrations in groundwater, and the greater concentrations detected in source wells may reflect dieldrin absorbed onto colloidal particles. Since the maximum concentration detected in the downgradient wells is 0.05 µg/l, the equilibrium solubility of dissolved dieldrin in groundwater may be 0.05 µg/l.

Once a colloidal particle encounters a pore space that impedes further travel, that particle is effectively removed from the groundwater flow path. In many cases a filter is built up within a pore space or against an aperture; larger particles are lodged against each other and the pore space opening, and smaller particles are stacked up behind the large particles. An extraordinary hydraulic stress would be required to dislodge the larger particles and allow further migration of the small particles. Such a hydraulic stress could be from an abrupt increase or decrease in groundwater elevation, or a reversal in groundwater flow from a locally large recharge event. Over a period of time, therefore, migration of colloidal particles can occur in short steps following hydraulic stresses.

The potential for dieldrin and DDT to exist on colloidal particles makes low volume low-stress sampling techniques essential for this groundwater monitoring program. Low-stress sampling techniques have been used for the groundwater monitoring program since the September 1995 sampling event.

**TABLE 3-3***Comparison of Filtered and Unfiltered Sample Concentrations in the W-13 October 1997 Sample*

Parameter	Unfiltered Concentration ( $\mu\text{g/l}$ )	Filtered Concentration ( $\mu\text{g/l}$ )	Relative Standard Deviation (%)	PQL ( $\mu\text{g/l}$ )
Endosulfan I	6.8	5.5	11	0.05
Endosulfan II	3.7	2.8	14	0.05
Endosulfan Sulfate	3.2	2.8	7	0.05
Dieldrin	0.47	0.29	24	0.05
DDT	0.07	< 0.05	--	0.05

### **3.2 Fate in Groundwater**

---

The persistence of the organochlorine compounds in groundwater is limited. Limiting factors, in order of importance, are soil adsorption, biodegradation and hydrolysis. Soil adsorption, which also limits transport to groundwater, is discussed in Section 3.1.1.

Organochlorine compounds in soil and groundwater are broken down by a variety of degradation mechanisms including oxidation and aerobic microbial metabolism. In groundwater at the site, dieldrin follows two degradation pathways: biodegradation; and, hydrolysis.

The presence of aldrin provides evidence of a biodegradation reaction at the site. Aldrin was never used or stored at the site. Aldrin occurs as a breakdown product of dieldrin by *Pseudomonas Sp.* Microorganism. Aldrin is then readily oxidized to reform dieldrin. A cyclic pattern is followed, changing dieldrin to aldrin to dieldrin (Montgomery, 1993).

The dieldrin-aldrin-dieldrin cycle is shown in Figure 3-3. In June 1995, aldrin makes up approximately 30% of the dieldrin and aldrin found in W-4. This is a result of microbial degradation of aldrin in the source zone. In September 1995, during a high water table elevation dieldrin enters the groundwater but is not yet metabolized to aldrin and the ratio decreases. In December 1995, as dieldrin is metabolized to aldrin, the aldrin ratios once again rise. Dieldrin and aldrin ratios have followed this same cycle since March 1993.

Dieldrin does not readily metabolize to aldrin outside of the source area. This is because of the absence of acclimated microorganisms downgradient. In the source zone, dieldrin is in relatively higher concentrations, and so microorganisms are acclimated to dieldrin and are able to utilize dieldrin for metabolism. The reaction of aldrin to dieldrin is estimated at a half life of 53 days. The biodegradation of dieldrin outside the source zone is much slower, with a half life estimated between 175 days to 3 years.

Hydrolysis is the direct reaction of the dissolved compound with water molecules. Hydrolysis degradation rates are typically difficult to measure due to competing reactions and slow degradation rates. Dieldrin degrades by hydrolysis with an approximate half-life of 10.5 years. Aldrin degrades by hydrolysis with a half-life of 760 days (Montgomery, 1993).

WASHINGTON AVENUE

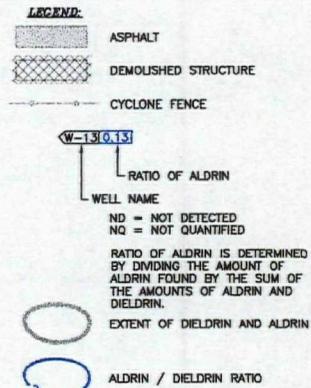
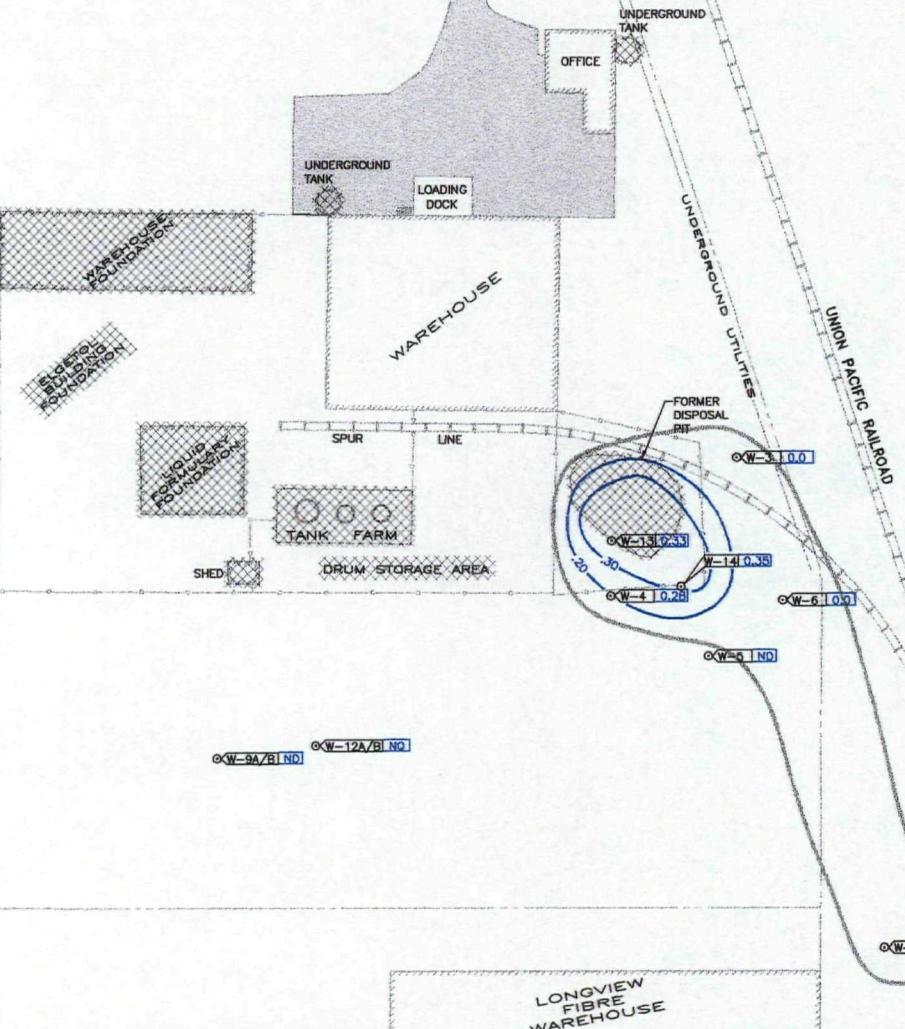


Figure 3-3  
June, 1995 Ratio of Aldrin to Dieldrin in Groundwater  
Former FMC Pesticide Formulation Facility

Yakima, WA  
ERM-West, Inc. 8/97

Endosulfan I and endosulfan II are both metabolized by *Pseudomonads* and other microorganisms to yield endosulfan sulfate. A variety of other metabolites are also produced such as endosulfandiol, endosulfan ether, and endosulfan lactone.

The estimated half life ranges between 2 days and 56 days for aqueous biodegradation. Hydrolysis of endosulfan I and II yields endosulfan sulfate with a reported half life of 9 days. Endosulfan sulfate is further metabolized by a variety of organisms, but the chlorinated endosulfan backbone persists in all known metabolites.

## **SECTION 4.0**

---

### ***RISK ASSESSMENT***

As part of the RI for the site, a risk assessment was completed. Both human health and environmental receptors were evaluated. Conclusions are presented in the Phase II RI Report (Bechtel, 1990).

The receptor survey has been updated for this five-year review. The air pathway is no longer active since the removal actions. Surface water pathways also are no longer of concern because of the removal of surface soil contamination.

Water well records were obtained from the Washington State Department of Ecology and reviewed for wells located within a one-mile radius of the site. As also indicated in the previous 1990 survey, the record search indicates that no receptors from a groundwater pathway are located downgradient from the subject site (Figure 4-1).

Groundwater on the FMC site and immediate vicinity is not currently used for domestic, industrial, or agricultural purposes. Monitoring wells associated with the site are locked to prevent access by unauthorized personnel.

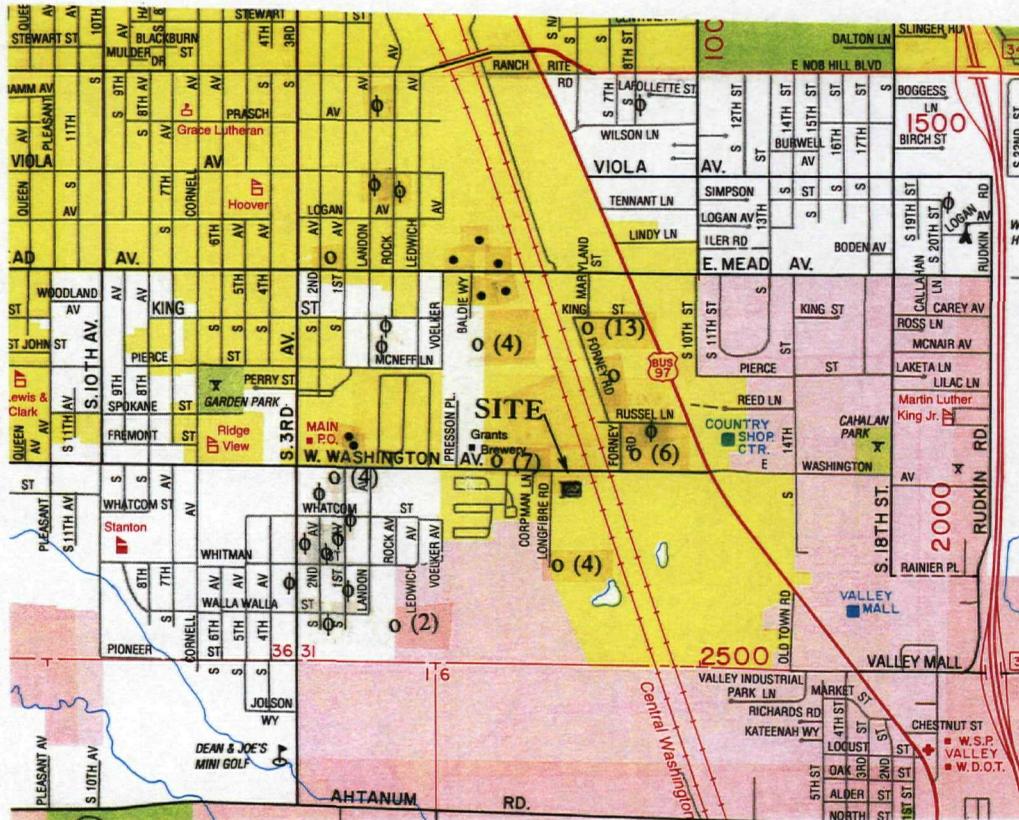


Figure 4-1  
Water Well Survey Locations  
Former FMC Pesticide Formulation Facility  
Yakima, WA  
ERM-West, Inc. 11/97

## **SECTION 5.0**

---

### ***DATA EVALUATION***

It is apparent from observations of the time-series graphs (Figures 2-3 through 2-5 and Figures 3-1 and 3-2) that for the source area wells:

- concentrations increased immediately after the excavation of the disposal pit and removal actions;
- some type of seasonal fluctuation effects concentration; and,
- based on the observed endosulfan concentrations, seasonal fluctuations are probably based on groundwater fluctuations.

Since the removal action concentrations of dieldrin have equilibrated, within the range explained by seasonal fluctuations, to concentrations that are greater than concentrations measured in groundwater before the removal action. Except for anomalous values measured in September 1995, which are attributed to well installation interference, concentrations have been between the detection level of 0.05 and 0.6 µg/l. Endosulfan concentrations were increasing until last year, when they appeared to stabilize. Future monitoring will be needed to determine whether endosulfan concentrations have equilibrated.

## **SECTION 6.0**

---

### ***CONCLUSIONS***

The five-year FMC Yakima groundwater monitoring program has shown that residual pesticide contamination continues to be detected in site groundwater. Groundwater contamination associated with the former FMC Yakima site, however, does not currently pose a threat to human health or the environment.

The major source of the organochlorine compounds is the former disposal pit area. There may be other minor sources from former process areas. During the fall, when groundwater is in direct contact with soil containing residual concentrations of pesticides, endosulfan and dieldrin are dissolved and transported by advective groundwater flow. Residual soil contamination at the base of the former disposal pit excavation is in direct contact with groundwater during periods of average and seasonally high groundwater levels. As a result, maximum concentrations of organochlorine compounds are typically detected in monitoring wells immediately downgradient from the disposal pit after the seasonal high water table occurs. In addition, colloidal particles containing endosulfan, dieldrin and DDT may be transported to source wells.

Another potential source area is Areas 4, 5 and 6. Backfilling with cobbles increased the permeability of the soil above the residual soil contamination, and created a "french drain" effect where groundwater can preferentially flows through the surrounding residually-contaminated soils into the backfilled gravel.

Dieldrin and endosulfan have been detected at concentrations that are greater than concentrations detected in groundwater prior to the removal action. The risk-based target concentration for dieldrin is 0.004 µg/l. Dieldrin is typically detected slightly above the analytical detection level (0.05 µg/l) in W-13 during most of the year, and at higher concentrations in W-13 and W-14 during the fall.

W-13 and W-14 are source wells, and when samples are filtered the detected concentrations are approximately one half of non-filtered samples. This suggests that a portion of the dieldrin detected in samples may be bound to clay or colloidal particles in the groundwater. Transport of that fraction of the dieldrin is limited by the size and migration rate of the colloidal particles. Adsorption and biodegradation by microbiological populations are degrading the fraction of dieldrin that is dissolved in groundwater into aldrin, and fixing dieldrin within the biomass until other degradation mechanisms remove dieldrin from groundwater.

Aldrin was last detected in groundwater in 1996. Aldrin is a byproduct of the degradation of dieldrin, and has never been used in process formulations or as a raw material at the site.

Endosulfan concentrations present in groundwater at the site are more than an order of magnitude less than risk-based concentrations of concern. USEPA may, however, further evaluate the risk-based concentration of endosulfan. Until that evaluation has been completed, further monitoring of the extent of endosulfan is necessary. Long-term groundwater monitoring results indicate that the extent of endosulfan remains stable across the site, but during fall sampling events elevated sample concentrations occur due to the seasonal high water table elevation. Endosulfan is present in groundwater within approximately 600 feet of the former disposal pit. The presence of endosulfan sulfate confirms that hydrolysis or microbiological degradation occurs. Groundwater concentrations of endosulfan I and II will eventually decrease as degradation mechanisms act on the remaining soil contamination.

DDT was detected in a non-filtered sample from W-13 in October, 1997 at a concentration of 0.07 µg/l. Prior to that detection, DDT had not been detected since May, 1996 (also in W-13). DDT was not detected in the filtered sample from W-13, which suggests that the DDT may be bound to clay or colloidal particles in the groundwater, and transport could be limited by the size and migration rate of the colloidal particles.

## **SECTION 7.0**

---

### ***RECOMMENDATIONS***

Based on the continued detection of organochlorine compounds at the former FMC pesticide formulation facility, groundwater monitoring should be continued at the site. The following monitoring wells should be sampled during the Fall of each year: W-7, W-12, W-13, W-14, W-16 and W-17. Although not necessary for evaluating compliance with the ROD, a Spring sampling event would be useful for comparison.

W-7 does not serve as a suitable downgradient monitoring well at the site because the top of the water table is not screened. Offsite downgradient monitoring wells W-11 and W-15 have been destroyed; therefore, an onsite replacement well W-18 will be installed and screened across the water table. Monitoring of W-18 will begin during the Fall 1998 sampling event.

Institutional controls restricting the use of on-site groundwater should be implemented.

## **SECTION 8.0**

---

### **REFERENCES**

- Bechtel, 1990, *Phase II Remedial Investigation Report for a Former Pesticide Formulation Facility in Yakima, Washington*: Report to FMC dated April, 1990.
- Bechtel, 1994, *Remedial Action Completion Report*: Report to FMC dated May, 1994.
- Dowdy, S., and Wearden, 1983, Statistics for Research: John Wiley and Sons, Inc., 537 p.
- ERM, 1994, *Long-Term Monitoring Plan*: Report to FMC dated June 1994
- Koch, G.S., and Link, R.F., 1970, Statistical Analysis of Geological Data, Volume 1: John Wiley and Sons, Inc., New York, New York, p. 218-220
- Loftis, J. C., Montgomery, R. H., Jarris, Jane, Nettles, David, Porter, P. S., Ward, R. C., Sanders, T. G., 1986, Monitoring strategies of groundwater quality management: Colorado Water Resources Research Institute Completion Report 140, p. 74-80.
- Lohman, S.W., 1979, Ground-water hydraulics: US Geological Survey Professional Paper 708, 70 p.
- Montgomery, John H., 1993: Agrochemicals Desk Reference - Environmental Data: Lewis Publishers, Boca Raton, LA.
- Rinehart, Milton, 1982, Statistical Procedure used to detect ground-water contamination: Best Available Technology letter report issued by OEPA, Division of Hazardous Materials Management, 16 p.
- Schroeder, P.R., and others, 1984, The hydrologic evaluation of landfill performance (HELP) model: US EPA Publication Number EPA/530-SW-84-010, 80 p.

**Appendix A**

**APPENDIX A**



***GROUNDWATER ANALYTICAL DATA***

Appendix A. Groundwater data. Concentrations in micrograms per liter.

Well	Date	Aldrin		alpha-BHC		beta-BHC		delta-BHC		gamma-BHC		Chlordane				
		Sample Result	Reporting Limit	Flag	Sample Result	Reporting Limit	Flag	Sample Result	Reporting Limit	Flag	Sample Result	Reporting Limit	Flag	Sample Result	Reporting Limit	Flag
W-1	Oct-97	0	0.05		0	0.05		0	0.05		0	0.05		0	0.05	
W-7	Oct-97	0	0.05		0	0.05		0	0.05		0	0.05		0	0.05	
W-9B	Oct-97	0	0.05		0	0.05		0	0.05		0	0.05		0	0.05	
W-12A	Oct-97	0	0.05		0	0.05		0	0.05		0	0.05		0	0.05	
W-12B	Oct-97	0	0.05		0	0.05		0	0.05		0	0.05		0	0.05	
W-13	Oct-97	0	0.05		0	0.05		0	0.05		0	0.05		0	0.05	
W-14	Oct-97	0	0.05		0	0.05		0	0.05		0	0.05		0	0.05	
W-16	Oct-97	0	0.05		0	0.05		0	0.05		0	0.05		0	0.05	
W-17	Oct-97	0	0.05		0	0.05		0	0.05		0	0.05		0	0.05	
W-7	Apr-97	0	0.05		0	0.05		0	0.05		0	0.05		0	0.05	
W-9B	Apr-97	0	0.05		0	0.05		0	0.05		0	0.05		0	0.05	
W-12A	Apr-97	0	0.05		0	0.05		0	0.05		0	0.05		0	0.05	
W-12B	Apr-97	0	0.05		0	0.05		0	0.05		0	0.05		0	0.05	
W-13	Apr-97	0	0.05		0	0.05		0	0.05		0	0.05		0	0.05	
W-14	Apr-97	0	0.05		0	0.05		0	0.05		0	0.05		0	0.05	
W-16	Apr-97	0	0.05		0	0.05		0	0.05		0	0.05		0	0.05	
W-17	Apr-97	0	0.05		0	0.05		0	0.05		0	0.05		0	0.05	
W-1	Dec-96	0	0.05		0	0.05		0	0.05		0	0.05		0	0.05	
W-7	Dec-96	0	0.05		0	0.05		0	0.05		0	0.05		0	0.05	
W-9B	Dec-96	0	0.05		0	0.05		0	0.05		0	0.05		0	0.05	
W-12A	Dec-96	0	0.05		0	0.05		0	0.05		0	0.05		0	0.05	
W-12B	Dec-96	0	0.05		0	0.05		0	0.05		0	0.05		0	0.05	
W-13	Dec-96	0.05	0.05		0	0.05		0	0.05		0	0.05		0	0.05	
W-14	Dec-96	0	0.05		0	0.05		0	0.05		0	0.05		0	0.05	
W-16	Dec-96	0	0.05		0	0.05		0	0.05		0	0.05		0	0.05	
W-17	Dec-96	0	0.05		0	0.05		0	0.05		0	0.05		0	0.05	
W-7	May-96	0	0.05		0	0.05		0	0.05		0	0.05		0	0.05	
W-9B	May-96	0	0.05		0	0.05		0	0.05		0	0.05		0	0.05	
W-12A	May-96	0	0.05		0	0.05		0	0.05		0	0.05		0	0.05	
W-12B	May-96	0	0.05		0	0.05		0	0.05		0	0.05		0	0.05	
W-13	May-96	0	0.05		0	0.05		0	0.05		0	0.05		0	0.05	
W-14	May-96	0	0.05		0	0.05		0	0.05		0	0.05		0	0.05	
W-15	May-96	0	0.05		0	0.05		0	0.05		0	0.05		0	0.05	
W-16	May-96	0	0.05		0	0.05		0	0.05		0	0.05		0	0.05	
W-17	May-96	0	0.05		0	0.05		0	0.05		0	0.05		0	0.05	
W-7	Feb-96	0	0.05		0	0.05		0	0.05		0	0.05		0	0.05	
W-9B	Feb-96	0	0.05		0	0.05		0	0.05		0	0.05		0	0.05	
W-12A	Feb-96	0	0.05		0	0.05		0	0.05		0	0.05		0	0.05	
W-12B	Feb-96	0	0.05		0	0.05		0	0.05		0	0.05		0	0.05	
W-13	Feb-96	0.03	0.05	NQ J	0	0.05		0	0.05		0	0.05		0	0.05	
W-14	Feb-96	0	0.05		0	0.05		0	0.05		0	0.05		0	0.05	

Appendix A. Groundwater data. Concentrations in micrograms per liter.

Well	Date	4,4'-DDD			4,4'-DDE			4,4'-DDT			Dieldrin			Endosulfan I			Endosulfan II		
		Sample Result	Reporting Limit	Flag															
W-1	Oct-97	0	0.05		0	0.05		0	0.05		0	0.05		0	0.05		0	0.05	
W-7	Oct-97	0	0.05		0	0.05		0	0.05		0	0.05		1.0	0.05		0.68	0.05	
W-9B	Oct-97	0	0.05		0	0.05		0	0.05		0	0.05		0	0.05		0	0.05	
W-12A	Oct-97	0	0.05		0	0.05		0	0.05		0	0.05		2.0	0.05		1.1	0.05	
W-12B	Oct-97	0	0.05		0	0.05		0	0.05		0	0.05		0.38	0.05		0.18	0.05	
W-13	Oct-97	0	0.05		0	0.05		0.07	0.05		0.47	0.05		6.8	0.05		3.7	0.05	
W-14	Oct-97	0	0.05		0	0.05		0	0.05		0.21	0.05		4.0	0.05		2.9	0.05	
W-16	Oct-97	0	0.05		0	0.05		0	0.05		0	0.05		0.24	0.05		0.11	0.05	
W-17	Oct-97	0	0.05		0	0.05		0	0.05		0	0.05		1.9	0.05		1.3	0.05	
W-7	Apr-97	0	0.05		0	0.05		0	0.05		0	0.05		0.41	0.05		0.22	0.05	
W-9B	Apr-97	0	0.05		0	0.05		0	0.05		0	0.05		0	0.05		0	0.05	
W-12A	Apr-97	0	0.05		0	0.05		0	0.05		0	0.05		0.44	0.05		0.19	0.05	
W-12B	Apr-97	0	0.05		0	0.05		0	0.05		0	0.05		1.2	0.05		0.52	0.05	
W-13	Apr-97	0	0.05		0	0.05		0	0.05		0.06	0.05		1.4	0.05		0.77	0.05	
W-14	Apr-97	0	0.05		0	0.05		0	0.05		0	0.05		1.1	0.05		0.55	0.05	
W-16	Apr-97	0	0.05		0	0.05		0	0.05		0	0.05		0.08	0.05		0	0.05	
W-17	Apr-97	0	0.05		0	0.05		0	0.05		0	0.05		0.66	0.05		0.29	0.05	
W-1	Dec-96	0	0.05		0	0.05		0	0.05		0	0.05		0	0.05		0	0.05	
W-7	Dec-96	0	0.05		0	0.05		0	0.05		0.03	0.05	J	0.65	0.05		0	0.05	
W-9B	Dec-96	0	0.05		0	0.05		0	0.05		0	0.05		0	0.05		0	0.05	
W-12A	Dec-96	0	0.05		0	0.05		0	0.05		0	0.05		0.89	0.05		0.45	0.05	
W-12B	Dec-96	0	0.05		0	0.05		0	0.05		0	0.05		1.5	0.05		0	0.05	
W-13	Dec-96	0	0.05		0	0.05		0	0.05		0.22	0.05		3.3	0.05		2.4	0.05	
W-14	Dec-96	0	0.05		0	0.05		0	0.05		0.03	0.05	J	1.3	0.05		0	0.05	
W-16	Dec-96	0	0.05		0	0.05		0	0.05		0	0.05		0.14	0.05		0	0.05	
W-17	Dec-96	0	0.05		0	0.05		0	0.05		0	0.05		0.78	0.05		0.4	0.05	
W-7	May-96	0	0.05		0	0.05		0	0.05		0	0.05		0.22	0.05		0.16	0.05	
W-9B	May-96	0	0.05		0	0.05		0	0.05		0	0.05		0	0.05		0	0.05	
W-12A	May-96	0	0.05		0	0.05		0	0.05		0	0.05		0.56	0.05		0.28	0.05	
W-12B	May-96	0	0.05		0	0.05		0	0.05		0	0.05		1.00	0.05		0.55	0.05	
W-13	May-96	0	0.05		0	0.05		0.06	0.05		0.07	0.05		0.98	0.05		0.66	0.05	
W-14	May-96	0	0.05		0	0.05		0	0.05		0	0.05		0.70	0.05		0.40	0.05	
W-15	May-96	0	0.05		0	0.05		0	0.05		0	0.05		0.33	0.05		0.26	0.05	
W-16	May-96	0	0.05		0	0.05		0	0.05		0	0.05		0.09	0.05		0.05	0.05	
W-17	May-96	0	0.05		0	0.05		0	0.05		0	0.05		0.57	0.05		0.32	0.05	
W-7	Feb-96	0	0.05		0	0.05		0	0.05		0	0.05		0.25	0.05		0.17	0.05	
W-9B	Feb-96	0	0.05		0	0.05		0	0.05		0	0.05		0	0.05		0	0.05	
W-12A	Feb-96	0	0.05		0	0.05		0	0.05		0	0.05		0.45	0.05		0.25	0.05	
W-12B	Feb-96	0	0.05		0	0.05		0	0.05		0	0.05		1.1	0.05		0.54	0.05	
W-13	Feb-96	0	0.05		0	0.05		0	0.05		0.060	0.05		1.3	0.05		0.79	0.05	
W-14	Feb-96	0	0.05		0	0.05		0	0.05		0	0.05		0.87	0.05		0.47	0.05	

Appendix A. Groundwater data. Concentrations in micrograms per liter.

Well	Date	Endosulfan sulfate			Endrin			Endrin aldehyde			Endrin Ketone			Heptachlor			Heptachlor Epoxide			
		Sample Result	Reporting Limit	Flag	Sample Result	Reporting Limit	Flag	Sample Result	Reporting Limit	Flag	Sample Result	Reporting Limit	Flag	Sample Result	Reporting Limit	Flag	Sample Result	Reporting Limit	Flag	
W-1	Oct-97	0	0.05		0	0.05		0	0.05		0	0.05		0	0.05		0	0.05		
W-7	Oct-97	0.84	0.05		0	0.05		0	0.05		0	0.05		0	0.05		0	0.05		
W-9B	Oct-97	0	0.05		0	0.05		0	0.05		0	0.05		0	0.05		0	0.05		
W-12A	Oct-97	0.94	0.05		0	0.05		0	0.05		0	0.05		0	0.05		0	0.05		
W-12B	Oct-97	0.09	0.05		0	0.05		0	0.05		0	0.05		0	0.05		0	0.05		
W-13	Oct-97	3.2	0.05		0	0.05		0	0.05		0	0.05		0	0.05		0	0.05		
W-14	Oct-97	5.0	0.05		0	0.05		0	0.05		0	0.05		0	0.05		0	0.05		
W-16	Oct-97	0.06	0.05		0	0.05		0	0.05		0	0.05		0	0.05		0	0.05		
W-17	Oct-97	1.7	0.05		0	0.05		0	0.05		0	0.05		0	0.05		0	0.05		
W-7	Apr-97	0.13	0.05		0	0.05		0	0.05		0	0.05		0	0.05		0	0.05		
W-9B	Apr-97	0	0.05		0	0.05		0	0.05		0	0.05		0	0.05		0	0.05		
W-12A	Apr-97	0.07	0.05		0	0.05		0	0.05		0	0.05		0	0.05		0	0.05		
W-12B	Apr-97	0.15	0.05		0	0.05		0	0.05		0	0.05		0	0.05		0	0.05		
W-13	Apr-97	0.40	0.05		0	0.05		0	0.05		0	0.05		0	0.05		0	0.05		
W-14	Apr-97	0.26	0.05		0	0.05		0	0.05		0	0.05		0	0.05		0	0.05		
W-16	Apr-97	0	0.05		0	0.05		0	0.05		0	0.05		0	0.05		0	0.05		
W-17	Apr-97	0.12	0.05		0	0.05		0	0.05		0	0.05		0	0.05		0	0.05		
W-1	Dec-96	0	0.05		0	0.05		0	0.05		0	0.05		0	0.05		0	0.05		
W-7	Dec-96	0.41	0.05		0	0.05		0	0.05		0	0.05		0	0.05		0	0.05		
W-9B	Dec-96	0	0.05		0	0.05		0	0.05		0	0.05		0	0.05		0	0.05		
W-12A	Dec-96	0.15	0.05		0	0.05		0	0.05		0	0.05		0	0.05		0	0.05		
W-12B	Dec-96	0.23	0.05		0.03	0.05	J	0	0.05		0	0.05		0	0.05		0	0.05		
W-13	Dec-96	1.6	0.05		0	0.05		0	0.05		0	0.05		0	0.05		0	0.05		
W-14	Dec-96	0.45	0.05		0	0.05		0	0.05		0	0.05		0	0.05		0	0.05		
W-16	Dec-96	0.04	0.05	J	0	0.05		0	0.05		0	0.05		0	0.05		0	0.05		
W-17	Dec-96	0.15	0.05		0	0.05		0	0.05		0	0.05		0	0.05		0	0.05		
W-7	May-96	0.14	0.05		0	0.05		0	0.05		0	0.05		0	0.05		0	0.05		
W-9B	May-96	0	0.05		0	0.05		0	0.05		0	0.05		0	0.05		0	0.05		
W-12A	May-96	0.13	0.05		0	0.05		0	0.05		0	0.05		0	0.05		0	0.05		
W-12B	May-96	0.20	0.05		0	0.05		0	0.05		0	0.05		0	0.05		0	0.05		
W-13	May-96	0.49	0.05		0	0.05		0	0.05		0	0.05		0	0.05		0	0.05		
W-14	May-96	0.27	0.05		0	0.05		0	0.05		0	0.05		0	0.05		0	0.05		
W-15	May-96	0.32	0.05		0	0.05		0	0.05		0	0.05		0	0.05		0	0.05		
W-16	May-96	0.03	0.05	NQ J	0	0.05		0	0.05		0	0.05		0	0.05		0	0.05		
W-17	May-96	0.21	0.05		0	0.05		0	0.05		0	0.05		0	0.05		0	0.05		
W-7	Feb-96	0.12	0.05		0	0.05		0	0.05		0	0.05		0	0.05		0	0.05		
W-9B	Feb-96	0	0.05		0	0.05		0	0.05		0	0.05		0	0.05		0	0.05		
W-12A	Feb-96	0.09	0.05		0	0.05		0	0.05		0	0.05		0	0.05		0	0.05		
W-12B	Feb-96	0.15	0.05		0	0.05		0	0.05		0	0.05		0	0.05		0	0.05		
W-13	Feb-96	0.47	0.05		0	0.05		0	0.05		0	0.05		0	0.05		0	0.05		
W-14	Feb-96	0.22	0.05		0	0.05		0	0.05		0	0.05		0	0.05		0	0.05		

Appendix A. Groundwater data. Concentrations in micrograms per liter.

Well	Date	4,4'-Methoxychlor			Toxaphene			Captan			Ovex			Perthane			Dicofol		
		Sample Result	Reporting Limit	Flag	Sample Result	Reporting Limit	Flag	Sample Result	Reporting Limit	Flag	Sample Result	Reporting Limit	Flag	Sample Result	Reporting Limit	Flag	Sample Result	Reporting Limit	Flag
W-1	Oct-97	0	0.05		0	1.0		0	0.05		0	0.05		0	0.50		0	0.05	
W-7	Oct-97	0	0.05		0	1.0		0	0.05		0	0.05		0	0.50		0	0.05	
W-9B	Oct-97	0	0.05		0	1.0		0	0.05		0	0.05		0	0.50		0	0.05	
W-12A	Oct-97	0	0.05		0	1.0		0	0.05		0	0.05		0	0.50		0	0.05	
W-12B	Oct-97	0	0.05		0	1.0		0	0.05		0	0.05		0	0.50		0	0.05	
W-13	Oct-97	0	0.05		0	1.0		0	0.05		0	0.05		0	0.50		0	0.05	
W-14	Oct-97	0	0.05		0	1.0		0	0.05		0	0.05		0	0.50		0	0.05	
W-16	Oct-97	0	0.05		0	1.0		0	0.05		0	0.05		0	0.50		0	0.05	
W-17	Oct-97	0	0.05		0	1.0		0	0.05		0	0.05		0	0.50		0	0.05	
W-7	Apr-97	0	0.05		0	1.0		0	0.05		0	0.05		0	0.50		0	0.05	
W-9B	Apr-97	0	0.05		0	1.0		0	0.05		0	0.05		0	0.50		0	0.05	
W-12A	Apr-97	0	0.05		0	1.0		0	0.05		0	0.05		0	0.50		0	0.05	
W-12B	Apr-97	0	0.05		0	1.0		0	0.05		0	0.05		0	0.50		0	0.05	
W-13	Apr-97	0	0.05		0	1.0		0	0.05		0	0.05		0	0.50		0	0.05	
W-14	Apr-97	0	0.05		0	1.0		0	0.05		0	0.05		0	0.50		0	0.05	
W-16	Apr-97	0	0.05		0	1.0		0	0.05		0	0.05		0	0.50		0	0.05	
W-17	Apr-97	0	0.05		0	1.0		0	0.05		0	0.05		0	0.50		0	0.05	
W-1	Dec-96	0	0.05		0	1.0		0	0.05		0	0.05		0	0.50		0	0.05	
W-7	Dec-96	0	0.05		0	1.0		0	0.05		0	0.05		0	0.50		0	0.05	
W-9B	Dec-96	0	0.05		0	1.0		0	0.05		0	0.05		0	0.50		0	0.05	
W-12A	Dec-96	0	0.05		0	1.0		0	0.05		0	0.05		0	0.50		0	0.05	
W-12B	Dec-96	0	0.05		0	1.0		0	0.05		0	0.05		0	0.50		0	0.05	
W-13	Dec-96	0	0.05		0	1.0		0	0.05		0	0.05		0	0.50		0	0.05	
W-14	Dec-96	0	0.05		0	1.0		0	0.05		0	0.05		0	0.50		0	0.05	
W-16	Dec-96	0	0.05		0	1.0		0	0.05		0	0.05		0	0.50		0	0.05	
W-17	Dec-96	0	0.05		0	1.0		0	0.05		0	0.05		0	0.50		0	0.05	
W-7	May-96	0	0.05		0	1.0		0	0.05		0	0.05		0	0.50		0	0.05	
W-9B	May-96	0	0.05		0	1.0		0	0.05		0	0.05		0	0.50		0	0.05	
W-12A	May-96	0	0.05		0	1.0		0	0.05		0	0.05		0	0.50		0	0.05	
W-12B	May-96	0	0.05		0	1.0		0	0.05		0	0.05		0	0.50		0	0.05	
W-13	May-96	0	0.05		0	1.0		0	0.05		0	0.05		0	0.50		0	0.05	
W-14	May-96	0	0.05		0	1.0		0	0.05		0	0.05		0	0.50		0	0.05	
W-15	May-96	0	0.05		0	1.0		0	0.05		0	0.05		0	0.50		0	0.05	
W-16	May-96	0	0.05		0	1.0		0	0.05		0	0.05		0	0.50		0	0.05	
W-17	May-96	0	0.05		0	1.0		0	0.05		0	0.05		0	0.50		0	0.05	
W-7	Feb-96	0	0.05		0	1.0		0	0.05		0	0.05		0	0.05		0	0.05	
W-9B	Feb-96	0	0.05		0	1.0		0	0.05		0	0.05		0	0.05		0	0.05	
W-12A	Feb-96	0	0.05		0	1.0		0	0.05		0	0.05		0	0.05		0	0.05	
W-12B	Feb-96	0	0.05		0	1.0		0	0.05		0	0.05		0	0.05		0	0.05	
W-13	Feb-96	0	0.05		0	1.0		0	0.05		0	0.05		0	0.05		0	0.05	
W-14	Feb-96	0	0.05		0	1.0		0	0.05		0	0.05		0	0.05		0	0.05	

Appendix A. Groundwater data. Concentrations in micrograms per liter.

Well	Date		Aldrin		alpha-BHC		beta-BHC		delta-BHC		gamma-BHC		Chlordane			
		Sample Result	Reporting Limit	Flag	Sample Result	Reporting Limit	Flag	Sample Result	Reporting Limit	Flag	Sample Result	Reporting Limit	Flag	Sample Result	Reporting Limit	Flag
W-15	Feb-96	0	0.05		0	0.05		0	0.05		0	0.05		0	0.05	
W-16	Feb-96	0	0.05		0	0.05		0	0.05		0	0.05		0	0.05	
W-17	Feb-96	0	0.05		0	0.05		0	0.05		0	0.05		0	0.05	
W-7	Dec-95	0	0.04		0	0.03		0	0.06		0	0.09		0	0.04	
W-9B	Dec-95	0	0.04		0	0.03		0	0.06		0.047	0.09	NQ J	0	0.04	
W-12A	Dec-95	0	0.04		0	0.03		0	0.06		0	0.09		0	0.04	
W-12B	Dec-95	0	0.04		0	0.03		0	0.06		0	0.09		0	0.04	
W-13	Dec-95	0.069	0.04		0.088	0.03		0	0.06		0.22	0.09		0	0.04	
W-14	Dec-95	0.03	0.04	NQ J	0	0.03		0	0.06		0	0.09		0	0.04	
W-15	Dec-95	0	0.04		0	0.03		0	0.06		0	0.09		0	0.04	
W-16	Dec-95	0	0.04		0	0.03		0	0.06		0	0.09		0	0.04	
W-17	Dec-95	0	0.04		0	0.03		0	0.06		0	0.09		0	0.04	
W-1	Sep-95	0	0.04		0	0.03		0	0.06		0	0.09		0	0.04	
W-7	Sep-95	0	0.04		0	0.03		0.013	0.06	NQ J	0.019	0.09	NQ J	0.018	0.04	NQ J
W-9B	Sep-95	0	0.04		0	0.03		0	0.06		0	0.09		0	0.04	
W-12A	Sep-95	0	0.04		0	0.03		0	0.06		0	0.09		0	0.04	
W-12B	Sep-95	0	0.04		0	0.03		0	0.06		0	0.09		0	0.04	
W-13	Sep-95	0.071	0.04		0.062	0.03		0.063	0.06		0.22	0.09		0	0.04	
W-14	Sep-95	0.017	0.04	NQ J	0	0.03		0.018	0.06	NQ J	0	0.09		0	0.04	
W-15	Sep-95	0	0.04		0	0.03		0.013	0.06	NQ J	0	0.09		0	0.04	
W-16	Sep-95	0	0.04		0	0.03		0	0.06		0	0.09		0	0.04	
W-17	Sep-95	0	0.04		0	0.03		0	0.06		0	0.09		0	0.04	
W-3	Jun-95	0	0.04		0	0.03		0	0.06		0	0.09		0	0.04	
W-4	Jun-95	0.047	0.04		0.052	0.03		0	0.06		0.065	0.09	NQ J	0.042	0.04	
W-5	Jun-95	0	0.04		0	0.03		0	0.06		0	0.09		0	0.04	
W-6	Jun-95	0	0.04		0.047	0.03		0	0.06		0.056	0.09	NQ J	0	0.04	
W-9B	Jun-95	0	0.04		0	0.03		0	0.06		0	0.09		0	0.04	
W-10	Jun-95	0	0.04		0	0.03		0	0.06		0	0.09		0	0.04	
W-11	Jun-95	0.03	0.04	NQ J	0	0.03		0	0.06		0	0.09		0	0.04	
W-12B	Jun-95	0	0.04		0	0.03		0	0.06		0	0.09		0	0.04	
W-13	Jun-95	0.095	0.04		0.054	0.03		0	0.06		0.09	0.09		0.04	0.04	
W-14	Jun-95	0.046	0.04		0.057	0.03		0	0.06		0.084	0.09	NQ J	0	0.04	
W-12A	Jun-95	0.032	0.04	NQ J	0.044	0.03		0	0.06		0.039	0.09	NQ J	0	0.04	
W-3	Mar-95	0	0.05		0	0.05		0	0.05		0	0.05		0	0.05	
W-4	Mar-95	0	0.05		0	0.05		0	0.05		0	0.05		0	0.05	
W-5	Mar-95	0	0.05		0	0.05		0	0.05		0	0.05		0	0.05	
W-6	Mar-95	0	0.05		0	0.05		0	0.05		0	0.05		0	0.05	
W-9B	Mar-95	0	0.05		0	0.05		0	0.05		0	0.05		0	0.05	
W-10	Mar-95	0	0.05		0	0.05		0	0.05		0	0.05		0	0.05	
W-11	Mar-95	0	0.05		0	0.05		0	0.05		0	0.05		0	0.05	
W-12B	Mar-95	0	0.05		0	0.05		0	0.05		0	0.05		0	0.05	

Appendix A. Groundwater data. Concentrations in micrograms per liter.

Well	Date	4,4'-DDD		4,4'-DDE		4,4'-DDT		Dieldrin		Endosulfan I		Endosulfan II							
		Sample Result	Reporting Limit	Flag	Sample Result	Reporting Limit	Flag	Sample Result	Reporting Limit	Flag	Sample Result	Reporting Limit	Flag	Sample Result	Reporting Limit	Flag			
W-15	Feb-96	0	0.05		0	0.05		0	0.05		0	0.48	0.05		0.32	0.05			
W-16	Feb-96	0	0.05		0	0.05		0	0.05		0	0.09	0.05		0.05	0.05			
W-17	Feb-96	0	0.05		0	0.05		0	0.05		0	0.64	0.05		0.31	0.05			
W-7	Dec-95	0	0.11		0	0.04		0	0.12		0.029	0.02		0.78	0.14		0.48	0.04	
W-9B	Dec-95	0	0.11		0	0.04		0	0.12		0	0.02		0	0.14		0	0.04	
W-12A	Dec-95	0	0.11		0	0.04		0	0.12		0.011	0.02	NQ J	1.7	0.14		0.71	0.04	
W-12B	Dec-95	0	0.11		0	0.04		0	0.12		0.018	0.02	NQ J	2.1	0.14		1.1	0.04	
W-13	Dec-95	0	0.11		0.021	0.04	NQ J	0	0.12		0.120	0.02		2.6	0.14		1.9	0.04	
W-14	Dec-95	0.015	0.11	NQ J	0.0082	0.04	NQ J	0	0.12		0.023	0.02		2.3	0.14		1.0	0.04	
W-15	Dec-95	0	0.11		0	0.04		0	0.12		0.028	0.02		0.86	0.14		0.49	0.04	
W-16	Dec-95	0	0.11		0	0.04		0	0.12		0	0.02		0.24	0.14		0.12	0.04	
W-17	Dec-95	0	0.11		0	0.04		0.0067	0.12	NQ J	0.013	0.02	NQ J	1.6	0.14		0.68	0.04	
W-1	Sep-95	0	0.11		0	0.04		0	0.12		0	0.02		0	0.14		0	0.04	
W-7	Sep-95	0	0.11		0	0.04		0	0.12		0.046	0.02		0.79	0.14		0.48	0.04	
W-9B	Sep-95	0	0.11		0	0.04		0	0.12		0	0.02		0	0.14		0	0.04	
W-12A	Sep-95	0	0.11		0	0.04		0	0.12		0.009	0.02	NQ J	0.41	0.14		0.23	0.04	
W-12B	Sep-95	0	0.11		0	0.04		0	0.12		0.008	0.02	NQ J	0.79	0.14		0.34	0.04	
W-13	Sep-95	0	0.11		0	0.04		0.084	0.12	NQ J	0.480	0.02		13	0.14		7.3	0.04	
W-14	Sep-95	0.021	0.11	NQ J	0.012	0.04	NQ J	0	0.12		0.073	0.02		1.6	0.14		1.1	0.04	
W-15	Sep-95	0	0.11		0	0.04		0	0.12		0.046	0.02		0.89	0.14		0.61	0.04	
W-16	Sep-95	0	0.11		0	0.04		0	0.12		0	0.02		0.19	0.14		0.1	0.04	
W-17	Sep-95	0	0.11		0	0.04		0	0.12		0.023	0.02		0.81	0.14		0.45	0.04	
W-3	Jun-95	0	0.1		0	0.04		0	0.11		0.023	0.02		0.094	0.13	J NQ	0.22	0.04	
W-4	Jun-95	0	0.1		0	0.04		0	0.11		0.120	0.02		1.7	0.13		1.1	0.04	
W-5	Jun-95	0	0.1		0	0.04		0	0.11		0	0.02		0.370	0.13		0.26	0.04	
W-6	Jun-95	0	0.1		0	0.04		0	0.11		0.024	0.02		1	0.13		0.73	0.04	
W-9B	Jun-95	0	0.1		0	0.04		0	0.11		0	0.02		0	0.13		0	0.04	
W-10	Jun-95	0	0.1		0	0.04		0	0.11		0	0.02		0	0.13		0.053	0.04	
W-11	Jun-95	0	0.1		0	0.04		0	0.11		0	0.02		0.34	0.13		0.21	0.04	
W-12B	Jun-95	0	0.1		0	0.04		0	0.11		0	0.02		0.97	0.13		0.51	0.04	
W-13	Jun-95	0.046	0.1	NQ J	0.028	0.04	NQ J	0.072	0.11	NQ J	0.190	0.02		5.3	0.13		2.9	0.04	
W-14	Jun-95	0	0.1		0	0.04		0	0.11		0.084	0.02		1.7	0.13		1.1	0.04	
W-12A	Jun-95	0	0.1		0	0.04		0	0.11		0.017	0.02	NQ J	1.9	0.13		0.88	0.04	
W-3	Mar-95	0	0.1		0	0.10		0	0.1		0	0.05		0.078	0.05		0.11	0.05	
W-4	Mar-95	0.38	0.1		0.27	0.10		0	0.1		0	0.10		0.43	0.05		0.35	0.10	
W-5	Mar-95	0	0.1		0	0.10		0	0.1		0	0.10		0.073	0.05	P	0.10	0.10	
W-6	Mar-95	0	0.1		0	0.10		0	0.1		0	0.05		0	0.05		0.52	0.05	P
W-9B	Mar-95	0	0.1		0	0.10		0	0.1		0	0.10		0	0.05		0	0.10	
W-10	Mar-95	0	0.1		0	0.10		0	0.1		0	0.10		0.7	0.05		0.046	0.10	NQ JP
W-11	Mar-95	0	0.1		0	0.10		0	0.1		0	0.10		0.13	0.05	P	0.16	0.10	
W-12B	Mar-95	0	0.1		0	0.10		0	0.1		0	0.10		0.86	0.25		0.52	0.10	

Appendix A. Groundwater data. Concentrations in micrograms per liter.

Well	Date	Endosulfan sulfate			Endrin			Endrin aldehyde			Endrin Ketone			Heptachlor			Heptachlor Epoxide		
		Sample Result	Reporting Limit	Flag	Sample Result	Reporting Limit	Flag	Sample Result	Reporting Limit	Flag	Sample Result	Reporting Limit	Flag	Sample Result	Reporting Limit	Flag	Sample Result	Reporting Limit	Flag
W-15	Feb-96	0.26	0.05		0	0.05		0	0.05		0	0.05		0	0.05		0	0.05	
W-16	Feb-96	0	0.05		0	0.05		0	0.05		0	0.05		0	0.05		0	0.05	
W-17	Feb-96	0.11	0.05		0	0.05		0	0.05		0	0.05		0	0.05		0	0.05	
W-7	Dec-95	0.63	0.66	NQ J	0	0.06		0	0.23		0	0.10		0	0.03		0	0.83	
W-9B	Dec-95	0	0.66		0	0.06		0	0.23		0	0.10		0	0.03		0.0058	0.83	NQ J
W-12A	Dec-95	0.25	0.66	NQ J	0.028	0.06	NQ J	0	0.23		0.0072	0.10	NQ J	0	0.03		0	0.83	
W-12B	Dec-95	0.27	0.66	NQ J	0.033	0.06	NQ J	0	0.23		0	0.10		0	0.03		0	0.83	
W-13	Dec-95	0.98	0.66		0.053	0.06	NQ J	0	0.23		0	0.10		0	0.03		0	0.83	
W-14	Dec-95	0	0.66		0.03	0.06	NQ J	0	0.23		0.012	0.10	NQ J	0	0.03		0	0.83	
W-15	Dec-95	0	0.66		0.027	0.06	NQ J	0	0.23		0	0.10		0	0.03		0	0.83	
W-16	Dec-95	0.063	0.66	NQ J	0.0059	0.06	NQ J	0	0.23		0	0.10		0	0.03		0	0.83	
W-17	Dec-95	0.24	0.66	NQ J	0.029	0.06	NQ J	0	0.23		0	0.10		0	0.03		0	0.83	
W-1	Sep-95	0	0.66		0	0.06		0	0.23		0	0.10		0	0.03		0	0.83	
W-7	Sep-95	0.57	0.66	NQ J	0	0.06		0	0.23		0.015	0.10	NQ J	0	0.03		0	0.83	
W-9B	Sep-95	0	0.66		0	0.06		0	0.23		0	0.10		0	0.03		0	0.83	
W-12A	Sep-95	0.19	0.66	NQ J	0	0.06		0	0.23		0	0.10		0	0.03		0	0.83	
W-12B	Sep-95	0.19	0.66	NQ J	0.018	0.06	NQ J	0	0.23		0	0.10		0	0.03		0	0.83	
W-13	Sep-95	6.3	0.66		0	0.06		0	0.23		0	0.10		0	0.03		0	0.83	
W-14	Sep-95	0.97	0.66		0.031	0.06	NQ J	0	0.23		0.023	0.10	NQ J	0	0.03		0	0.83	
W-15	Sep-95	0.94	0.66		0.021	0.06	NQ J	0	0.23		0.02	0.10	NQ J	0	0.03		0	0.83	
W-16	Sep-95	0	0.66		0	0.06		0	0.23		0	0.10		0	0.03		0	0.83	
W-17	Sep-95	0.39	0.66	NQ J	0.022	0.06	NQ J	0	0.23		0	0.10		0	0.03		0	0.83	
W-3	Jun-95	0	0.63		0	0.06		0	0.22		0	0.10		0	0.03		0	0.79	
W-4	Jun-95	0	0.63		0	0.06		0	0.22		0	0.10		0	0.03		0	0.79	
W-5	Jun-95	0	0.63		0	0.06		0	0.22		0	0.10		0	0.03		0	0.79	
W-6	Jun-95	0.79	0.63		0	0.06		0	0.22		0	0.10		0	0.03		0	0.79	
W-9B	Jun-95	0	0.63		0	0.06		0	0.22		0	0.10		0	0.03		0	0.79	
W-10	Jun-95	0	0.63		0	0.06		0	0.22		0	0.10		0	0.03		0	0.79	
W-11	Jun-95	0	0.63		0	0.06		0	0.22		0	0.10		0	0.03		0	0.79	
W-12B	Jun-95	0	0.63		0	0.06		0	0.22		0	0.10		0	0.03		0	0.79	
W-13	Jun-95	0	0.63		0	0.06		0	0.22		0	0.10		0	0.03		0	0.79	
W-14	Jun-95	0	0.63		0	0.06		0	0.22		0	0.10		0	0.03		0	0.79	
W-12A	Jun-95	0.74	0.63		0	0.06		0	0.22		0	0.10		0	0.03		0	0.79	
W-3	Mar-95	0.43	0.10	P	0	0.10		0	0.1					0	0.10		0	0.1	
W-4	Mar-95	0.4	0.10		0	0.10		0	0.1					0	0.05		0	0.05	
W-5	Mar-95	0.14	0.10	P	0	0.10		0	0.1					0	0.05		0	0.05	
W-6	Mar-95	0	0.10		0.41	0.10		0.33	0.1					0	0.10		0	0.1	
W-9B	Mar-95	0	0.10		0	0.10		0	0.1					0	0.05		0	0.05	
W-10	Mar-95	0	0.10		0	0.10		0	0.1					0	0.05		0	0.05	
W-11	Mar-95	0.12	0.10	P	0	0.10		0	0.1					0	0.05		0	0.05	
W-12B	Mar-95	0.16	0.10		0	0.10		0	0.1					0	0.05		0	0.05	

Appendix A. Groundwater data. Concentrations in micrograms per liter.

Well	Date	4,4'-Methoxychlor			Toxaphene			Cantan			Ovex			Perthane			Dicofol		
		Sample Result	Reporting Limit	Flag	Sample Result	Reporting Limit	Flag	Sample Result	Reporting Limit	Flag	Sample Result	Reporting Limit	Flag	Sample Result	Reporting Limit	Flag	Sample Result	Reporting Limit	Flag
W-15	Feb-96	0	0.05		0	1.0		0	0.05		0	0.05		0	0.05		0	0.05	
W-16	Feb-96	0	0.05		0	1.0		0	0.05		0	0.05		0	0.05		0	0.05	
W-17	Feb-96	0	0.05		0	1.0		0	0.05		0	0.05		0	0.05		0	0.05	
W-7	Dec-95	0	1.8		0	2.4		0	0.05		0	0.05		0	0.05		0	0.05	
W-9B	Dec-95	0	1.8		0	2.4		0	0.05		0	0.05		0	0.05		0	0.05	
W-12A	Dec-95	0	1.8		0	2.4		0	0.05		0	0.05		0	0.05		0	0.05	
W-12B	Dec-95	0	1.8		0	2.4		0	0.05		0	0.05		0	0.05		0	0.05	
W-13	Dec-95	0	1.8		0	2.4		0	0.05		0	0.05		0	0.05		0	0.05	
W-14	Dec-95	0	1.8		0	2.4		0	0.05		0	0.05		0	0.05		0	0.05	
W-15	Dec-95	0	1.8		0	2.4		0	0.05		0	0.05		0	0.05		0	0.05	
W-16	Dec-95	0	1.8		0	2.4		0	0.05		0	0.05		0	0.05		0	0.05	
W-17	Dec-95	0	1.8		0	2.4		0	0.05		0	0.05		0	0.05		0	0.05	
W-1	Sep-95	0	1.8		0	2.4		0	0.05		0	0.05		0	0.05		0	0.05	
W-7	Sep-95	0	1.8		0	2.4		0	0.05		0	0.05		0	0.05		0	0.05	
W-9B	Sep-95	0	1.8		0	2.4		0	0.05		0	0.05		0	0.05		0	0.05	
W-12A	Sep-95	0	1.8		0	2.4		0	0.05		0	0.05		0	0.05		0.013	0.05	NQ J
W-12B	Sep-95	0	1.8		0	2.4		0	0.05		0	0.05		0	0.05		0	0.05	
W-13	Sep-95	0	1.8		0	2.4		0	0.05		0	0.05		0	0.05		0	0.05	
W-14	Sep-95	0	1.8		0	2.4		0	0.05		0	0.05		0	0.05		0	0.05	
W-15	Sep-95	0	1.8		0	2.4		0	0.05		0	0.05		0	0.05		0	0.05	
W-16	Sep-95	0	1.8		0	2.4		0	0.05		0	0.05		0	0.05		0	0.05	
W-17	Sep-95	0	1.8		0	2.4		0	0.05		0	0.05		0	0.05		0	0.05	
W-3	Jun-95	0	1.7		0	2.3		0	0.10		0	0.05		0	0.05		0	0.05	
W-4	Jun-95	0	1.7		0	2.3		0	0.10		0	0.05		0	0.05		0	0.05	
W-5	Jun-95	0	1.7		0	2.3		0	0.10		0	0.05		0	0.05		0	0.05	
W-6	Jun-95	0	1.7		0	2.3		0	0.10		0	0.05		0	0.05		0	0.05	
W-9B	Jun-95	0	1.7		0	2.3		0	0.10		0	0.05		0	0.05		0	0.05	
W-10	Jun-95	0	1.7		0	2.3		0	0.10		0	0.05		0	0.05		0	0.05	
W-11	Jun-95	0	1.7		0	2.3		0	0.10		0	0.05		0	0.05		0	0.05	
W-12B	Jun-95	0	1.7		0	2.3		0	0.10		0	0.05		0	0.05		0	0.05	
W-13	Jun-95	0	1.7		0	2.3		0	0.10		0	0.05		0	0.05		0	0.05	
W-14	Jun-95	0	1.7		0	2.3		0	0.10		0	0.05		0	0.05		0	0.05	
W-12A	Jun-95	0	1.7		0	2.3		0	0.10		0	0.05		0	0.05		0	0.05	
W-3	Mar-95	0	0.5		0	5.0		0	0.40		0	0.40		0	0.40		0	0.40	
W-4	Mar-95	0	0.5		0	5.0		0	0.40		0	0.40		0	0.40		0	0.40	
W-5	Mar-95	0	0.5		0	5.0		0	0.40		0	0.40		0	0.40		0	0.40	
W-6	Mar-95	0	0.5		0	5.0		0	0.40		0	0.40		0	0.40		0	0.40	
W-9B	Mar-95	0	0.5		0	5.0		0	0.40		0	0.40		0	0.40		0	0.40	
W-10	Mar-95	0	0.5		0	5.0		0	0.40		0	0.40		0	0.40		0	0.40	
W-11	Mar-95	0	0.5		0	5.0		0	0.40		0	0.40		0	0.40		0	0.40	
W-12B	Mar-95	0	0.5		0	5.0		0	0.40		0	0.40		0	0.40		0	0.40	

Appendix A. Groundwater data. Concentrations in micrograms per liter.

Well	Date		Aldrin			alpha-BHC			beta-BHC			delta-BHC			gamma-BHC			Chlordane	
		Sample Result	Reporting Limit	Flag	Sample Result	Reporting Limit	Flag	Sample Result	Reporting Limit	Flag	Sample Result	Reporting Limit	Flag	Sample Result	Reporting Limit	Flag	Sample Result	Reporting Limit	Flag
W-13	Mar-95	0.11	0.05		0	0.05		0	0.05		0.099	0.05		0	0.05		0	2.00	
W-14	Mar-95	0	0.05		0	0.05		0	0.05		0	0.05		0	0.05		0	2.00	
W-12A	Mar-95	0	0.05		0	0.05		0	0.05		0	0.05		0	0.05		0	2.00	
W-3	Dec-94	0	0.10		0	0.10		0	0.10		0	0.10		0	0.10		0	2.00	
W-4	Dec-94	0	0.10		0	0.10		0	0.10		0	0.10		0	0.10		0	2.00	
W-5	Dec-94	0	0.10		0	0.10		0	0.10		0	0.10		0	0.10		0	2.00	
W-6	Dec-94	0	0.10		0	0.10		0	0.10		0	0.10		0	0.10		0	2.00	
W-9B	Dec-94	0	0.10		0	0.10		0	0.10		0	0.10		0	0.10		0	2.00	
W-10	Dec-94	0	0.10		0	0.10		0	0.10		0	0.10		0	0.10		0	2.00	
W-11	Dec-94	0	0.10		0	0.10		0	0.10		0	0.10		0	0.10		0	2.00	
W-12B	Dec-94	0	0.10		0	0.10		0	0.10		0	0.10		0	0.10		0	2.00	
W-13	Dec-94	0.074	0.10	NQ	0	0.10		0	0.10		0	0.10		0	0.10		0	2.00	
W-14	Dec-94	0	0.10		0	0.10		0	0.10		0	0.10		0	0.10		0	2.00	
W-12A	Dec-94	0	0.10		0	0.10		0	0.10		0	0.10		0	0.10		0	2.00	
W-3	Oct-94	0	0.10		0	0.10		0	0.10		0	0.10		0	0.10		0	1.00	
W-4	Oct-94	0	0.10		0.023	0.10	NQ JP	0	0.10		0.042	0.10	NQ JP	0	0.10		0	1.00	
W-5	Oct-94	0	0.10		0	0.10		0	0.10		0	0.10		0	0.10		0	1.00	
W-6	Oct-94	0	0.10		0	0.10		0	0.10		0	0.10		0	0.10		0	1.00	
W-9B	Oct-94	0	0.10		0	0.10		0	0.10		0	0.10		0	0.10		0	1.00	
W-11	Oct-94	0	0.10		0	0.10		0	0.10		0	0.10		0	0.10		0	1.00	
W-12B	Oct-94	0	0.10		0	0.10		0	0.10		0	0.10		0	0.10		0	1.00	
W-13	Oct-94	0.054	0.10	NQ J	0.033	0.10	NQ JP	0	0.10		0.058	0.10	NQ JP	0.025	0.10	NQ JP	0	1.00	
W-14	Oct-94	0	0.10		0.037	0.10	NQ JP	0.023	0.10	NQ JP	0.055	0.10	NQ JP	0.02	0.10	NQ JP	0	1.00	
W-12A	Oct-94	0	0.10		0.046	0.10	NQ JP	0.027	0.10	NQ JP	0.037	0.10	NQ JP	0	0.10		0	1.00	
W-3	Jun-94	0	0.03		0	0.03		0.017	0.01		0	0.03		0.007	0.03	NQ	0	0.14	
W-4	Jun-94	0.012	0.03	NQ	0.018	0.03	NQ	0.02	0.01		0	0.03		0.008	0.03	NQ	0	0.14	
W-5	Jun-94	0	0.03		0	0.03		0.006	0.01	NQ	0	0.03		0	0.03		0	0.13	
W-6	Jun-94	0	0.03		0	0.03		0.009	0.01	NQ	0	0.03		0	0.03		0	0.14	
W-9B	Jun-94	0	0.03		0	0.03		0	0.01		0	0.03		0	0.03		0	0.14	
W-10	Jun-94	0	0.03		0	0.03		0	0.01		0	0.03		0	0.03		0	0.14	
W-11	Jun-94	0	0.03		0	0.03		0	0.01		0	0.03		0	0.03		0	0.14	
W-12B	Jun-94	0	0.03		0	0.03		0.008	0.01	NQ	0	0.03		0	0.03		0	0.14	
W-13	Jun-94	0	0.03		0.193	0.03	R	0.17	0.01	R	0.388	0.03	R	0.152	0.03	R	0	0.27	
W-14	Jun-94	0	0.03		0.012	0.03	NQ R	0.025	0.01	R	0	0.03		0	0.03		0	0.14	
W-12A	Jun-94	0	0.03		0	0.03		0.006	0.01	NQ	0	0.03		0	0.03		0	0.14	
W-1	Apr-94	0	0.03		0	0.03		0	0.01		0	0.03		0	0.03		0	0.13	
W-4	Apr-94	0	0.03		0	0.03		0	0.01		0	0.03		0	0.03		0	0.13	
W-9B	Apr-94	0	0.03		0	0.03		0	0.01		0	0.03		0	0.03		0	0.13	
W-10	Apr-94	0	0.03		0	0.03		0	0.01		0	0.03		0	0.03		0	0.14	
W-12B	Apr-94	0	0.03		0	0.03		0	0.01		0	0.03		0	0.03		0	0.13	
OH-1	Apr-94	0.131	0.03		0	0.03		0	0.01		0.112	0.03		0	0.03		0	0.13	

Appendix A. Groundwater data. Concentrations in micrograms per liter.

Well	Date	4,4'-DDD		4,4'-DDE		4,4'-DDT		Dieldrin		Endosulfan I		Endosulfan II						
		Sample Result	Reporting Limit	Flag	Sample Result	Reporting Limit	Flag	Sample Result	Reporting Limit	Flag	Sample Result	Reporting Limit	Flag	Sample Result	Reporting Limit	Flag		
W-13	Mar-95	0	0.1		0	0.10		0	0.1		0.170	0.10	P	1.8	0.25		1.5	0.50
W-14	Mar-95	0	0.1		0	0.10		0	0.1		0	0.10		0.74	0.25		0.48	0.10
W-12A	Mar-95	0	0.1		0	0.10		0	0.1		0	0.10		0.53	0.1		0.31	0.10
W-3	Dec-94	0	0.1		0	0.10		0	0.1		0	0.10		0.039	0.1	NQ J	0.05	0.10
W-4	Dec-94	0	0.1		0	0.10		0	0.1		0	0.10		0.62	0.5		0.34	0.10
W-5	Dec-94	0	0.1		0	0.10		0	0.1		0	0.10		0.10	0.1	NQ JP	0.08	0.10
W-6	Dec-94	0	0.1		0	0.10		0	0.1		0	0.10		0.69	0.5		0.45	0.10
W-9B	Dec-94	0	0.1		0	0.10		0	0.1		0	0.10		0	0.1		0	0.10
W-10	Dec-94	0	0.1		0	0.10		0	0.1		0	0.10		0.11	0.1		0.062	0.10
W-11	Dec-94	0	0.1		0	0.10		0	0.1		0	0.10		0.21	0.1		0.13	0.10
W-12B	Dec-94	0	0.1		0	0.10		0	0.1		0	0.10		0.87	0.25		0.33	0.10
W-13	Dec-94	0	0.1		0	0.10		0	0.1		0.180	0.10		2.1	0.5		1.4	0.50
W-14	Dec-94	0	0.1		0	0.10		0	0.1		0	0.10		0.83	0.5		0.56	0.10
W-12A	Dec-94	0	0.1		0	0.10		0	0.1		0	0.10		0.43	0.5	NQ J	0.23	0.10
W-3	Oct-94	0	0.1		0	0.10		0	0.1		0.047	0.10	NQ J	0.064	0.1	NQ JP	0.100	0.10
W-4	Oct-94	0	0.1		0	0.10		0	0.1		0.190	0.25	NQ JP	4.2	0.5		2.8	0.25
W-5	Oct-94	0	0.1		0	0.10		0	0.1		0.022	0.10	NQ J	1.000	0.25	P	0.780	0.25
W-6	Oct-94	0	0.1		0	0.10		0	0.1		0.097	0.10	NQ JP	1.6	0.5		1.3	0.50
W-9B	Oct-94	0	0.1		0	0.10		0	0.1		0	0.10		0.028	0.1	NQ JP	0	0.10
W-11	Oct-94	0	0.1		0	0.10		0	0.1		0.028	0.10	NQ J	0.54	0.2		0.42	0.20
W-12B	Oct-94	0	0.1		0	0.10		0	0.1		0	0.10		0.8	0.5		0.6	0.50
W-13	Oct-94	0	0.1		0	0.10		0	0.1		0.210	0.50	NQ J	4.60	1		3.00	0.50
W-14	Oct-94	0	0.1		0	0.10		0	0.1		0.220	0.50	NQ JP	3.7	0.5	J	2.9	0.50
W-12A	Oct-94	0	0.1		0	0.10		0	0.1		0.100	0.10		3.4	0.5		2.9	0.50
W-3	Jun-94	0	0.032		0	0.03		0	0.043		0.048	0.03		0.333	0.031		0.353	0.04
W-4	Jun-94	0	0.032		0	0.03		0	0.043		0.060	0.03		0.807	0.031		0.578	0.04
W-5	Jun-94	0	0.031		0	0.03		0	0.042		0	0.03		0.303	0.031		0.175	0.04
W-6	Jun-94	0	0.032		0	0.03		0	0.044		0.010	0.03	NQ	0.842	0.031		0.456	0.04
W-9B	Jun-94	0	0.032		0	0.03		0	0.044		0	0.03		0	0.031		0	0.04
W-10	Jun-94	0	0.032		0	0.03		0	0.043		0	0.03		0.099	0.031		0.062	0.04
W-11	Jun-94	0	0.032		0	0.03		0	0.043		0	0.03		0.046	0.031		0.033	0.04
W-12B	Jun-94	0	0.032		0	0.03		0	0.043		0	0.03		1.14	0.031		0.799	0.04
W-13	Jun-94	0.106	0.032	R	0.038	0.03	NQ R	0.172	0.043	R	0.510	0.03	R	4.74	0.031	R	2.67	0.04
W-14	Jun-94	0	0.032		0	0.03		0	0.043		0.028	0.03	NQ R	0.745	0.031	R	0.478	0.04
W-12A	Jun-94	0	0.032		0	0.03		0	0.043		0	0.03		0.464	0.031		0.3	0.04
W-1	Apr-94	0	0.031		0	0.03		0	0.042		0	0.03		0	0.03		0	0.04
W-4	Apr-94	2.83	0.031		1.73	0.03		0.252	0.042		0	0.03		0.318	0.03		0.225	0.04
W-9B	Apr-94	0	0.031		0	0.03		0	0.042		0	0.03		0	0.03		0	0.04
W-10	Apr-94	0	0.032		0	0.03		0	0.043		0	0.03		0	0.031		0	0.04
W-12B	Apr-94	0	0.031		0	0.03		0	0.042		0	0.03		0.412	0.03		0.224	0.04
OH-1	Apr-94	0	0.031		0	0.03		0	0.042		0.162	0.03		0.455	0.03		0.259	0.04

Appendix A. Groundwater data. Concentrations in micrograms per liter.

Well	Date	Endosulfan sulfate		Endrin		Endrin aldehyde		Endrin Ketone		Heptachlor		Heptachlor Epoxide				
		Sample Result	Reporting Limit	Flag	Sample Result	Reporting Limit	Flag	Sample Result	Reporting Limit	Flag	Sample Result	Reporting Limit	Flag	Sample Result	Reporting Limit	Flag
W-13	Mar-95	1.20	0.50		0	0.10		0	0.1		0	0.05		0	0.05	
W-14	Mar-95	0.3	0.10		0	0.10		0	0.1		0	0.05		0	0.05	
W-12A	Mar-95	0.17	0.10		0	0.10		0	0.1		0	0.05		0	0.05	
W-3	Dec-94	0.21	0.10		0	0.10		0	0.1		0	0.10		0	0.1	
W-4	Dec-94	0.29	0.10	P	0	0.10		0	0.1		0	0.10		0	0.1	
W-5	Dec-94	0.067	0.10	NQ JP	0	0.10		0	0.1		0	0.10		0	0.1	
W-6	Dec-94	0.26	0.10	P	0	0.10		0	0.1		0	0.10		0	0.1	
W-9B	Dec-94	0	0.10		0	0.10		0	0.1		0	0.10		0	0.1	
W-10	Dec-94	0.052	0.10	NQ JP	0	0.10		0	0.1		0	0.10		0	0.1	
W-11	Dec-94	0.095	0.10	NQ JP	0	0.10		0	0.1		0	0.10		0	0.1	
W-12B	Dec-94	0.065	0.10	NQ JP	0	0.10		0	0.1		0	0.10		0	0.1	
W-13	Dec-94	1.10	0.50		0	0.10		0	0.1		0	0.10		0	0.1	
W-14	Dec-94	0.31	0.10	P	0	0.10		0	0.1		0	0.10		0	0.1	
W-12A	Dec-94	0.081	0.10	NQ P	0	0.10		0	0.1		0	0.10		0	0.1	
W-3	Oct-94	0.13	0.10	P	0	0.10		0	0.1		0	0.10		0	0.1	
W-4	Oct-94	0.48	0.25	P	0.068	0.10	NQ JP	0	0.1		0	0.10		0	0.1	
W-5	Oct-94	0.25	0.25	P	0	0.10		0	0.1		0	0.10		0	0.1	
W-6	Oct-94	0.85	0.50	P	0	0.10		0	0.1		0	0.10		0	0.1	
W-9B	Oct-94	0	0.10		0	0.10		0	0.1		0	0.10		0	0.1	
W-11	Oct-94	0.17	0.20	NQ JP	0	0.10		0	0.1		0	0.10		0	0.1	
W-12B	Oct-94	0.33	0.50	NQ J	0	0.10		0	0.1		0	0.10		0	0.1	
W-13	Oct-94	0.80	0.50		0	0.10		0	0.1		0	0.10		0	0.1	
W-14	Oct-94	1.2	0.50		0	0.10		0	0.1		0	0.10		0	0.1	
W-12A	Oct-94	1.6	0.50	P	0	0.10		0	0.1		0	0.10		0	0.1	
W-3	Jun-94	0.574	0.05		0	0.03				0	0.04		0	0.04		0.032
W-4	Jun-94	0.804	0.05		0.020	0.03	NQ			0	0.04		0	0.04		0.032
W-5	Jun-94	0.267	0.05		0.019	0.03	NQ			0	0.04		0	0.04		0.031
W-6	Jun-94	0.456	0.05		0.023	0.03	NQ			0	0.04		0	0.04		0.032
W-9B	Jun-94	0	0.05		0	0.03				0	0.04		0	0.04		0.032
W-10	Jun-94	0.09	0.05	NQ	0	0.03				0	0.04		0	0.04		0.031
W-11	Jun-94	0.051	0.05	NQ	0.013	0.03	NQ			0	0.04		0	0.04		0.032
W-12B	Jun-94	0.381	0.05		0.028	0.03	NQ			0	0.04		0	0.04		0.032
W-13	Jun-94	2.56	0.05	R	0.063	0.03	R			0.114	0.04	R	0	0.07		0.063
W-14	Jun-94	0.547	0.05	R	0.012	0.03	NQ R			0	0.04		0	0.04		0.032
W-12A	Jun-94	0.187	0.05		0.018	0.03	NQ			0	0.04		0	0.04		0.032
W-1	Apr-94	0	0.05		0	0.03				0	0.04		0	0.04		0.031
W-4	Apr-94	0	0.05		0	0.03				0	0.04		0	0.04		0.031
W-9B	Apr-94	0	0.05		0	0.03				0	0.04		0	0.04		0.031
W-10	Apr-94	0	0.05		0	0.03				0	0.04		0	0.04		0.032
W-12B	Apr-94	0	0.05		0	0.03				0	0.04		0	0.04		0.031
OH-1	Apr-94	0	0.05		0	0.03				0	0.04		0	0.04		0.031

Appendix A. Groundwater data. Concentrations in micrograms per liter.

Well	Date	4,4'-Methoxychlor			Toxaphene			Captan			Ovex			Perthane			Dicofol		
		Sample Result	Reporting Limit	Flag	Sample Result	Reporting Limit	Flag	Sample Result	Reporting Limit	Flag	Sample Result	Reporting Limit	Flag	Sample Result	Reporting Limit	Flag	Sample Result	Reporting Limit	Flag
W-13	Mar-95	0	0.5		0	5.0		0	0.40		0	0.40		0	0.40		0	0.40	
W-14	Mar-95	0	0.5		0	5.0		0	0.40		0	0.40		0	0.40		0	0.40	
W-12A	Mar-95	0	0.5		0	5.0		0	0.40		0	0.40		0	0.40		0	0.40	
W-3	Dec-94	0	0.1		0	5.0		0	0.40		0	0.40		0	0.40		0	0.40	
W-4	Dec-94	0	0.1		0	5.0		0	0.40		0	0.40		0	0.40		0	0.40	
W-5	Dec-94	0	0.1		0	5.0		0	0.40		0	0.40		0	0.40		0	0.40	
W-6	Dec-94	0	0.1		0	5.0		0	0.40		0	0.40		0	0.40		0	0.40	
W-9B	Dec-94	0	0.1		0	5.0		0	0.40		0	0.40		0	0.40		0	0.40	
W-10	Dec-94	0	0.1		0	5.0		0	0.40		0	0.40		0	0.40		0	0.40	
W-11	Dec-94	0	0.1		0	5.0		0	0.40		0	0.40		0	0.40		0	0.40	
W-12B	Dec-94	0	0.1		0	5.0		0	0.40		0	0.40		0	0.40		0	0.40	
W-13	Dec-94	0	0.1		0	5.0		0	0.40		0	0.40		0	0.40		0	0.40	
W-14	Dec-94	0	0.1		0	5.0		0	0.40		0	0.40		0	0.40		0	0.40	
W-12A	Dec-94	0	0.1		0	5.0		0	0.40		0	0.40		0	0.40		0	0.40	
W-3	Oct-94	0	0.1		0	5.0		0	0.40		0	0.40		0	0.40		0	0.40	
W-4	Oct-94	0	0.1		0	5.0		0	0.40		0	0.40		0	0.40		0	0.40	
W-5	Oct-94	0	0.1		0	5.0		0	0.40		0	0.40		0	0.40		0	0.40	
W-6	Oct-94	0	0.1		0	5.0		0	0.40		0	0.40		0	0.40		0	0.40	
W-9B	Oct-94	0	0.1		0	5.0		0	0.40		0	0.40		0	0.40		0	0.40	
W-11	Oct-94	0	0.1		0	5.0		0	0.40		0	0.40		0	0.40		0	0.40	
W-12B	Oct-94	0	0.1		0	5.0		0	0.40		0	0.40		0	0.40		0	0.40	
W-13	Oct-94	0	0.1		0	5.0		0	0.40		0	0.40		0	0.40		0	0.40	
W-14	Oct-94	0	0.1		0	5.0		0	0.40		0	0.40		0	0.40		0	0.40	
W-12A	Oct-94	0	0.1		0	5.0		0	0.40		0	0.40		0	0.40		0	0.40	
W-3	Jun-94	0	0.037		0	0.6		0	0.04		0	0.10		0	0.41		0.049	0.04	
W-4	Jun-94	0	0.037		0	0.6		0	0.04		0	0.10		0	0.41		0.069	0.04	
W-5	Jun-94	0	0.036		0	0.6		0	0.04		0	0.10		0	0.40		0	0.04	
W-6	Jun-94	0	0.038		0	0.6		0	0.04		0	0.10		0	0.42		0	0.04	
W-9B	Jun-94	0	0.037		0	0.6		0	0.04		0	0.10		0	0.42		0	0.04	
W-10	Jun-94	0	0.037		0	0.6		0	0.04		0	0.10		0	0.41		0	0.04	
W-11	Jun-94	0	0.037		0	0.6		0	0.04		0	0.10		0	0.41		0	0.04	
W-12B	Jun-94	0	0.037		0	0.6		0	0.04		0	0.10		0	0.41		0	0.04	
W-13	Jun-94	0	0.073		0	1.1		0	0.08		0.455	0.10	R	0	0.82		0.712	0.04	R
W-14	Jun-94	0	0.037		0	0.6		0	0.04		0	0.10		0	0.41		0	0.04	
W-12A	Jun-94	0	0.037		0	0.6		0	0.04		0	0.10		0	0.41		0	0.04	
W-1	Apr-94	0	0.036		0	0.6		0	0.04		0	0.10		0	0.40		0	0.04	
W-4	Apr-94	0.136	0.036		0	0.5		0	0.04		0.92	0.10		0.758	0.40		0.15	0.04	
W-9B	Apr-94	0	0.036		0	0.5		0	0.04		0	0.10		0	0.40		0	0.04	
W-10	Apr-94	0	0.037		0	0.6		0	0.04		0	0.10		0	0.40		0	0.04	
W-12B	Apr-94	0	0.036		0	0.6		0	0.04		0	0.10		0	0.40		0	0.04	
OH-1	Apr-94	0	0.036		0	0.6		0	0.04		0	0.10		0	0.40		0.303	0.04	

Appendix A. Groundwater data. Concentrations in micrograms per liter.

Well	Date	Aldrin		alpha-BHC		beta-BHC		delta-BHC		gamma-BHC		Chlordane				
		Sample Result	Reporting Limit	Flag	Sample Result	Reporting Limit	Flag	Sample Result	Reporting Limit	Flag	Sample Result	Reporting Limit	Flag	Sample Result	Reporting Limit	Flag
OH-2	Apr-94	0	0.03		0	0.03		0	0.01		0	0.03		0	0.13	
W-12A	Apr-94	0	0.03		0	0.03		0	0.01		0	0.03		0	0.13	
OH-3	Apr-94	0	0.03		0	0.03		0	0.01		0	0.03		0	0.13	
W-1	Dec-93	0	0.03		0	0.03		0	0.01		0	0.03		0	0.13	
W-2	Dec-93	0	0.03		0	0.03		0	0.01		0	0.03		0	0.13	
W-3	Dec-93	0	0.03		0	0.03		0	0.01		0.049	0.03		0	0.13	
W-4	Dec-93	0	0.03		0	0.03		0	0.01		0	0.03		0	0.13	
W-5	Dec-93	0	0.03		0	0.03		0	0.01		0	0.03		0	0.13	
W-6	Dec-93	0	0.03		0	0.03		0	0.01		0	0.03		0	0.13	
W-7	Dec-93	0	0.03		0	0.03		0	0.01		0	0.03		0	0.13	
W-9A	Dec-93	0	0.03		0	0.03		0	0.01		0	0.03		0	0.13	
W-9B	Dec-93	0	0.03		0	0.03		0	0.01		0	0.03		0	0.13	
W-10	Dec-93	0	0.03		0	0.03		0	0.01		0	0.03		0	0.13	
W-11	Dec-93	0	0.03		0	0.03		0	0.01		0	0.03		0	0.13	
W-12B	Dec-93	0	0.03		0	0.03		0	0.01		0	0.03		0	0.13	
OH-1	Dec-93	0.16	0.03		0.033	0.03		0	0.01		0.082	0.03		0	0.13	
OH-2	Dec-93	0.058	0.03		0	0.03		0.019	0.01		0.056	0.03		0	0.13	
W-12A	Dec-93	0	0.03		0	0.03		0	0.01		0	0.03		0	0.13	
OH-3	Dec-93	0	0.03		0	0.03		0	0.01		0	0.03		0	0.13	
W-4	Jul-93	0.0488	0.03	J	0.0758	0.03		0.0554	0.01		0.125	0.03		0.0721	0.03	
W-5	Jul-93	0	0.03		0	0.03		0.0617	0.01		0.0871	0.03		0	0.13	
W-6	Jul-93	0	0.03		0.106	0.03		0.117	0.01		0.205	0.03		0.0632	0.03	
W-11	Jul-93	0	0.03		0	0.03		0	0.01		0	0.03		0	0.13	
W-12B	Jul-93	0	0.03		0.582	0.03		0.282	0.01		0.782	0.03		0.340	0.03	
W-12A	Jul-93	0	0.03		0.438	0.03		0.275	0.01		0.627	0.03		0.226	0.03	
W-1	Jul-93	0	0.03		0	0.03		0	0.01		0	0.03		0	0.13	
W-2	Jul-93	0	0.03		0	0.03		0	0.01		0	0.03		0	0.13	
W-3	Jul-93	0	0.03		0	0.03		0	0.01		0	0.03		0	0.13	
W-7	Jul-93	0	0.03		0	0.03		0	0.01		0	0.03		0	0.13	
W-9A	Jul-93	0	0.03		0	0.03		0	0.01		0	0.03		0	0.13	
W-9B	Jul-93	0	0.03		0	0.03		0	0.01		0	0.03		0	0.13	
W-10	Jul-93	0	0.03		0	0.03		0	0.01		0	0.03		0	0.13	
OH-1	Jul-93	0.0377	0.03		0	0.03		0	0.01		0	0.03		0	0.13	
OH-2	Jul-93	0	0.03		0.147	0.03		0.0640	0.01		0.153	0.03		0.122	0.03	
OH-3	Jul-93	0	0.03		0.111	0.03		0.0778	0.01		0.133	0.03		0.0533	0.03	
OH-1	Apr-93	0.127	0.03		0	0.03		0.0305	0.01		0.0481	0.03		0	0.13	
OH-2	Apr-93	0	0.03		0	0.03		0.0230	0.01		0.0559	0.03		0.0324	0.03	
W-7	Apr-93	0	0.03		0	0.03		0	0.01		0	0.03		0	0.13	
W-9A	Apr-93	0	0.03		0	0.03		0	0.01		0	0.03		0	0.13	
W-9B	Apr-93	0	0.03		0	0.03		0	0.01		0	0.03		0	0.13	
W-10	Apr-93	0	0.03		0	0.03		0	0.01		0	0.03		0	0.13	

**Appendix A. Groundwater data. Concentrations in micrograms per liter.**

Well	Date	4,4'-DDD		4,4'-DDE		4,4'-DDT		Dieldrin		Endosulfan I			Endosulfan II					
		Sample Result	Reporting Limit	Flag	Sample Result	Reporting Limit	Flag	Sample Result	Reporting Limit	Flag	Sample Result	Reporting Limit	Flag	Sample Result	Reporting Limit	Flag		
OH-2	Apr-94	0	0.031		0	0.03		0	0.042		0	0.03		0.535	0.03		0.394	0.04
W-12A	Apr-94	0	0.031		0	0.03		0	0.042		0	0.03		0.279	0.03		0.229	0.04
OH-3	Apr-94	0	0.031		0	0.03		0	0.042		0	0.03		0.380	0.03		0.196	0.04
W-1	Dec-93	0	0.031		0	0.03		0	0.042		0	0.03		0	0.03		0	0.04
W-2	Dec-93	0	0.031		0	0.03		0	0.042		0	0.03		1.31	0.03		0.136	0.04
W-3	Dec-93	0	0.031		0	0.03		0	0.042		0.072	0.03		2.09	0.03		1.040	0.04
W-4	Dec-93	0	0.031		0	0.03		0	0.042		0.058	0.03		1.8	0.03		1.120	0.04
W-5	Dec-93	0	0.031		0	0.03		0	0.042		0	0.03		0.386	0.03		0.200	0.04
W-6	Dec-93	0	0.031		0	0.03		0	0.042		0.037	0.03		1.21	0.03		0.596	0.04
W-7	Dec-93	0	0.031		0	0.03		0	0.042		0	0.03		0.706	0.03		0.454	0.04
W-9A	Dec-93	0	0.031		0	0.03		0	0.042		0	0.03		0	0.03		0	0.04
W-9B	Dec-93	0	0.031		0	0.03		0	0.042		0	0.03		0	0.03		0	0.04
W-10	Dec-93	0	0.031		0	0.03		0	0.042		0	0.03		0.08	0.03		0.055	0.04
W-11	Dec-93	0	0.031		0	0.03		0	0.042		0	0.03		0.201	0.03		0.117	0.04
W-12B	Dec-93	0	0.031		0	0.03		0	0.042		0	0.03		2.27	0.03		0.984	0.04
OH-1	Dec-93	0	0.031		0	0.03		0.056	0.042		0.150	0.03		0.683	0.03		0.484	0.04
OH-2	Dec-93	0	0.031		0	0.03		0	0.042		0.071	0.03		1.99	0.03		1.49	0.04
W-12A	Dec-93	0	0.031		0	0.03		0	0.042		0	0.03		0.787	0.03		0.376	0.04
OH-3	Dec-93	0	0.031		0	0.03		0	0.042		0	0.03		0.788	0.03		0.397	0.04
W-4	Jul-93	0	0.0310		0	0.03		0.0542	0.0420	J	0.146	0.03	J				0.957	0.04
W-5	Jul-93	0	0.0310		0	0.03		0	0.0420		0	0.03						
W-6	Jul-93	0	0.0310		0	0.03		0	0.0420		0.155	0.03					0.877	0.04
W-11	Jul-93	0	0.0310		0	0.03		0	0.0420		0.038	0.03		0.413	0.0300	J	0.350	0.04
W-12B	Jul-93	0	0.0310		0	0.03		0	0.0420		0.095	0.03						
W-12A	Jul-93	0	0.0310		0	0.03		0	0.0420		0	0.03						
W-1	Jul-93	0	0.0310		0	0.03		0	0.0420		0	0.03		0	0.0300		0	0.04
W-2	Jul-93	0.0538	0.0310		0.0510	0.03		0.139	0.0420		0	0.03		0	0.0300		0	0.04
W-3	Jul-93	0	0.0310		0	0.03		0	0.0420		0.057	0.03		0	0.0300		0.0865	0.04
W-7	Jul-93	0	0.0310		0	0.03		0	0.0420		0.032	0.03	J	0.182	0.0300		0.142	0.04
W-9A	Jul-93	0	0.0310		0	0.03		0	0.0420		0	0.03		0	0.0300		0	0.04
W-9B	Jul-93	0	0.0310		0	0.03		0	0.0420		0	0.03		0.792	0.0300		0.403	0.04
W-10	Jul-93	0	0.0310		0	0.03		0	0.0420		0	0.03		0.290	0.0300		0.173	0.04
OH-1	Jul-93	0	0.0310		0.0291	0.03	NQ J	0.111	0.0420		0.044	0.03		0.218	0.0300		0.167	0.04
OH-2	Jul-93	0	0.0310		0	0.03		0	0.0420		0.151	0.03		1.16	0.0600		0.788	0.04
OH-3	Jul-93	0	0.0310		0	0.03		0	0.0420		0.052	0.03		2.39	0.150	J	1.80	0.19
OH-1	Apr-93	0.120	0.0310		0.0453	0.03		0.469	0.0420		0.190	0.03		0.239	0.0300		0.346	0.04
OH-2	Apr-93	0.0344	0.0310		0	0.03		0.182	0.0420		0.108	0.03		0.312	0.0300		0.433	0.04
W-7	Apr-93	0	0.0310		0	0.03		0.0434	0.0420		0.031	0.03		0.203	0.0300		0.160	0.04
W-9A	Apr-93	0	0.0310		0	0.03		0	0.0420		0	0.03		0	0.0300		0	0.04
W-9B	Apr-93	0	0.0310		0	0.03		0	0.0420		0	0.03		0	0.0300		0	0.04
W-10	Apr-93	0	0.0310		0	0.03		0	0.0420		0	0.03		0.127	0.0300		0.0873	0.04

Appendix A. Groundwater data. Concentrations in micrograms per liter.

Well	Date	Endosulfan sulfate			Endrin			Endrin aldehyde			Endrin Ketone			Heptachlor			Heptachlor Epoxide		
		Sample Result	Reporting Limit	Flag	Sample Result	Reporting Limit	Flag	Sample Result	Reporting Limit	Flag	Sample Result	Reporting Limit	Flag	Sample Result	Reporting Limit	Flag	Sample Result	Reporting Limit	Flag
OH-2	Apr-94	0.326	0.05		0	0.03					0	0.04		0	0.04		0	0.031	
W-12A	Apr-94	0	0.05		0	0.03					0	0.04		0	0.04		0	0.031	
OH-3	Apr-94	0	0.05		0	0.03					0	0.04		0	0.04		0	0.031	
W-1	Dec-93	0	0.05		0	0.03					0	0.04		0	0.04		0	0.031	
W-2	Dec-93	0.068	0.05		0	0.03					0	0.04		0	0.04		0	0.031	
W-3	Dec-93	1.22	0.05		0	0.03					0	0.04		0	0.04		0	0.031	
W-4	Dec-93	0.505	0.05		0	0.03					0	0.04		0	0.04		0	0.031	
W-5	Dec-93	0.092	0.05		0	0.03					0	0.04		0	0.04		0	0.031	
W-6	Dec-93	0.374	0.05		0	0.03					0	0.04		0	0.04		0	0.031	
W-7	Dec-93	0.328	0.05		0	0.03					0	0.04		0	0.04		0	0.031	
W-9A	Dec-93	0	0.05		0	0.03					0	0.04		0	0.04		0	0.031	
W-9B	Dec-93	0	0.05		0	0.03					0	0.04		0	0.04		0	0.031	
W-10	Dec-93	0	0.05		0	0.03					0	0.04		0	0.04		0	0.031	
W-11	Dec-93	0.091	0.05		0	0.03					0	0.04		0	0.04		0	0.031	
W-12B	Dec-93	0.148	0.05		0	0.03					0	0.04		0	0.04		0	0.031	
OH-1	Dec-93	0.178	0.05		0	0.03					0	0.04		0	0.04		0	0.031	
OH-2	Dec-93	0.609	0.05		0	0.03					0	0.04		0	0.04		0	0.031	
W-12A	Dec-93	0.135	0.05		0	0.03					0	0.04		0	0.04		0	0.031	
OH-3	Dec-93	0.112	0.05		0	0.03					0	0.04		0	0.04		0	0.031	
W-4	Jul-93	0.602	0.05		0.0369	0.03					0	0.04		0	0.04		0	0.0310	
W-5	Jul-93				0	0.03					0.0314	0.04	NQ J	0	0.04		0	0.0310	
W-6	Jul-93				0	0.03					0.0504	0.04		0	0.04		0	0.0310	
W-11	Jul-93	0.496	0.05		0	0.03					0	0.04		0	0.04		0	0.0310	
W-12B	Jul-93				0.0700	0.03					0.130	0.04		0	0.04		0	0.0310	
W-12A	Jul-93				0.0581	0.03					0.0861	0.04		0	0.04		0.195	0.0310	
W-1	Jul-93	0	0.05		0	0.03					0	0.04		0	0.04		0	0.0310	
W-2	Jul-93	0	0.05		0	0.03					0	0.04		0	0.04		0	0.0310	
W-3	Jul-93	0.251	0.05		0	0.03					0	0.04		0	0.04		0	0.0310	
W-7	Jul-93	0.295	0.05		0	0.03					0	0.04		0	0.04		0	0.0310	
W-9A	Jul-93	0	0.05		0	0.03					0	0.04		0	0.04		0	0.0310	
W-9B	Jul-93	0.183	0.05		0	0.03					0	0.04		0	0.04		0	0.0310	
W-10	Jul-93	0.209	0.05		0	0.03					0	0.04		0	0.04		0	0.0310	
OH-1	Jul-93	0.138	0.05		0	0.03					0	0.04		0	0.04		0	0.0310	
OH-2	Jul-93	0.712	0.05		0	0.03					0	0.04		0	0.04		0	0.0310	
OH-3	Jul-93	1.56	0.25		0	0.03					0	0.04		0	0.04		0	0.0310	
OH-1	Apr-93	0.413	0.05		0	0.03					0	0.04		0.0682	0.04		0	0.0310	
OH-2	Apr-93	0.612	0.05		0	0.03					0	0.04		0	0.04		0	0.0310	
W-7	Apr-93	0.166	0.05		0	0.03					0	0.04		0	0.04		0	0.0310	
W-9A	Apr-93	0	0.05		0	0.03					0	0.04		0	0.04		0	0.0310	
W-9B	Apr-93	0	0.05		0	0.03					0	0.04		0	0.04		0	0.0310	
W-10	Apr-93	0.0824	0.05		0	0.03					0	0.04		0	0.04		0	0.0310	

Appendix A. Groundwater data. Concentrations in micrograms per liter.

Well	Date	4,4'-Methoxychlor			Toxaphene			Captan			Ovex			Perthane			Dicofol		
		Sample Result	Reporting Limit	Flag	Sample Result	Reporting Limit	Flag	Sample Result	Reporting Limit	Flag	Sample Result	Reporting Limit	Flag	Sample Result	Reporting Limit	Flag	Sample Result	Reporting Limit	Flag
OH-2	Apr-94	0	0.036		0	0.6		0	0.04		0	0.10		0	0.40		0	0.04	
W-12A	Apr-94	0	0.036		0	0.6		0	0.04		0	0.10		0	0.40		0	0.04	
OH-3	Apr-94	0	0.036		0	0.6		0	0.04		0	0.10		0	0.40		0	0.04	
W-1	Dec-93	0	0.036		0	0.5		0	0.04		0	0.10		0	0.40		0	0.04	
W-2	Dec-93	0	0.036		0	0.5		0	0.04		0	0.10		0	0.40		0	0.04	
W-3	Dec-93	0	0.036		0	0.5		0	0.04		0	0.10		0	0.40		0	0.04	
W-4	Dec-93	0.136	0.036		0	0.5		0	0.04		0.92	0.10		0.758	0.40		0.15	0.04	
W-5	Dec-93	0	0.036		0	0.5		0	0.04		0	0.10		0	0.40		0	0.04	
W-6	Dec-93	0	0.036		0	0.5		0	0.04		0	0.10		0	0.40		0	0.04	
W-7	Dec-93	0	0.036		0	0.5		0	0.04		0	0.10		0	0.40		0	0.04	
W-9A	Dec-93	0	0.036		0	0.5		0	0.04		0	0.10		0	0.40		0	0.04	
W-9B	Dec-93	0	0.036		0	0.5		0	0.04		0	0.10		0	0.40		0	0.04	
W-10	Dec-93	0	0.036		0	0.5		0	0.04		0	0.10		0	0.40		0	0.04	
W-11	Dec-93	0	0.036		0	0.5		0	0.04		0	0.10		0	0.40		0	0.04	
W-12B	Dec-93	0	0.036		0	0.5		0	0.04		0	0.10		0	0.40		0	0.04	
OH-1	Dec-93	0	0.036		0	0.6		0	0.04		0	0.10		0	0.40		0.303	0.04	
OH-2	Dec-93	0	0.036		0	0.6		0	0.04		0	0.10		0	0.40		0	0.04	
W-12A	Dec-93	0	0.036		0	0.5		0	0.04		0	0.10		0	0.40		0	0.04	
OH-3	Dec-93	0	0.036		0	0.6		0	0.04		0	0.10		0	0.40		0	0.04	
W-4	Jul-93	0	0.0360		0	0.5													
W-5	Jul-93	0	0.0360		0	0.5													
W-6	Jul-93	0	0.0360																
W-11	Jul-93	0	0.0360		0	0.5													
W-12B	Jul-93	0	0.0360																
W-12A	Jul-93	0	0.0360																
W-1	Jul-93	0	0.0360		0	0.5													
W-2	Jul-93	0	0.0360		0	0.5													
W-3	Jul-93	0	0.0360		0	0.5													
W-7	Jul-93	0	0.0360		0	0.5													
W-9A	Jul-93	0	0.0360		0	0.5													
W-9B	Jul-93	0	0.0360		0	0.5													
W-10	Jul-93	0	0.0360		0	0.5													
OH-1	Jul-93	0	0.0360		0	0.5													
OH-2	Jul-93	0	0.0360		0	0.5													
OH-3	Jul-93	0	0.0360		0	0.5													
OH-1	Apr-93	0	0.0360		0	0.5													
OH-2	Apr-93	0	0.0360		0	0.5													
W-7	Apr-93	0	0.0360		0	0.5													
W-9A	Apr-93	0	0.0360		0	0.5													
W-9B	Apr-93	0	0.0360		0	0.5													
W-10	Apr-93	0	0.0360		0	0.5													

Appendix A. Groundwater data. Concentrations in micrograms per liter.

Well	Date		Aldrin		alpha-BHC		beta-BHC		delta-BHC		gamma-BHC		Chlordane					
		Sample Result	Reporting Limit	Flag	Sample Result	Reporting Limit	Flag	Sample Result	Reporting Limit	Flag	Sample Result	Reporting Limit	Flag	Sample Result	Reporting Limit	Flag		
W-11	Apr-93	0	0.03		0	0.03		0	0.01		0	0.03		0	0.03		0	0.13
OH-3	Apr-93	0	0.03		0	0.03		0	0.01		0	0.03		0	0.03		0	0.13
W-7	Jan-93	0	0.03		0	0.03		0	0.01		0	0.03		0	0.03		0	0.13
W-9A	Jan-93	0	0.03		0	0.03		0	0.01		0	0.03		0	0.03		0	0.13
W-9B	Jan-93	0	0.03		0	0.03		0	0.01		0	0.03		0	0.03		0	0.13
OH-1	Jan-93	0.263	0.03		0.0821	0.03		0	0.01		0.127	0.03		0.0590	0.03		0	0.13
OH-2	Jan-93	0	0.03		0.0350	0.03		0	0.01		0.0700	0.03		0.0434	0.03		0	0.13
W-10	Jan-93	0	0.03		0	0.03		0	0.01		0	0.03		0	0.03		0	0.13
W-11	Jan-93	0	0.03		0	0.03		0	0.01		0	0.03		0	0.03		0	0.13
OH-3	Jan-93	0	0.03		0	0.03		0	0.01		0	0.03		0	0.03		0	0.13
OH-1	Dec-92	0.921	0.03		0.261	0.03		0.142	0.01		0.431	0.03		0.168	0.03		0	0.13
W-11	Nov-92	0	0.03		0	0.03		0	0.01		0	0.03		0	0.03		0	0.14
OH-3	Nov-92	0	0.03		0	0.03		0	0.01		0	0.03		0	0.03		0	0.14
W-7	Oct-92	0	0.03		0	0.03		0	0.01		0	0.03		0	0.03		0	0.13
W-1	Oct-92	0	0.03		0	0.03		0	0.01		0	0.03		0	0.03		0	0.13
W-2	Oct-92	0	0.03		0	0.03		0	0.01		0	0.03		0	0.03			
W-3	Oct-92	0	0.03		0	0.03		0	0.01		0	0.03		0	0.03		0	0.13
W-5	Oct-92	0	0.03		0.0875	0.03	J	0	0.01		0	0.03		0.0409	0.03		0	0.13
W-9A	Oct-92	0	0.03		0	0.03		0	0.01		0	0.03		0	0.03		0	0.13
W-9B	Oct-92	0	0.03		0	0.03		0	0.01		0	0.03		0	0.03		0	0.13
W-10	Oct-92	0	0.03		0	0.03		0	0.01		0	0.03		0	0.03		0	0.13
W-11	Oct-92	0	0.03		0	0.03		0	0.01		0	0.03		0	0.03		0	0.13
W-4	Oct-92	0.216	0.03		0.193	0.03		0.215	0.01		0.310	0.03		0.252	0.03		0	0.13
W-6	Oct-92	0	0.03		0	0.03		0.0473	0.01		0.0856	0.03		0	0.03		0	0.11
OH-1	Oct-92	0.138	0.03		0.0437	0.03		0.0268	0.01		0	0.03		0	0.03		0	0.13
OH-2	Oct-92	0.0489	0.03		0.0302	0.03		0.0162	0.01		0	0.03		0	0.03		0	0.13
OH-3	Oct-92	0	0.03		0	0.03		0	0.01		0	0.03		0	0.03		0	0.13
OH-2	Oct-92	0.0658	0.03		0	0.03		0.0341	0.01		0	0.03		0	0.03		0	0.13
W-1	Sep-92	0	0.03		0	0.03		0	0.01		0	0.03		0	0.03		0	0.13
W-6	Sep-92	0	0.03		0.0952	0.03		0.141	0.01		0	0.03		0.224	0.03		0	0.13
W-4	Sep-92	0.0918	0.03		0.0536	0.03		0.0457	0.01		0.111	0.03		0.0443	0.03		0	0.13
W-9A	Sep-92	0	0.03		0	0.03		0	0.01		0	0.03		0	0.03		0	0.13
W-6	Aug-92	0.215	0.03		0.135	0.03		0	0.01		0.858	0.03		0	0.03		5.67	0.69
W-4	Aug-92	0.103	0.03		0.146	0.03		0.0481	0.01		0.0953	0.03		0.0993	0.03		0	0.14
W-4	Aug-92	0.134	0.03		0.131	0.03		0.0579	0.01		0.0796	0.03		0.0858	0.03		0	0.14
W-5	Aug-92	0.0248	0.03	J NQ	0.0860	0.03		0.0497	0.01		0.0921	0.03		0.164	0.03		0	0.14
W-5	Aug-92	0.0377	0.03		0.0837	0.03		0.0548	0.01		0.0854	0.03		0.164	0.03		0	0.14
W-9A	Aug-92	0	0.03		0	0.03		0	0.01					0	0.03		0	0.13
W-9B	Aug-92	0	0.03		0	0.03		0	0.03		0	0.03		0	0.03		0	0.13
OH-3	Aug-92	0.101	0.03		0.197	0.03		0.126	0.01		0.257	0.03		0.0340	0.03		0	0.14
W-2	Aug-92													0.109	0.03			

**Appendix A. Groundwater data. Concentrations in micrograms per liter.**

Well	Date	4,4'-DDD		4,4'-DDE		4,4'-DDT		Dieldrin		Endosulfan I		Endosulfan II		Flag					
		Sample Result	Reporting Limit	Flag	Sample Result	Reporting Limit	Flag	Sample Result	Reporting Limit	Flag	Sample Result	Reporting Limit	Flag	Sample Result	Reporting Limit				
W-11	Apr-93	0	0.0310		0	0.03		0	0.0420		0	0.03		0.137	0.0300	0.102	0.04		
OH-3	Apr-93	0	0.0310		0	0.03		0	0.0420		0	0.03		0.778	0.0300	0.374	0.04		
W-7	Jan-93	0	0.0310		0	0.03		0	0.0420		0.039	0.03		0.233	0.0300	0.133	0.04		
W-9A	Jan-93	0	0.0310		0	0.03		0	0.0420		0	0.03		0.0489	0.0300	0.0453	0.04		
W-9B	Jan-93	0	0.0310		0	0.03		0	0.0420		0	0.03		0	0.0300	0	0.04		
OH-1	Jan-93	0.0656	0.0310		0.0972	0.03		0.504	0.0420		0.279	0.03		0.593	0.0300	0.410	0.04		
OH-2	Jan-93	0.0364	0.0310		0	0.03		0	0.0420		0.175	0.03		0.895	0.0300	0.585	0.04		
W-10	Jan-93	0	0.0310		0	0.03		0	0.042		0	0.03		0.139	0.0300	0.0912	0.04		
W-11	Jan-93	0	0.0310		0	0.03		0.0663	0.042		0.034	0.03		0.169	0.0300	0.115	0.04		
OH-3	Jan-93	0	0.0310		0	0.03		0	0.042		0	0.03		0.959	0.0300	0.501	0.04		
OH-1	Dec-92	0.312	0.0310		0.483	0.03		2.62	0.420		0.376	0.03		0.806	0.0300	0.375	0.04		
W-11	Nov-92	0	0.0310		0	0.03		0	0.0420		0	0.03		0.0966	0.0300	0.0804	0.04		
OH-3	Nov-92	0	0.0316		0	0.03		0	0.0429		0	0.03		0.811	0.0306	0.440	0.04		
W-7	Oct-92	0	0.0310		0	0.03		0	0.0420		0.076	0.03		0.117	0.0300	0.0905	0.04		
W-1	Oct-92	0	0.0310		0	0.03		0	0.0420		0	0.03		0	0.0300	0	0.04		
W-2	Oct-92	0.178	0.0310		0.0657	0.03		0.238	0.0420		0	0.03		0.0505	0.0300	0	0.04		
W-3	Oct-92	0	0.0310		0	0.03		0	0.0420		0.078	0.03		0.0514	0.0300	0.0726	0.04		
W-5	Oct-92	0	0.0310		0	0.03		0	0.0420		0.041	0.03		0.904	0.0300	0.500	0.04		
W-9A	Oct-92	0	0.0310		0	0.03		0	0.0420		0	0.03		0	0.0300	0	0.04		
W-9B	Oct-92	0	0.0310		0	0.03		0	0.0420		0	0.03		0.0647	0.0300	0	0.04		
W-10	Oct-92	0	0.0310		0	0.03		0	0.0420		0	0.03		0.215	0.0300	0.150	0.04		
W-11	Oct-92	0	0.0310		0	0.03		0	0.0420		0	0.03		0.0782	0.0300	0.0584	0.04		
W-4	Oct-92	0.139	0.0310		0.0622	0.03		0.138	0.0420		0.356	0.03		0.481	0.0300	0.248	0.04		
W-6	Oct-92	0.0414	0.0310		0	0.03		0.0422	0.0420		0.143	0.03		1.26	0.150	0.768	0.04		
OH-1	Oct-92	0.124	0.0310		0.0835	0.03		0.582	0.0420		0.145	0.03		0.0818	0.0300	0.109	0.04		
OH-2	Oct-92	0	0.0310		0	0.03		0	0.0420		0.271	0.03		0.128	0.0300	0.106	0.04		
OH-3	Oct-92	0	0.0310		0	0.03		0	0.0420		0	0.03		1.15	0.150	0.765	0.04		
OH-2	Oct-92	0.119	0.0310		0	0.03		0.0489	0.0420		0.260	0.03		0.140	0.0300	0.160	0.04		
W-1	Sep-92	0	0.0310		0	0.03		0	0.0420		0	0.03		0	0.0300	0	0.04		
W-6	Sep-92	0	0.0310		0	0.03		0.504	0.0420		0.192	0.03		1.32	0.150	0.706	0.04		
W-4	Sep-92	0.221	0.0310		0.0387	0.03		0.425	0.0420		0.502	0.03		0.261	0.0300	0.199	0.04		
W-9A	Sep-92	0	0.0310		0	0.03		0	0.0420		0	0.03		0	0.0300	0	0.04		
W-6	Aug-92	0.182	0.0320		1.56	0.14		4.47	0.216		0	0.03		35.3	1.55	50.1	1.96		
W-4	Aug-92	0.163	0.0316		0.0586	0.03		0.143	0.0429		0.439	0.03		0.506	0.0319	0.147	0.04		
W-4	Aug-92	0.141	0.0330		0.0291	0.03		0.214	0.0447		0.427	0.03		0.490	0.0306	0.139	0.04		
W-5	Aug-92	0.0316	0.0330	NQ J	0	0.03		0	0.0433		0.130	0.03		1.15	0.0319	0.607	0.04		
W-5	Aug-92	0.0368	0.0320		0.0128	0.03	J	0	0.0447		0.134	0.03		1.09	0.0309	0.534	0.04		
W-9A	Aug-92	0	0.0310		0	0.03		0	0.0420		0	0.03		0.0135	0.0300	NQ J	0.0144	0.04	NQ J
W-9B	Aug-92	0	0.0313		0	0.03		0	0.0424		0	0.03		0.335	0.0303	0.165	0.04		
OH-3	Aug-92	0.173	0.0320		0	0.03		0.0832	0.0433		0.312	0.03		1.68	0.155	0.876	0.04		
W-2	Aug-92										0.071	0.03		0.107	0.0300	0.246	0.04		

Appendix A. Groundwater data. Concentrations in micrograms per liter.

Well	Date	Endosulfan sulfate		Endrin		Endrin aldehyde		Endrin Ketone		Heptachlor		Heptachlor Epoxide				
		Sample Result	Reporting Limit	Flag	Sample Result	Reporting Limit	Flag	Sample Result	Reporting Limit	Flag	Sample Result	Reporting Limit	Flag	Sample Result	Reporting Limit	Flag
W-11	Apr-93	0.108	0.05		0	0.03			0	0.04	0	0.04		0	0.0310	
OH-3	Apr-93	0.157	0.05		0	0.03			0	0.04	0	0.04		0	0.0310	
W-7	Jan-93	0.191	0.05		0	0.03			0	0.04	0	0.04		0	0.0310	
W-9A	Jan-93	0.138	0.05		0	0.03			0	0.04	0	0.04		0	0.0310	
W-9B	Jan-93	0.145	0.05		0	0.03			0	0.04	0	0.04		0	0.0310	
OH-1	Jan-93	0.285	0.05		0	0.03			0	0.04	0.0874	0.04		0	0.0310	
OH-2	Jan-93	0.680	0.05		0	0.03			0	0.04	0	0.04		0	0.0310	
W-10	Jan-93	0.0640	0.05		0	0.03			0	0.04	0	0.04		0	0.0310	
W-11	Jan-93	0.0790	0.05		0	0.03			0	0.04	0	0.04		0	0.0310	
OH-3	Jan-93	0.132	0.05		0	0.03			0	0.04	0	0.04		0	0.0310	
OH-1	Dec-92	0.0770	0.05		0	0.03			0	0.04	0.128	0.04		0	0.0310	
W-11	Nov-92	0.143	0.05		0	0.03			0	0.04	0	0.04		0	0.0310	
OH-3	Nov-92	0.323	0.05		0	0.03			0	0.04	0	0.04		0	0.0316	
W-7	Oct-92	0.127	0.05		0	0.03			0	0.04	0	0.04		0	0.0310	
W-1	Oct-92	0	0.05		0	0.03			0	0.04	0	0.04		0	0.0310	
W-2	Oct-92	0.123	0.05		0	0.03			0	0.04	0	0.04		0	0.0310	
W-3	Oct-92	0.297	0.05		0	0.03			0	0.04	0	0.04		0	0.0310	
W-5	Oct-92	0.354	0.05		0	0.03			0	0.04	0	0.04		0	0.0310	
W-9A	Oct-92	0	0.05		0	0.03			0	0.04	0	0.04		0	0.0310	
W-9B	Oct-92	0	0.05		0	0.03			0	0.04	0	0.04		0	0.0310	
W-10	Oct-92	0.300	0.05		0	0.03			0	0.04	0	0.04		0	0.0310	
W-11	Oct-92	0.113	0.05		0	0.03			0	0.04	0	0.04		0	0.0310	
W-4	Oct-92	0.396	0.05		0	0.03			0	0.04	0	0.04		0	0.0310	
W-6	Oct-92	1.25	0.25		0	0.03			0	0.04	0	0.04		0	0.0310	
OH-1	Oct-92	0.284	0.05		0	0.03			0	0.04	0.0547	0.04		0	0.0310	
OH-2	Oct-92	0.302	0.05		0	0.03			0	0.04	0	0.04		0	0.0310	
OH-3	Oct-92	0.412	0.05		0	0.03			0	0.04	0	0.04		0	0.0310	
OH-2	Oct-92	0.379	0.05		0	0.03			0	0.04	0.0436	0.04		0	0.0310	
W-1	Sep-92	0	0.05		0	0.03		0	0.0290	0	0.04		0	0.04		0.0310
W-6	Sep-92	0.715	0.25		0	0.03		0	0.0290	0.0530	0.04	0	0.04		0	0.0310
W-4	Sep-92	0.385	0.05		0	0.03		0	0.0290	0	0.04	0.0671	0.04		0	0.0310
W-9A	Sep-92	0	0.05		0	0.03		0	0.0290	0	0.04		0	0.04		0.0310
W-6	Aug-92	45.8	2.58		4.97	0.17		0	0.0299	0	0.04		0	0.04		0.0320
W-4	Aug-92	0.173	0.05		0	0.03		0	0.0296	0	0.04	0.0673	0.04		0.0179	0.0330
W-4	Aug-92	0.178	0.05		0	0.03		0	0.0309	0	0.04	0.0617	0.04		0	0.0316
W-5	Aug-92	0.332	0.05		0	0.03		0	0.0309	0	0.04		0	0.04		0.0330
W-5	Aug-92	0.278	0.05		0	0.03		0	0.0299	0	0.04		0	0.04		0.0320
W-9A	Aug-92	0	0.05		0	0.03		0	0.0290	0	0.04		0	0.04		0.0310
W-9B	Aug-92	0	0.05		0.0141	0.03	NQ J	0	0.0293	0	0.04		0	0.04		0.0313
OH-3	Aug-92	0.667	0.05		0	0.03		0	0.0299	0	0.04		0	0.04		0.0320
W-2	Aug-92	0.140	0.05		0	0.03		0	0.0290	0	0.04		0	0.04		0.0310

Appendix A. Groundwater data. Concentrations in micrograms per liter.

Well	Date	4,4'-Methoxychlor			Toxaphene			Captan			Ovex			Perthane			Dicofol		
		Sample Result	Reporting Limit	Flag	Sample Result	Reporting Limit	Flag	Sample Result	Reporting Limit	Flag	Sample Result	Reporting Limit	Flag	Sample Result	Reporting Limit	Flag	Sample Result	Reporting Limit	Flag
W-11	Apr-93	0	0.0360		0	0.5													
OH-3	Apr-93	0	0.0360		0	0.5													
W-7	Jan-93	0	0.0360		0	0.5													
W-9A	Jan-93	0	0.0360		0	0.5													
W-9B	Jan-93	0	0.0360		0	0.5													
OH-1	Jan-93	0	0.0360		0	0.5													
OH-2	Jan-93	0	0.0360		0	0.5													
W-10	Jan-93	0	0.0360		0	0.5													
W-11	Jan-93	0	0.0360		0	0.5													
OH-3	Jan-93	0	0.0360		0	0.5													
OH-1	Dec-92	0	0.0360		0	0.5													
W-11	Nov-92	0	0.0360		0	0.6													
OH-3	Nov-92	0	0.0367		0	0.6													
W-7	Oct-92	0	0.0360		0	0.5													
W-1	Oct-92	0	0.0360		0	0.5													
W-2	Oct-92	0	0.0360		0	0.5													
W-3	Oct-92	0	0.0360		0	0.5													
W-5	Oct-92	0	0.0360		0	0.5													
W-9A	Oct-92	0	0.0360		0	0.5													
W-9B	Oct-92	0	0.0360		0	0.5													
W-10	Oct-92	0	0.0360		0	0.5													
W-11	Oct-92	0	0.0360		0	0.5													
W-4	Oct-92	0	0.0360		0	0.5													
W-6	Oct-92	0	0.0360		0	0.5													
OH-1	Oct-92	0	0.0360		0	0.5													
OH-2	Oct-92	0	0.0360		0	0.5													
OH-3	Oct-92	0	0.0360		0	0.5													
OH-2	Oct-92	0	0.0360		0	0.5													
W-1	Sep-92	0	0.0360		0	0.5													
W-6	Sep-92	0	0.0360		0	0.5													
W-4	Sep-92	0	0.0360		0	0.5													
W-9A	Sep-92	0	0.0360		0	0.5													
W-6	Aug-92	0	0.0371		0	0.6													
W-4	Aug-92	0	0.0367		0	0.6													
W-4	Aug-92	0	0.0383		0	0.6													
W-5	Aug-92	0	0.0383		0	0.6													
W-5	Aug-92	0	0.0371		0	0.6													
W-9A	Aug-92	0	0.0360		0	0.5													
W-9B	Aug-92	0	0.0364		0	0.6													
OH-3	Aug-92	0	0.0371		0	0.6													
W-2	Aug-92	0	0.0360		0	0.5													

Appendix A. Groundwater data. Concentrations in micrograms per liter.

Well	Date	Aldrin		alpha-BHC		beta-BHC		delta-BHC		gamma-BHC		Chlordane				
		Sample Result	Reporting Limit	Flag	Sample Result	Reporting Limit	Flag	Sample Result	Reporting Limit	Flag	Sample Result	Reporting Limit	Flag	Sample Result	Reporting Limit	Flag
OH-2	Aug-92	0.148	0.03		0.304	0.03		0.166	0.01							
W-4	Jul-92															0 0.27
W-5	Jul-92															0 1.33
W-6	Jul-92															0 1.33
W-12B	Jul-92															
W-12A	Jul-92															
W-4	May-92															
W-5	May-92															
W-9A	May-92															
OH-1	May-92															
OH-2	May-92															
OH-3	May-92															
W-6	Jan-92															
W-5	Jan-92															
W-9A	Jan-92															
OH-1	Jan-92															
OH-2	Jan-92															
OH-3	Jan-92															
W-1	Oct-91	0 0.01			0 0.01			0 0.02			0 0.01			0 0.01		0 0.05
W-2	Oct-91	0 0.01			0 0.01			0 0.02			0 0.01			0 0.01		0 0.06
W-3	Oct-91	0 0.01			0 0.01			0 0.02			0 0.01			0 0.01		0 0.05
W-4	Oct-91	0 0.01			0 0.01			0 0.02			0 0.01			0 0.01		0 0.06
W-5	Oct-91	0 0.01			0 0.01			0 0.02			0 0.01			0 0.01		0 0.05
W-6	Oct-91	0 0.01			0 0.01			0 0.02			0 0.01			0 0.02		0 0.05
W-7	Oct-91	0 0.01			0 0.01			0 0.02			0 0.01			0 0.01		0 0.05
W-9A	Oct-91	0 0.01			0 0.01			0 0.02			0 0.01			0 0.01		0 0.05
W-9B	Oct-91	0 0.01			0 0.01			0 0.02			0 0.01			0 0.01		0 0.05
W-10	Oct-91	0 0.01			0 0.01			0 0.02			0 0.01			0 0.01		0 0.05
W-11	Oct-91	0 0.01			0 0.01			0 0.02			0 0.01			0 0.01		0 0.05
OH-1	Oct-91	0 0.01			0 0.01			0 0.02			0 0.01			0 0.01		0 0.05
OH-2	Oct-91	0 0.01			0 0.01			0 0.02			0 0.01			0 0.01		0 0.05
OH-3	Oct-91	0 0.01			0 0.01			0 0.02			0 0.01			0 0.01		0 0.05
W-1	Jul-91	0 0.01			0 0.01			0 0.02			0 0.01			0 0.01		0 0.05
W-2	Jul-91	0 0.01			0 0.01			0 0.02			0 0.01			0 0.01		0 0.05
W-3	Jul-91	0 0.01			0 0.01			0 0.02			0 0.01			0 0.01		0 0.05
W-4	Jul-91	0 0.01			0 0.01			0 0.02			0 0.01			0 0.01		0 0.05
W-5	Jul-91	0 0.01			0 0.01			0 0.02			0 0.01			0 0.01		0 0.05
W-6	Jul-91	0 0.01			0 0.01			0 0.02			0 0.01			0 0.01		0 0.05
W-7	Jul-91	0 0.01			0 0.01			0 0.02			0.01 0.01			0 0.01		0 0.05
W-9A	Jul-91	0 0.01			0 0.01			0 0.02			0 0.01			0 0.01		0 0.05
W-9B	Jul-91	0 0.01			0 0.01			0 0.02			0 0.01			0 0.01		0 0.05

Appendix A. Groundwater data. Concentrations in micrograms per liter.

Well	Date	4,4'-DDD		4,4'-DDE		4,4'-DDT		Dieldrin		Endosulfan I		Endosulfan II		Flag		
		Sample Result	Reporting Limit	Flag	Sample Result	Reporting Limit	Flag	Sample Result	Reporting Limit	Flag	Sample Result	Reporting Limit	Flag	Sample Result	Reporting Limit	
OH-2	Aug-92															
W-4	Jul-92										1.63	0.15	J			
W-5	Jul-92										2.11	0.15		1.53	0.19	
W-6	Jul-92										1.27	0.6				
W-12B	Jul-92										4.56	0.3		3.96	0.38	
W-12A	Jul-92										3.28	0.3		3.04	0.38	
W-4	May-92	0	0.02		0	0.01		0	0.02		0.010	0.01		0	0.01	
W-5	May-92	0	0.02		0	0.01		0	0.02		0.010	0.01		0	0.01	
W-9A	May-92	0	0.02		0	0.01		0	0.02		0.010	0.01		0	0.01	
OH-1	May-92	0	0.02		0	0.01		0	0.02		0.020	0.01		0	0.01	
OH-2	May-92	0	0.02		0	0.01		0	0.02		0.030	0.01	B	1.1	0.01	0.34 0.01
OH-3	May-92	0	0.02		0	0.01		0	0.02		0.010	0.01		0.48	0.01	0.16 0.01
W-6	Jan-92	0	0.02		0	0.01		0	0.02		0.010	0.01		0	0.01	
W-5	Jan-92	0	0.02		0	0.01		0	0.02		0.010	0.01		0	0.01	
W-9A	Jan-92	0	0.02		0	0.01		0	0.02		0.010	0.01		0	0.01	
OH-1	Jan-92	0.03	0.02		0	0.01		0.03	0.02		0.020	0.01		0.52	0.01	0.31 0.01
OH-2	Jan-92	0	0.02		0	0.01		0	0.02		0.020	0.01	B	0.04	0.01	B 0.015 0.01
OH-3	Jan-92	0	0.02		0	0.01		0	0.02		0.050	0.01		0.89	0.01	0.27 0.01
W-1	Oct-91	0	0.02		0	0.01		0	0.02		0	0.01		0	0.01	0 0.01
W-2	Oct-91	0	0.02		0	0.02		0	0.02		0	0.01		0	0.01	
W-3	Oct-91	0	0.02		0	0.01		0	0.02		0	0.01		0	0.01	
W-4	Oct-91	0	0.02		0	0.01		0	0.02		0.020	0.01		0	0.01	0.04 0.01
W-5	Oct-91	0	0.02		0	0.01		0	0.02		0	0.01		1.4	0.01	0.61 0.01
W-6	Oct-91	0	0.02		0	0.01		0	0.02		0.010	0.01		0.4	0.01	0.22 0.01
W-7	Oct-91	0	0.02		0	0.01		0	0.02		0.020	0.01		0.08	0.01	0.06 0.01
W-9A	Oct-91	0	0.02		0	0.01		0	0.02		0	0.01		0	0.01	0 0.01
W-9B	Oct-91	0	0.02		0	0.01		0	0.02		0	0.01		0.15	0.01	0.08 0.01
W-10	Oct-91	0	0.02		0	0.01		0	0.02		0	0.01		0.15	0.01	0.08 0.01
W-11	Oct-91	0	0.02		0	0.01		0	0.02		0	0.01		0.12	0.01	0.08 0.01
OH-1	Oct-91	0	0.02		0	0.01		0	0.02		0	0.01		0	0.01	0.02 0.01
OH-2	Oct-91	0	0.02		0	0.01		0	0.02		0.020	0.01		0.02	0.01	0.02 0.01
OH-3	Oct-91	0	0.02		0	0.01		0	0.02		0.010	0.01		1.5	0.01	0.87 0.01
W-1	Jul-91	0.04	0.02		0.02	0.01		0.05	0.02		0	0.01		0.01	0.01	0.02 0.01
W-2	Jul-91	0	0.02		0	0.01		0	0.02		0	0.01		0	0.01	0 0.01
W-3	Jul-91	0	0.02		0	0.01		0	0.02		0.010	0.01		0	0.01	0.02 0.01
W-4	Jul-91	0	0.02		0	0.01		0	0.02		0.020	0.01		0.03	0.01	0.05 0.01
W-5	Jul-91	0	0.02		0	0.01		0	0.02		0	0.01		0.85	0.01	0.49 0.01
W-6	Jul-91	0	0.02		0	0.01		0	0.02		0	0.01		0.2	0.01	0.17 0.01
W-7	Jul-91	0	0.02		0	0.01		0	0.02		0.020	0.01		0.08	0.01	0.08 0.01
W-9A	Jul-91	0	0.02		0	0.01		0	0.02		0	0.01		0	0.01	0 0.01
W-9B	Jul-91	0	0.02		0	0.01		0	0.02		0	0.01		0.1	0.01	0.11 0.01

Appendix A. Groundwater data. Concentrations in micrograms per liter.

Well	Date	Endosulfan sulfate			Endrin		Endrin aldehyde			Endrin Ketone				Heptachlor		Heptachlor Epoxide			
		Sample Result	Reporting Limit	Flag	Sample Result	Reporting Limit	Flag	Sample Result	Reporting Limit	Flag	Sample Result	Reporting Limit	Flag	Sample Result	Reporting Limit	Flag	Sample Result	Reporting Limit	Flag
OH-2	Aug-92																		
W-4	Jul-92																		
W-5	Jul-92	1.33	0.25																
W-6	Jul-92	1.45	0.10																
W-12B	Jul-92	3.27	0.50																
W-12A	Jul-92	2.72	0.50																
W-4	May-92	0	0.02																
W-5	May-92	0	0.02																
W-9A	May-92	0	0.02																
OH-1	May-92	0	0.02																
OH-2	May-92	0.46	0.02																
OH-3	May-92	0.069	0.02																
W-6	Jan-92	0	0.02																
W-5	Jan-92	0	0.02																
W-9A	Jan-92	0	0.02																
OH-1	Jan-92	0.55	0.02																
OH-2	Jan-92	0.14	0.02																
OH-3	Jan-92	0.1	0.02																
W-1	Oct-91	0	0.02		0	0.01					0	0.01		0	0.01		0	0.01	
W-2	Oct-91	0	0.02		0	0.01					0	0.02		0	0.01		0	0.01	
W-3	Oct-91	0.03	0.02		0	0.01					0	0.02		0	0.01		0	0.01	
W-4	Oct-91	0.05	0.02		0.02	0.01					0	0.02		0	0.01		0	0.01	
W-5	Oct-91	0.24	0.02		0.04	0.01					0	0.02		0	0.01		0	0.01	
W-6	Oct-91	0.51	0.02		0.01	0.01					0	0.02		0	0.01		0	0.01	
W-7	Oct-91	0.06	0.02		0	0.01					0	0.02		0	0.01		0	0.01	
W-9A	Oct-91	0	0.02		0	0.01					0	0.02		0	0.01		0	0.01	
W-9B	Oct-91	0.08	0.02		0	0.01					0	0.02		0	0.01		0	0.01	
W-10	Oct-91	0.11	0.02		0	0.01					0	0.02		0	0.01		0	0.01	
W-11	Oct-91	0.06	0.02		0	0.01					0	0.02		0	0.01		0	0.01	
OH-1	Oct-91	0.02	0.02		0	0.01					0	0.02		0	0.01		0	0.01	
OH-2	Oct-91	0.02	0.02		0	0.01					0	0.02		0	0.01		0	0.01	
OH-3	Oct-91	0.48	0.02		0.04	0.01					0	0.02		0	0.01		0	0.01	
W-1	Jul-91	0.03	0.02		0	0.01					0	0.02		0	0.01		0	0.01	
W-2	Jul-91	0	0.02		0	0.01					0	0.02		0	0.02		0	0.01	
W-3	Jul-91	0.04	0.02		0	0.01					0	0.02		0	0.01		0	0.01	
W-4	Jul-91	0.08	0.02		0	0.01					0	0.02		0	0.01		0	0.01	
W-5	Jul-91	0.28	0.02		0.04	0.01					0	0.02		0	0.01		0	0.01	
W-6	Jul-91	0.38	0.02		0	0.01					0	0.02		0	0.01		0	0.01	
W-7	Jul-91	0.08	0.02		0	0.01					0	0.02		0	0.01		0	0.01	
W-9A	Jul-91	0	0.02		0	0.01					0	0.02		0	0.01		0	0.01	
W-9B	Jul-91	0.14	0.02		0	0.01					0	0.02		0	0.01		0	0.01	

Appendix A. Groundwater data. Concentrations in micrograms per liter.

Well	Date	4,4'-Methoxychlor			Toxaphene			Captan			Ovex			Perthane			Dicofol		
		Sample Result	Reporting Limit	Flag	Sample Result	Reporting Limit	Flag	Sample Result	Reporting Limit	Flag	Sample Result	Reporting Limit	Flag	Sample Result	Reporting Limit	Flag	Sample Result	Reporting Limit	Flag
OH-2	Aug-92																		
W-4	Jul-92																		
W-5	Jul-92																		
W-6	Jul-92				0	1.1													
W-12B	Jul-92				0	5.5													
W-12A	Jul-92				0	5.5													
W-4	May-92																		
W-5	May-92																		
W-9A	May-92																		
OH-1	May-92																		
OH-2	May-92																		
OH-3	May-92																		
W-6	Jan-92																		
W-5	Jan-92																		
W-9A	Jan-92																		
OH-1	Jan-92																		
OH-2	Jan-92																		
OH-3	Jan-92																		
W-1	Oct-91	0	0.01		0	0.4		0	0.02		0	0.02					0	0.04	
W-2	Oct-91	0	0.01		0	0.2		0	0.02		0	0.02					0	0.04	
W-3	Oct-91	0	1		0	4.0		0	0.02		0	0.02					0	0.04	
W-4	Oct-91	0	0.01		0	0.4		0	0.02		0	0.02					0	0.04	
W-5	Oct-91	0	0.01		0	0.4		0	0.02		0	0.02					0	0.04	
W-6	Oct-91	0	0.1		0	0.4		0	0.02		0	0.02					0	0.04	
W-7	Oct-91	0	0.1		0	0.4		0	0.02		0	0.02					0	0.04	
W-9A	Oct-91	0	0.1		0	0.4		0	0.02		0	0.02					0	0.04	
W-9B	Oct-91	0	0.1		0	0.4		0	0.02		0	0.02					0	0.04	
W-10	Oct-91	0	0.1		0	0.4		0	0.02		0	0.02					0	0.04	
W-11	Oct-91	0	0.1		0	0.4		0	0.02		0	0.02					0	0.04	
OH-1	Oct-91	0	0.1		0	0.4		0	0.02		0	0.02					0	0.04	
OH-2	Oct-91	0	0.1		0	0.4		0	0.02		0	0.02					0	0.04	
OH-3	Oct-91	0	0.1		0	0.4		0	0.02		0	0.02					0	0.04	
W-1	Jul-91	0	0.1		0	0.4		0	0.04		0	0.10					0	0.04	
W-2	Jul-91	0	0.1		0	0.4		0	0.04		0	0.10					0	0.04	
W-3	Jul-91	0	0.1		0	0.4		0	0.04		0	0.10					0	0.04	
W-4	Jul-91	0	0.1		0	0.4		0	0.04		0	0.10					0	0.04	
W-5	Jul-91	0	0.1		0	0.4		0	0.04		0	0.10					0	0.04	
W-6	Jul-91	0	0.1		0	0.4		0	0.04		0	0.10					0	0.04	
W-7	Jul-91	0	0.1		0	0.4		0	0.04		0	0.10					0	0.04	
W-9A	Jul-91	0	0.1		0	0.4		0	0.04		0	0.10					0	0.04	
W-9B	Jul-91	0	0.1		0	0.4		0	0.04		0	0.10					0	0.04	

Appendix A. Groundwater data. Concentrations in micrograms per liter.

Well	Date	Aldrin		alpha-BHC		beta-BHC		delta-BHC		gamma-BHC		Chlordane	
		Sample Result	Reporting Limit	Flag	Sample Result	Reporting Limit	Flag	Sample Result	Reporting Limit	Flag	Sample Result	Reporting Limit	Flag
W-10	Jul-91	0	0.01		0	0.01		0	0.02		0	0.01	
W-11	Jul-91	0	0.01		0	0.01		0	0.02		0	0.01	
OH-1	Jul-91	0	0.01		0	0.01		0	0.02		0	0.01	
OH-2	Jul-91	0	0.01		0.01	0.01		0	0.02		0.01	0.01	
OH-3	Jul-91	0	0.01		0	0.01		0	0.02		0	0.01	
W-7	Mar-91	0	0.01		0	0.01		0	0.02		0	0.01	
W-9A	Mar-91	0	0.01		0	0.01		0	0.02		0	0.01	
W-9B	Mar-91	0	0.01		0	0.01		0	0.02		0	0.01	
W-10	Mar-91	0	0.01		0	0.01		0	0.02		0	0.01	
W-11	Mar-91	0	0.01		0	0.01		0	0.02		0	0.01	
OH-1	Mar-91	0	0.01		0	0.01		0	0.02		0	0.01	
OH-2	Mar-91	0	0.05		0	0.05		0	0.10		0	0.05	
OH-3	Mar-91	0	0.05		0	0.05		0	0.10		0	0.05	
W-2	Dec-90	0	0.01		0	0.01		0	0.02		0	0.01	
OH-2	Dec-90	0	0.10		0	0.10		0	0.20		0	0.10	
W-1	Nov-90	0	0.01		0	0.01		0	0.02		0	0.01	
W-3	Nov-90	0	0.01		0	0.01		0	0.02		0	0.01	
W-4	Nov-90	0	0.01		0	0.01		0	0.02		0	0.01	
W-5	Nov-90	0	0.01		0	0.01		0	0.02		0	0.01	
W-6	Nov-90	0	0.01		0	0.01		0	0.02		0	0.01	
W-7	Nov-90	0	0.01		0	0.01		0	0.02		0	0.01	
W-9A	Nov-90	0	0.01		0	0.01		0	0.02		0	0.01	
W-9B	Nov-90	0	0.01		0	0.01		0	0.02		0	0.01	
W-10	Nov-90	0	0.02		0	0.01		0	0.02		0	0.01	
W-11	Nov-90	0	0.01		0	0.01		0	0.02		0	0.01	
OH-1	Nov-90	0	0.01		0	0.01		0	0.02		0	0.01	
OH-3	Nov-90	0	0.01		0	0.01		0	0.02		0	0.01	
W-1	Aug-90	0	0.01		0	0.01		0	0.02		0	0.01	
W-2	Aug-90	0	0.01		0	0.01		0	0.02		0	0.01	
W-3	Aug-90	0	0.01		0	0.01		0	0.02		0	0.01	
W-4	Aug-90	0	0.01		0.02	0.01		0.03	0.02		0.06	0.01	
W-5	Aug-90	0	0.01		0	0.01		0	0.02		0	0.01	
W-6	Aug-90	0	0.01		0	0.01		0	0.02		0	0.01	
W-7	Aug-90	0	0.01		0	0.01		0	0.02		0.01	0.01	
W-9A	Aug-90	0	0.01		0	0.01		0	0.02		0	0.01	
W-9B	Aug-90	0	0.01		0	0.01		0	0.02		0	0.01	
W-10	Aug-90	0	0.02		0	0.01		0	0.02		0	0.01	
W-11	Aug-90	0	0.01		0	0.01		0	0.02		0	0.01	
OH-1	Aug-90	0	0.01		0	0.01		0	0.02		0	0.01	
OH-2	Aug-90	0	0.01		0.04	0.01		0.03	0.02		0.1	0.01	
OH-3	Aug-90	0	0.01		0	0.01		0	0.02		0	0.01	

Appendix A. Groundwater data. Concentrations in micrograms per liter.

Well	Date	4,4'-DDD		4,4'-DDE		4,4'-DDT		Dieldrin		Endosulfan I			Endosulfan II			
		Sample Result	Reporting Limit	Flag	Sample Result	Reporting Limit	Flag	Sample Result	Reporting Limit	Flag	Sample Result	Reporting Limit	Flag	Sample Result	Reporting Limit	Flag
W-10	Jul-91	0	0.02		0	0.01		0	0.02		0	0.01		0.06	0.01	
W-11	Jul-91	0	0.02		0	0.01		0	0.02		0	0.01		0.08	0.01	
OH-1	Jul-91	0	0.02		0	0.01		0	0.02		0	0.01		0	0.01	
OH-2	Jul-91	0	0.02		0	0.01		0	0.02		0.020	0.01		0.05	0.01	
OH-3	Jul-91	0	0.02		0	0.01		0	0.02		0	0.01		0.8	0.01	J
W-7	Mar-91	0	0.02		0	0.01		0	0.01		0.090	0.01		0.04	0.01	
W-9A	Mar-91	0	0.02		0	0.01		0	0.02		0	0.01		0.02	0.01	
W-9B	Mar-91	0	0.02		0	0.01		0	0.02		0	0.01		0.06	0.01	
W-10	Mar-91	0	0.02		0	0.01		0	0.02		0	0.01		0.07	0.01	
W-11	Mar-91	0	0.02		0	0.01		0.02	0.02		0	0.01		0.16	0.01	
OH-1	Mar-91	0	0.02		0	0.01		0	0.02		0	0.01		0.02	0.01	
OH-2	Mar-91	0	0.1		0	0.05		0	0.1		0	0.05		0.17	0.01	
OH-3	Mar-91	0	0.1		0	0.05		0	0.1		0	0.05		0.19	0.01	
W-2	Dec-90	0	0.02		0	0.01		0	0.02		0	0.01		0	0.1	
OH-2	Dec-90	0	0.2		0	0.10		0	0.2		0.010	0.01		0.62	0.01	
W-1	Nov-90	0	0.02		0	0.01		0	0.02		0	0.01		0	0.1	
W-3	Nov-90	0	0.02		0	0.01		0	0.02		0	0.01		0.37	0.01	
W-4	Nov-90	0	0.02		0	0.01		0	0.02		0.020	0.01		0.55	0.01	
W-5	Nov-90	0	0.02		0	0.01		0	0.02		0	0.01		0.31	0.01	
W-6	Nov-90	0	0.02		0	0.01		0	0.02		0	0.01		0.77	0.01	
W-7	Nov-90	0	0.02		0	0.01		0	0.02		0.010	0.01		0.12	0.01	
W-9A	Nov-90	0	0.02		0	0.01		0	0.02		0	0.01		0	0.01	
W-9B	Nov-90	0	0.02		0	0.01		0	0.02		0	0.01		0	0.01	
W-10	Nov-90	0	0.02		0	0.01		0	0.02		0	0.01		0.13	0.01	
W-11	Nov-90	0	0.02		0	0.01		0	0.02		0	0.01		0.05	0.01	
OH-1	Nov-90	0	0.02		0	0.01		0	0.02		0	0.01		0.31	0.01	
OH-3	Nov-90	0	0.02		0	0.01		0	0.02		0	0.01		0.67	0.01	
W-1	Aug-90	0	0.02		0	0.01		0	0.02		0	0.01		0	0.1	
W-2	Aug-90	0.04	0.02		0.04	0.01		0.09	0.02		0	0.01		0	0.01	
W-3	Aug-90	0	0.02		0	0.01		0	0.02		0	0.01		0	0.01	
W-4	Aug-90	0.03	0.02		0.09	0.01		0	0.02		0	0.01		0	0.01	
W-5	Aug-90	0	0.02		0	0.01		0	0.02		0	0.01		0.56	0.01	
W-6	Aug-90	0	0.02		0	0.01		0	0.02		0.020	0.01		0.12	0.01	
W-7	Aug-90	0	0.02		0	0.01		0	0.02		0.030	0.01		0.1	0.01	
W-9A	Aug-90	0	0.02		0	0.01		0	0.02		0	0.01		0	0.01	
W-9B	Aug-90	0	0.02		0	0.01		0	0.02		0	0.01		0.37	0.01	
W-10	Aug-90	0	0.02		0	0.01		0	0.02		0	0.01		0.11	0.01	
W-11	Aug-90	0	0.02		0	0.01		0	0.02		0.020	0.01		0.08	0.01	
OH-1	Aug-90	0	0.02		0.01	0.01		0.04	0.02		0.010	0.01		0	0.01	
OH-2	Aug-90	0.02	0.02		0.11	0.01		0.23	0.02		0.110	0.01		0.13	0.01	
OH-3	Aug-90	0	0.02		0	0.01		0	0.02		0	0.01		0.53	0.01	
														0.38	0.01	

Appendix A. Groundwater data. Concentrations in micrograms per liter.

Well	Date	Endosulfan sulfate		Endrin		Endrin aldehyde		Endrin Ketone		Heptachlor		Heptachlor Epoxide					
		Sample Result	Reporting Limit	Flag	Sample Result	Reporting Limit	Flag	Sample Result	Reporting Limit	Flag	Sample Result	Reporting Limit	Flag	Sample Result	Reporting Limit	Flag	
W-10	Jul-91	0.05	0.01		0	0.01			0	0.02		0	0.01		0	0.01	
W-11	Jul-91	0.05	0.01		0	0.01			0	0.02		0	0.01		0	0.01	
OH-1	Jul-91	0	0.05		0	0.01			0	0.05		0	0.01		0	0.01	
OH-2	Jul-91	0.16	0.05		0	0.01			0	0.05		0	0.01		0	0.01	
OH-3	Jul-91	0.55	0.05		0.03	0.01			0	0.05		0	0.01		0	0.01	
W-7	Mar-91	0	0.01		0	0.02			0	0.02		0	0.01		0	0.01	
W-9A	Mar-91	0	0.02		0	0.01			0	0.02		0	0.01		0	0.01	
W-9B	Mar-91	0	0.02		0	0.01			0	0.02		0	0.01		0	0.01	
W-10	Mar-91	0.02	0.01		0	0.01			0	0.02		0	0.01		0	0.01	
W-11	Mar-91	0.02	0.01		0	0.01			0	0.02		0	0.01		0	0.01	
OH-1	Mar-91	0.02	0.05	NQ	0	0.01			0	0.02		0	0.01		0	0.01	
OH-2	Mar-91	0	0.10		0	0.05			0	0.10		0	0.05		0	0.05	
OH-3	Mar-91	0	0.10		0	0.05			0	0.10		0	0.05		0	0.05	
W-2	Dec-90	0	0.02		0	0.01			0	0.02		0	0.01		0	0.01	
OH-2	Dec-90	0.38	0.05		0	0.01			0	0.02		0	0.01		0	0.01	
W-1	Nov-90	0	0.02		0	0.01			0	0.02		0	0.01		0	0.01	
W-3	Nov-90	0.31	0.02		0	0.01			0	0.02		0	0.01		0	0.01	
W-4	Nov-90	0.29	0.02		0.01	0.01			0	0.02		0	0.01		0	0.01	
W-5	Nov-90	0.11	0.02		0	0.20			0	0.05		0	0.02		0	0.01	
W-6	Nov-90	0.26	0.02		0	0.01			0	0.02		0	0.01		0	0.01	
W-7	Nov-90	0.07	0.02		0.01	0.01			0	0.02		0	0.01		0	0.01	
W-9A	Nov-90	0	0.02		0	0.01			0	0.02		0	0.01		0	0.01	
W-9B	Nov-90	0	0.02		0	0.01			0	0.02		0	0.01		0	0.01	
W-10	Nov-90	0.06	0.01		0	0.01			0	0.02		0	0.01		0	0.01	
W-11	Nov-90	0.11	0.01		0.02	0.02			0	0.02		0	0.01		0	0.01	
OH-1	Nov-90	0.25	0.05		0	0.01			0	0.02		0	0.01		0	0.01	
OH-3	Nov-90	0.11	0.05		0	0.01			0	0.02		0	0.01		0	0.01	
W-1	Aug-90	0	0.02		0	0.01			0	0.02		0	0.01		0	0.01	
W-2	Aug-90	0.03	0.02		0	0.01			0	0.02		0	0.01		0	0.01	
W-3	Aug-90	0.02	0.02		0	0.01			0	0.02		0	0.01		0	0.01	
W-4	Aug-90	0.06	0.02		0	0.01			0	0.02		0	0.01		0	0.01	
W-5	Aug-90	0.39	0.02		0.01	0.01			0	0.02		0	0.01		0	0.01	
W-6	Aug-90	0.3	0.02		0	0.01			0	0.02		0	0.01		0	0.01	
W-7	Aug-90	0.08	0.02		0	0.01			0	0.02		0	0.01		0	0.01	
W-9A	Aug-90	0	0.02		0	0.01			0	0.02		0	0.01		0	0.01	
W-9B	Aug-90	0.08	0.02		0	0.01			0	0.02		0	0.01		0	0.01	
W-10	Aug-90	0.06	0.01		0	0.01			0	0.02		0	0.01		0	0.01	
W-11	Aug-90	0.1	0.01		0	0.01			0	0.02		0	0.01		0	0.01	
OH-1	Aug-90	0.02	0.05		0	0.01			0	0.02		0	0.01		0	0.01	
OH-2	Aug-90	0.12	0.05		0	0.01			0	0.02		0	0.01		0	0.01	
OH-3	Aug-90	0.36	0.05		0	0.01			0	0.02		0	0.01		0	0.01	

Appendix A. Groundwater data. Concentrations in micrograms per liter.

Well	Date	4,4'-Methoxychlor			Toxaphene			Ccaptan			Ovex			Perthane			Dicofol		
		Sample Result	Reporting Limit	Flag	Sample Result	Reporting Limit	Flag	Sample Result	Reporting Limit	Flag	Sample Result	Reporting Limit	Flag	Sample Result	Reporting Limit	Flag	Sample Result	Reporting Limit	Flag
W-10	Jul-91	0	0.1		0	0.4		0	0.04		0	0.10					0	0.04	
W-11	Jul-91	0	0.1		0	0.4		0	0.04		0	0.10					0	0.04	
OH-1	Jul-91	0	0.1		0	0.4		0	0.04		0	0.10					0	0.04	
OH-2	Jul-91	0	0.1		0	0.4		0	0.04		0	0.10					0	0.04	
OH-3	Jul-91	0	0.1		0	0.4		0	0.04		0	0.10					0	0.04	
W-7	Mar-91	0	0.1		0	0.4		0	0.08		0	0.12					0	0.08	
W-9A	Mar-91	0	0.1		0	0.4		0	0.08		0	0.12					0	0.04	
W-9B	Mar-91	0	0.1		0	0.4		0	0.08		0	0.12					0	0.04	
W-10	Mar-91	0	0.1		0	0.4		0	0.08		0	0.12					0	0.04	
W-11	Mar-91	0	0.1		0	0.4		0	0.08		0	0.02					0	0.04	
OH-1	Mar-91	0	0.1		0	0.4		0	0.08		0	0.12					0	0.04	
OH-2	Mar-91	0	0.5		2	0.4		0.4	0.02		0.6	0.02					0.2	0.04	
OH-3	Mar-91	0	0.5		2	0.4		0.4	0.04		0.6	0.02					0.2	0.04	
W-2	Dec-90	0	0.1		0	0.4		0	0.08		0	0.12					0	0.08	
OH-2	Dec-90	0	0.1		0	0.4		0	0.08		0	0.12					0	0.08	
W-1	Nov-90	0	0.1		0	0.4		0	0.08		0	0.12					0	0.08	
W-3	Nov-90	0	0.1		0	0.4		0	0.08		0	0.12					0	0.08	
W-4	Nov-90	0	0.1		0	0.4		0	0.08		0	0.12					0	0.08	
W-5	Nov-90	0	0.01		0	0.1		0	0.08		0	0.12					0	0.08	
W-6	Nov-90	0	0.1		0	0.4		0	0.08		0	0.12					0	0.08	
W-7	Nov-90	0	0.1		0	0.4		0	0.08		0	0.12					0	0.08	
W-9A	Nov-90	0	0.1		0	0.4		0	0.08		0	0.12					0	0.08	
W-9B	Nov-90	0	0.1		0	0.4		0	0.08		0	0.12					0	0.08	
W-10	Nov-90	0	0.1		0	0.4		0	0.08		0	0.12					0	0.08	
W-11	Nov-90	0	0.1		0	0.4		0	0.08		0	0.12					0	0.08	
OH-1	Nov-90	0	0.1		0	0.4		0	0.08		0	0.12					0	0.08	
OH-3	Nov-90	0	0.1		0	0.4		0	0.08		0	0.12					0	0.08	
W-1	Aug-90	0	0.1		0	0.4		0	0.02		0	0.20					0	0.40	
W-2	Aug-90	0	0.1		0	0.4		0	0.02		0.14	0.02					0	0.04	
W-3	Aug-90	0	0.1		0	0.4		0	0.02		0	0.02					0	0.04	
W-4	Aug-90	0	0.1		0	0.4		0	0.02		0.3	0.02					0	0.04	
W-5	Aug-90	0	0.1		0	0.4		0	0.02		0.2	0.02					0	0.04	
W-6	Aug-90	0	0.1		0	0.4		0	0.02		0.23	0.02					0	0.04	
W-7	Aug-90	0	0.1		0	0.4		0	0.02		0.06	0.02					0	0.04	
W-9A	Aug-90	0	0.1		0	0.4		0	0.02		0.02	0.02					0	0.04	
W-9B	Aug-90	0	0.1		0	0.4		0	0.02		0	0.02					0	0.04	
W-10	Aug-90	0	0.1		0	0.4		0	0.02		0.03	0.02					0	0.04	
W-11	Aug-90	0	0.1		0	0.4		0	0.02		0.03	0.02					0	0.04	
OH-1	Aug-90	0	0.1		0	0.4		0	0.02		0	0.06					0	0.04	
OH-2	Aug-90	0	0.1		0	0.4		0	0.02		0	0.29					0	0.04	
OH-3	Aug-90	0	0.1		0	0.4		0	0.02		0	0.02					0	0.04	

Appendix A. Groundwater data. Concentrations in micrograms per liter.

Well	Date		Aldrin		alpha-BHC		beta-BHC		delta-BHC		gamma-BHC		Chlordane					
		Sample Result	Reporting Limit	Flag	Sample Result	Reporting Limit	Flag	Sample Result	Reporting Limit	Flag	Sample Result	Reporting Limit	Flag	Sample Result	Reporting Limit	Flag		
W-1	May-90	0	0.01		0	0.01		0	0.02		0	0.01		0	0.01			
W-2	May-90	0	0.01		0	0.01		0	0.02		0	0.01		0	0.01			
W-3	May-90	0	0.01		0	0.01		0	0.02		0	0.01		0	0.01			
W-4	May-90	0	0.01		0	0.01		0	0.02		0	0.01		0	0.01			
W-5	May-90	0	0.01		0	0.01		0	0.02		0	0.01		0	0.01			
W-6	May-90	0	0.01		0	0.01		0	0.02		0	0.01		0	0.01			
W-7	May-90	0	0.01		0	0.01		0	0.02		0	0.01		0	0.01			
W-10	May-90	0	0.01		0	0.01		0	0.02		0	0.01		0	0.01			
OH-1	May-90	0	0.01		0	0.01		0	0.02		0	0.01		0	0.01			
OH-2	May-90	0	0.01		0	0.01		0	0.02		0	0.01		0	0.01			
OH-3	May-90	0	0.01		0	0.01		0	0.02		0	0.01		0	0.01			
W-1	Dec-89	0	0.01		0	0.01		0	0.02		0	0.01				0	0.05	
W-2	Dec-89	0	0.01		0	0.01		0	0.02		0	0.01				0	0.05	
W-3	Dec-89	0	0.01		0	0.01		0	0.02		0	0.01				0	0.05	
W-4	Dec-89	0	0.01		0	0.01		0	0.02		0	0.01				0	0.05	
W-5	Dec-89	0	0.01		0	0.01		0	0.02		0	0.01				0	0.05	
W-6	Dec-89	0	0.01		0	0.01		0	0.02		0	0.01				0	0.05	
W-7	Dec-89	0	0.01		0	0.01		0	0.02		0	0.01				0	0.05	
OH-1	Dec-89	0	0.01		0	0.01		0	0.02		0	0.01				0	0.05	
OH-2	Dec-89	0	0.01		0	0.01		0	0.02		0.02	0.01	UJ			0	0.05	
OH-3	Dec-89	0	0.01		0	0.01		0	0.02		0	0.01				0	0.05	
W-1	Sep-89	0	0.01		0	0.01		0	0.01		0	0.01		0	0.01		0	0.05
W-2	Sep-89	0	0.01		0	0.01		0	0.01		0	0.01		0	0.01		0	0.05
W-3	Sep-89	0	0.01		0	0.01		0	0.01		0	0.01		0	0.01		0	0.05
W-4	Sep-89	0	0.01		0	0.01		0	0.01		0	0.01		0	0.01		0	0.05
W-5	Sep-89	0	0.01		0	0.01		0	0.01		0	0.01		0	0.01		0	0.05
W-6	Sep-89	0	0.01		0	0.01		0	0.01		0	0.01		0	0.01		0	0.05
W-7	Sep-89	0	0.01		0	0.01		0	0.01		0	0.01		0	0.01		0	0.05
OH-1	Sep-89	0	0.01		0	0.01		0	0.01		0	0.01		0	0.01		0	0.05
OH-2	Sep-89	0	0.01		0.06	0.01		0.07	0.07		0.23	0.01		0	0.01		0	0.50
OH-3	Sep-89	0	0.01		0	0.01		0	0.01		0	0.01		0	0.01		0	0.05
W-1	Jun-89	0	0.01		0	0.01		0	0.02		0	0.01		0	0.01		0	0.05
W-2	Jun-89	0	0.01		0	0.01		0	0.02		0	0.01		0	0.01		0	0.05
W-3	Jun-89	0	0.01		0	0.01		0	0.02		0	0.01		0	0.01		0	0.05
W-4	Jun-89	0	0.01		0	0.01		0	0.02		0	0.01		0	0.01		0	0.05
W-5	Jun-89	0	0.01		0	0.01		0	0.02		0.02	0.01		0	0.01		0	0.05
W-6	Jun-89	0	0.01		0	0.01		0	0.02		0.01	0.01		0	0.01		0	0.05
W-7	Jun-89	0	0.01		0.01	0.01		0.02	0.02		0.04	0.01		0	0.01		0	0.05
OH-3	Jun-89	0	0.01		0	0.01		0	0.02		0	0.01		0	0.01		0	0.05
OH-1	Jan-89	0.01	0.01		0	0.02		0	0.02					0.01	0.01		0	0.05
OH-2	Jan-89	0	0.01		0	0.01		0	0.02					0	0.01		0	0.05

Appendix A. Groundwater data. Concentrations in micrograms per liter.

Well	Date	4,4'-DDD			4,4'-DDE			4,4'-DDT			Dieldrin			Endosulfan I			Endosulfan II		
		Sample Result	Reporting Limit	Flag															
W-1	May-90	0	0.02		0	0.01		0	0.02		0	0.01		0	0.01		0	0.01	
W-2	May-90	0	0.02		0.015	0.01		0	0.02		0	0.01		0	0.01		0	0.01	
W-3	May-90	0	0.02		0	0.01		0	0.02		0	0.01		0.02	0.01		0	0.01	
W-4	May-90	0.15	0.02		0.06	0.01		0	0.08		0	0.04		0.32	0.01		0.2	0.01	
W-5	May-90	0	0.02		0	0.01		0	0.02		0	0.01		0.4	0.01		0.2	0.01	
W-6	May-90	0	0.02		0	0.01		0	0.02		0	0.01		0.4	0.01		0.2	0.01	
W-7	May-90	0	0.02		0	0.01		0	0.02		0	0.01		0.07	0.01		0.03	0.01	
W-10	May-90	0	0.02		0	0.01		0	0.02		0	0.01		0.2	0.01		0.6	0.01	
OH-1	May-90	0	0.02		0	0.01		0.03	0.02		0	0.01		0.04	0.01		0.05	0.01	
OH-2	May-90	0	0.02		0	0.01		0.03	0.02		0	0.01		0.15	0.01		0.1	0.01	
OH-3	May-90	0	0.02		0	0.01		0	0.02		0	0.01		0.6	0.01		0.25	0.01	
W-1	Dec-89	0	0.02		0	0.01		0	0.02		0	0.01		0	0.01		0	0.01	
W-2	Dec-89	0.04	0.02		0.04	0.01		0.06	0.02		0	0.01		0	0.01		0	0.01	
W-3	Dec-89	0.02	0.02		0	0.01		0	0.02		0	0.01		0.18	0.01		0.16	0.01	
W-4	Dec-89	0	0.02		0	0.01		0	0.02		0	0.01		0.43	0.01		0.41	0.01	
W-5	Dec-89	0	0.02		0	0.01		0	0.02		0	0.01		0.19	0.01		0.21	0.01	
W-6	Dec-89	0	0.02		0	0.01		0	0.02		0	0.01		0.52	0.01		0.5	0.01	
W-7	Dec-89	0	0.02		0	0.01		0	0.02		0	0.01		0.15	0.01		0.15	0.01	
OH-1	Dec-89	0	0.02		0	0.01		0	0.02		0	0.01		0.29	0.01	J	0.53	0.01	J
OH-2	Dec-89	0	0.02		0	0.01		0.03	0.02	UJ	0	0.01		0	0.01		0	0.32	
OH-3	Dec-89	0	0.02		0	0.01		0	0.02		0	0.01		0.39	0.01		0.39	0.01	
W-1	Sep-89	0	0.02		0	0.01		0	0.02		0	0.01		0	0.01		0	0.01	
W-2	Sep-89	0.02	0.02		0.01	0.01		0.04	0.02		0	0.01		0	0.01		0	0.01	
W-3	Sep-89	0	0.02		0	0.01		0	0.02		0	0.01		0	0.01		0	0.01	
W-4	Sep-89	0	0.02		0.03	0.01		0.02	0.02		0.020	0.01		0.02	0.01		0	0.01	
W-5	Sep-89	0	0.02		0	0.03		0	0.02		0	0.02		0.36	0.01		0.18	0.01	
W-6	Sep-89	0	0.02		0	0.01		0	0.02		0	0.01		0.09	0.01		0.06	0.01	
W-7	Sep-89	0	0.02		0	0.01		0	0.02		0	0.01		0.02	0.01		0.01	0.01	
OH-1	Sep-89	0	0.02		0.01	0.01		0.04	0.02		0	0.01		0	0.01		0	0.01	
OH-2	Sep-89	0	0.02		0	0.01		0.04	0.02		0.090	0.01		0.07	0.01		0	0.01	
OH-3	Sep-89	0	0.02		0	0.01		0	0.02		0.0	0.01		0.3	0.01		0.2	0.01	
W-1	Jun-89	0	0.02		0	0.01		0	0.2		0.0	0.01		0	0.01		0	0.01	
W-2	Jun-89	0.03	0.02		0.03	0.01		0.11	0.02		0.020	0.01		0.03	0.01		0.04	0.01	
W-3	Jun-89	0	0.02		0	0.01		0	0.02		0	0.01		0	0.01		0	0.01	
W-4	Jun-89	0	0.02		0	0.01		0	0.02		0	0.01		0	0.01		0	0.01	
W-5	Jun-89	0	0.02		0	0.01		0	0.02		0	0.01		0.12	0.01		0.07	0.01	
W-6	Jun-89	0	0.02		0	0.01		0	0.02		0	0.01		0.05	0.01		0.03	0.01	
W-7	Jun-89	0	0.02		0	0.01		0	0.02		0.010	0.01		0.05	0.01		0.02	0.01	
OH-3	Jun-89	0	0.02		0	0.01		0.02	0.02		0	0.01		0.05	0.01		0.03	0.01	
OH-1	Jan-89	0.02	0.02		0.04	0.01		0.3	0.02		0.020	0.01		0	0.05		0.05	0.01	
OH-2	Jan-89	0	0.02		0.01	0.01		0.02	0.02		0	0.01		0.08	0.01		0.06	0.01	

Appendix A. Groundwater data. Concentrations in micrograms per liter.

Well	Date	Endosulfan sulfate			Endrin			Endrin aldehyde			Endrin Ketone			Heptachlor			Heptachlor Epoxide			
		Sample Result	Reporting Limit	Flag	Sample Result	Reporting Limit	Flag	Sample Result	Reporting Limit	Flag	Sample Result	Reporting Limit	Flag	Sample Result	Reporting Limit	Flag	Sample Result	Reporting Limit	Flag	
W-1	May-90	0	0.05		0	0.01					0	0.02		0	0.01		0	0.01		
W-2	May-90	0	0.05		0	0.01					0	0.02		0	0.01		0	0.01		
W-3	May-90	0.06	0.02		0	0.01					0	0.02		0	0.01		0	0.01		
W-4	May-90	0.25	0.02		0	0.01					0	0.02		0	0.01		0	0.01		
W-5	May-90	0	0.02		0	0.05					0	0.02		0	0.01		0	0.01		
W-6	May-90	0.2	0.02		0	0.01					0	0.02		0	0.01		0	0.01		
W-7	May-90	0	0.05		0	0.01					0	0.02		0	0.01		0	0.01		
W-10	May-90	0	0.05		0	0.01					0	0.02		0	0.01		0	0.01		
OH-1	May-90	0.13	0.05		0	0.01					0	0.02		0	0.01		0	0.01		
OH-2	May-90	0.3	0.05		0	0.01					0	0.02		0	0.01		0	0.01		
OH-3	May-90	0	0.05		0	0.10					0	0.02		0	0.01		0	0.01		
W-1	Dec-89	0	0.02		0	0.01					0	0.02		0	0.01		0	0.01		
W-2	Dec-89	0	0.02		0	0.01					0	0.02		0	0.01		0	0.01		
W-3	Dec-89	0.5	0.02		0	0.01					0	0.02		0	0.01		0	0.01		
W-4	Dec-89	0.44	0.02		0	0.01					0	0.02		0	0.01		0	0.01		
W-5	Dec-89	0.1	0.02		0	0.01					0	0.02		0	0.01		0	0.01		
W-6	Dec-89	0.28	0.02		0	0.01					0	0.02		0	0.01		0	0.01		
W-7	Dec-89	0.18	0.02		0	0.01					0	0.02		0	0.01		0	0.01		
OH-1	Dec-89	0.56	0.05	J	0	0.01					0	0.02		0	0.01		0	0.01		
OH-2	Dec-89	0	0.49		0	0.01					0	0.02		0	0.01		0	0.01		
OH-3	Dec-89	0.12	0.05		0	0.01					0	0.02		0	0.01		0	0.01		
W-1	Sep-89	0	0.02		0	0.01					0	0.01		0	0.01		0	0.01		
W-2	Sep-89	0	0.02		0	0.01					0	0.01		0	0.01		0	0.01		
W-3	Sep-89	0	0.02		0	0.01					0	0.01		0	0.01		0	0.01		
W-4	Sep-89	0	0.02		0	0.01					0	0.01		0	0.01		0	0.01		
W-5	Sep-89	0.08	0.02		0.02	0.02					0	0.01		0	0.01		0	0.01		
W-6	Sep-89	0.09	0.02		0	0.01					0	0.01		0	0.01		0	0.01		
W-7	Sep-89	0	0.01		0	0.01					0	0.01		0	0.01		0	0.01		
OH-1	Sep-89	0	0.05		0	0.01					0	0.01		0	0.01		0	0.01		
OH-2	Sep-89	0.02	0.05		0	0.01					0	0.01		0	0.01		0	0.01		
OH-3	Sep-89	0.1	0.05		0	0.01					0	0.01		0	0.01		0	0.01		
W-1	Jun-89	0	0.05		0	0.01					0	0.02		0	0.01		0	0.01		
W-2	Jun-89	0	0.05		0	0.01					0	0.02		0	0.01		0	0.01		
W-3	Jun-89	0	0.05		0	0.01					0	0.02		0	0.01		0	0.01		
W-4	Jun-89	0	0.05		0	0.01					0	0.02		0	0.01		0	0.01		
W-5	Jun-89	0.12	0.02		0	0.01					0	0.02		0	0.01		0	0.01		
W-6	Jun-89	0.07	0.02		0	0.01					0	0.02		0	0.01		0	0.01		
W-7	Jun-89	0.05	0.02		0	0.01					0	0.02		0	0.01		0	0.01		
OH-3	Jun-89	0.05	0.05		0	0.01					0	0.02		0	0.01		0	0.01		
OH-1	Jan-89	0.12	0.05		0	0.10					0	0.02		0	0.01		0	0.01		
OH-2	Jan-89	0.17	0.05		0	0.10					0	0.02		0	0.01		0	0.01		

Appendix A. Groundwater data. Concentrations in micrograms per liter.

Well	Date	4,4'-Methoxychlor			Toxaphene			Captan			Ovex			Perthane			Dicofol		
		Sample Result	Reporting Limit	Flag	Sample Result	Reporting Limit	Flag	Sample Result	Reporting Limit	Flag	Sample Result	Reporting Limit	Flag	Sample Result	Reporting Limit	Flag	Sample Result	Reporting Limit	Flag
W-1	May-90	0	0.1		0	0.4		0	0.02		0	0.02							
W-2	May-90	0	0.1		0	0.4		0	0.02		0	0.02							
W-3	May-90	0	0.1		0	0.4		0	0.02		0	0.02							
W-4	May-90	0	0.1		0	0.4		0	0.02		0	0.08							
W-5	May-90	0	0.1		0	0.4		0	0.02		0	0.10							
W-6	May-90	0	0.1		0	0.4		0	0.02		0	0.02							
W-7	May-90	0	0.1		0	0.4		0	0.02		0	0.02							
W-10	May-90	0	0.1		0	0.4		0	0.02		0	0.04							
OH-1	May-90	0	0.1		0	0.4		0	0.02		0	0.02							
OH-2	May-90	0	0.1		0	0.4		0	0.02		0	0.04							
OH-3	May-90	0	0.1		0	0.4		0	0.02		0	0.20							
W-1	Dec-89	0	0.1		0	0.4		0	0.02		0	0.02					0	0.04	
W-2	Dec-89	0	0.1		0	0.4		0	0.02		0	0.02					0	0.04	
W-3	Dec-89	0	0.1		0	0.4		0	0.02		0	0.02					0	0.04	
W-4	Dec-89	0	0.1		0	0.4		0	0.02		0	0.02					0	0.04	
W-5	Dec-89	0	0.1		0	0.4		0	0.02		0	0.02					0	0.04	
W-6	Dec-89	0	0.1		0	0.4		0	0.02		0	0.02					0	0.04	
W-7	Dec-89	0	0.01		0	0.4		0	0.02		0	0.02					0	0.04	
OH-1	Dec-89	0	0.1		0	0.4		0	0.02		0	0.02					0	0.04	
OH-2	Dec-89	0	0.1		0	0.4		0	0.02		0	0.02					0	0.04	
OH-3	Dec-89	0	0.1		0	0.4		0	0.02		0	0.02					0	0.04	
W-1	Sep-89	0	0.05		0	0.4		0	0.02		0	0.02					0	0.04	
W-2	Sep-89	0	0.05		0	0.4		0	0.02		0	0.02					0	0.04	
W-3	Sep-89	0	0.05		0	0.4		0	0.02		0	0.02					0	0.04	
W-4	Sep-89	0	0.03		0	0.4		0	0.02		0	0.02					0	0.04	
W-5	Sep-89	0	0.05		0	0.4		0	0.02		0	0.02					0	0.04	
W-6	Sep-89	0	0.05		0	0.4		0	0.02		0	0.02					0	0.04	
W-7	Sep-89	0	0.05		0	0.4		0	0.02		0	0.02					0	0.04	
OH-1	Sep-89	0	0.05		0	0.4		0	0.02		0	0.02					0	0.04	
OH-2	Sep-89	0	0.5		0	0.4		0	0.02		0	0.02					0	0.04	
OH-3	Sep-89	0	0.05		0	0.4		0	0.02		0	0.02					0	0.04	
W-1	Jun-89	0	0.05		0	0.4		0	0.02		0	0.02					0	0.04	
W-2	Jun-89	0	0.05		0	0.4		0	0.02		0.06	0.02					0	0.04	
W-3	Jun-89	0	0.05		0	0.4		0	0.02		0.02	0.02					0	0.04	
W-4	Jun-89	0	0.05		0	0.4		0	0.02		0	0.02					0	0.04	
W-5	Jun-89	0	0.05					0	0.02		0	0.02					0	0.04	
W-6	Jun-89	0	0.05		0	0.4		0	0.02		0.02	0.02					0	0.04	
W-7	Jun-89	0	0.05		0	0.4		0	0.02		0.02	0.02					0	0.04	
OH-3	Jun-89	0	0.05		0	0.4		0	0.02		0.02	0.02					0	0.04	
OH-1	Jan-89	0	0.05		0	0.4		0	0.04		0.25	0.02					0	0.04	
OH-2	Jan-89	0	0.05		0	0.4		0	0.04		0	0.08					0	0.04	

## Appendix A. Groundwater data. Concentrations in micrograms per liter.




**NOTE:** A zero in the Sample Results Column signifies that the result was not detected above the analytical detection limit.

**Flags:** **J:** Indicates an estimated value

P: Analyte detected, RPD>2%


NQ: Not detected above the PQL

R: The data are unusable (rejected) for all purposes.


B: Historical data - best available copy is not clear and

**Appendix B**

100% 100%

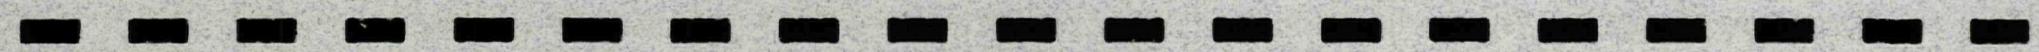

**APPENDIX B**

 


***BORING LOGS AND MONITORING WELL AS-BUILTS***

**ERM-WEST**

Environmental Resources Management

**FMC - Yakima****Job #2672.03****Drilling Log**

Project Former Pesticide Facility Location Yakima, WA  
 Owner FMC Project Number 2672.03  
 Well/Boring No. B-1 Total Depth \_\_\_\_\_ Diameter 10"  
 Surface Elevation \_\_\_\_\_ Water Level: Initial \_\_\_\_\_ Ref. Pt. \_\_\_\_\_  
 Screen: Dia. \_\_\_\_\_ Length \_\_\_\_\_ Slot Size \_\_\_\_\_  
 Casing: Dia. \_\_\_\_\_ Length \_\_\_\_\_ Type \_\_\_\_\_  
 Drilling Company Cascade Drilling  
 Driller Rodney La Brosse Log by AMA Date Drilled 08/24/95

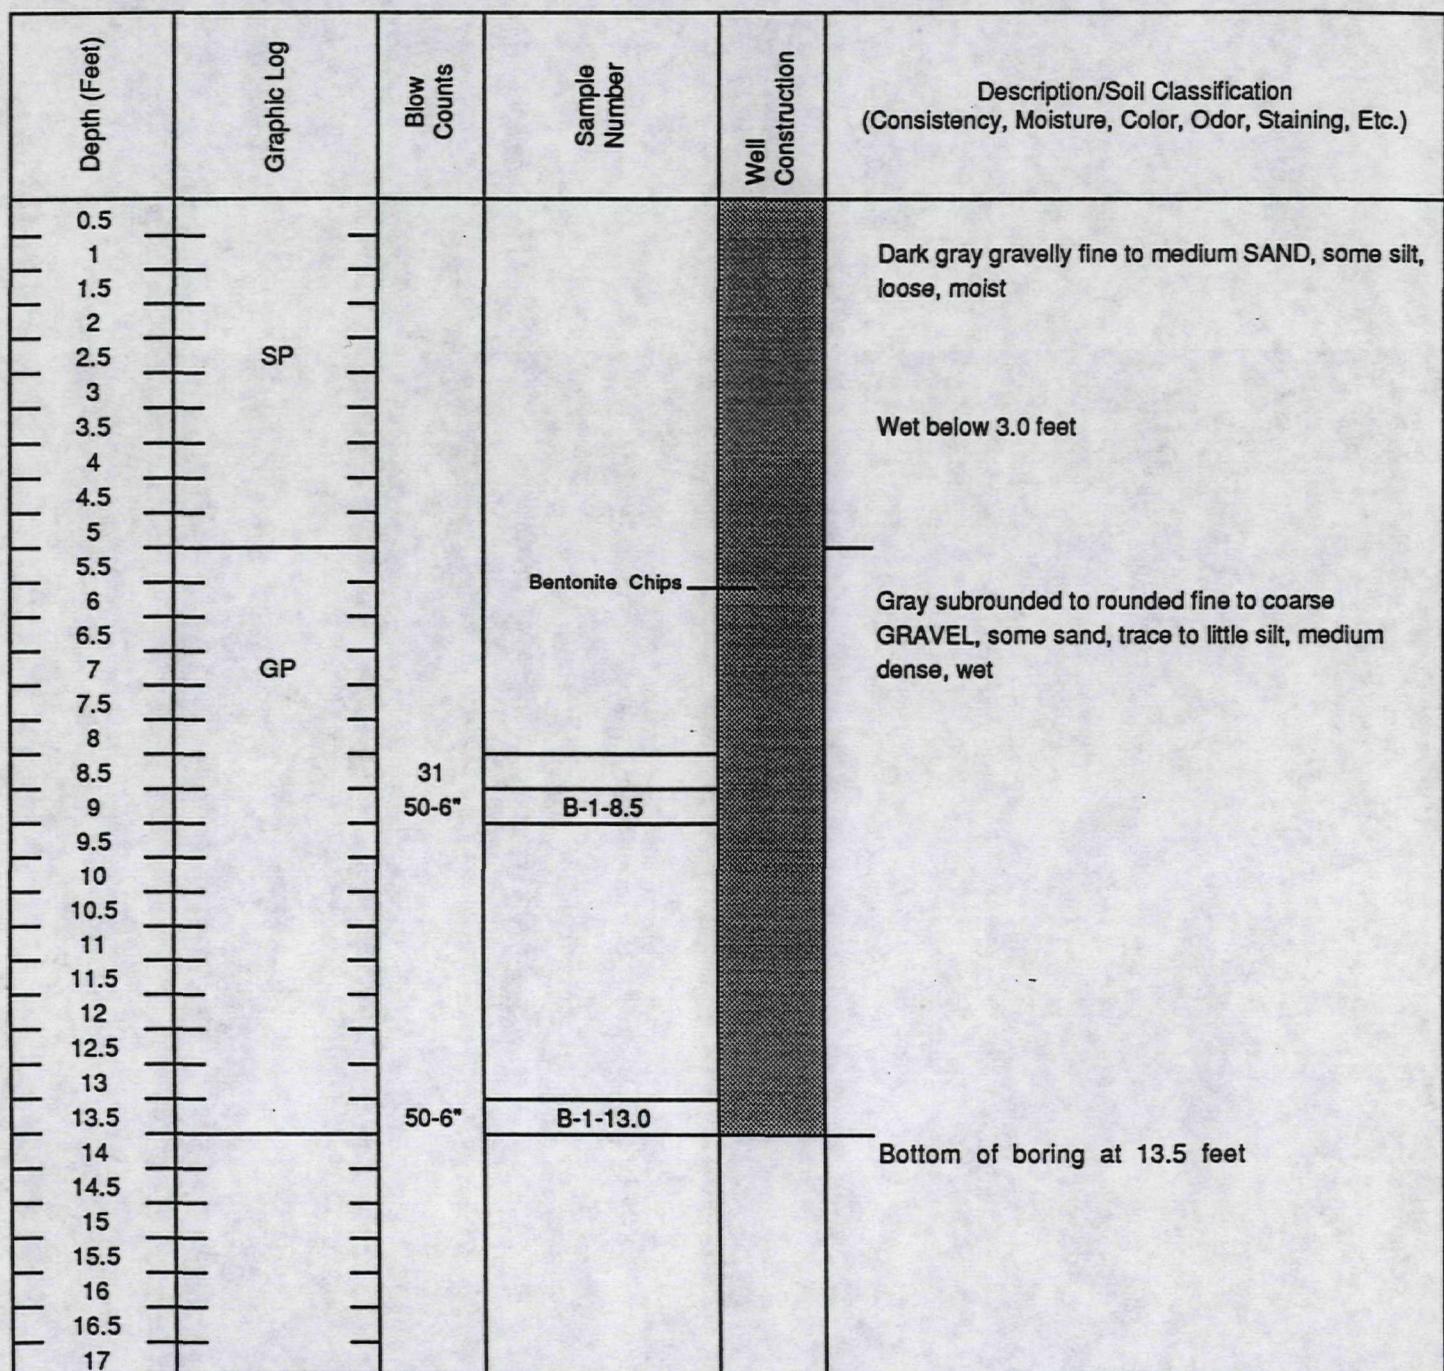**Sketch Map****Notes**

**ERM-WEST**


Environmental Resources Management

**FMC - Yakima**  
**Job #2672.03**  
**Drilling Log**

Project Former Pesticide Facility Location Yakima, WA  
 Owner FMC Project Number 2672.03  
 Well/Boring No. B-2 Total Depth \_\_\_\_\_ Diameter 10"  
 Surface Elevation \_\_\_\_\_ Water Level: Initial \_\_\_\_\_ Ref. Pt. \_\_\_\_\_  
 Screen: Dia. \_\_\_\_\_ Length \_\_\_\_\_ Slot Size \_\_\_\_\_  
 Casing: Dia. \_\_\_\_\_ Length \_\_\_\_\_ Type \_\_\_\_\_  
 Drilling Company Cascade Drilling  
 Driller Rodney La Brosse Log by AMA Date Drilled 08/24/95

Sketch Map

Notes

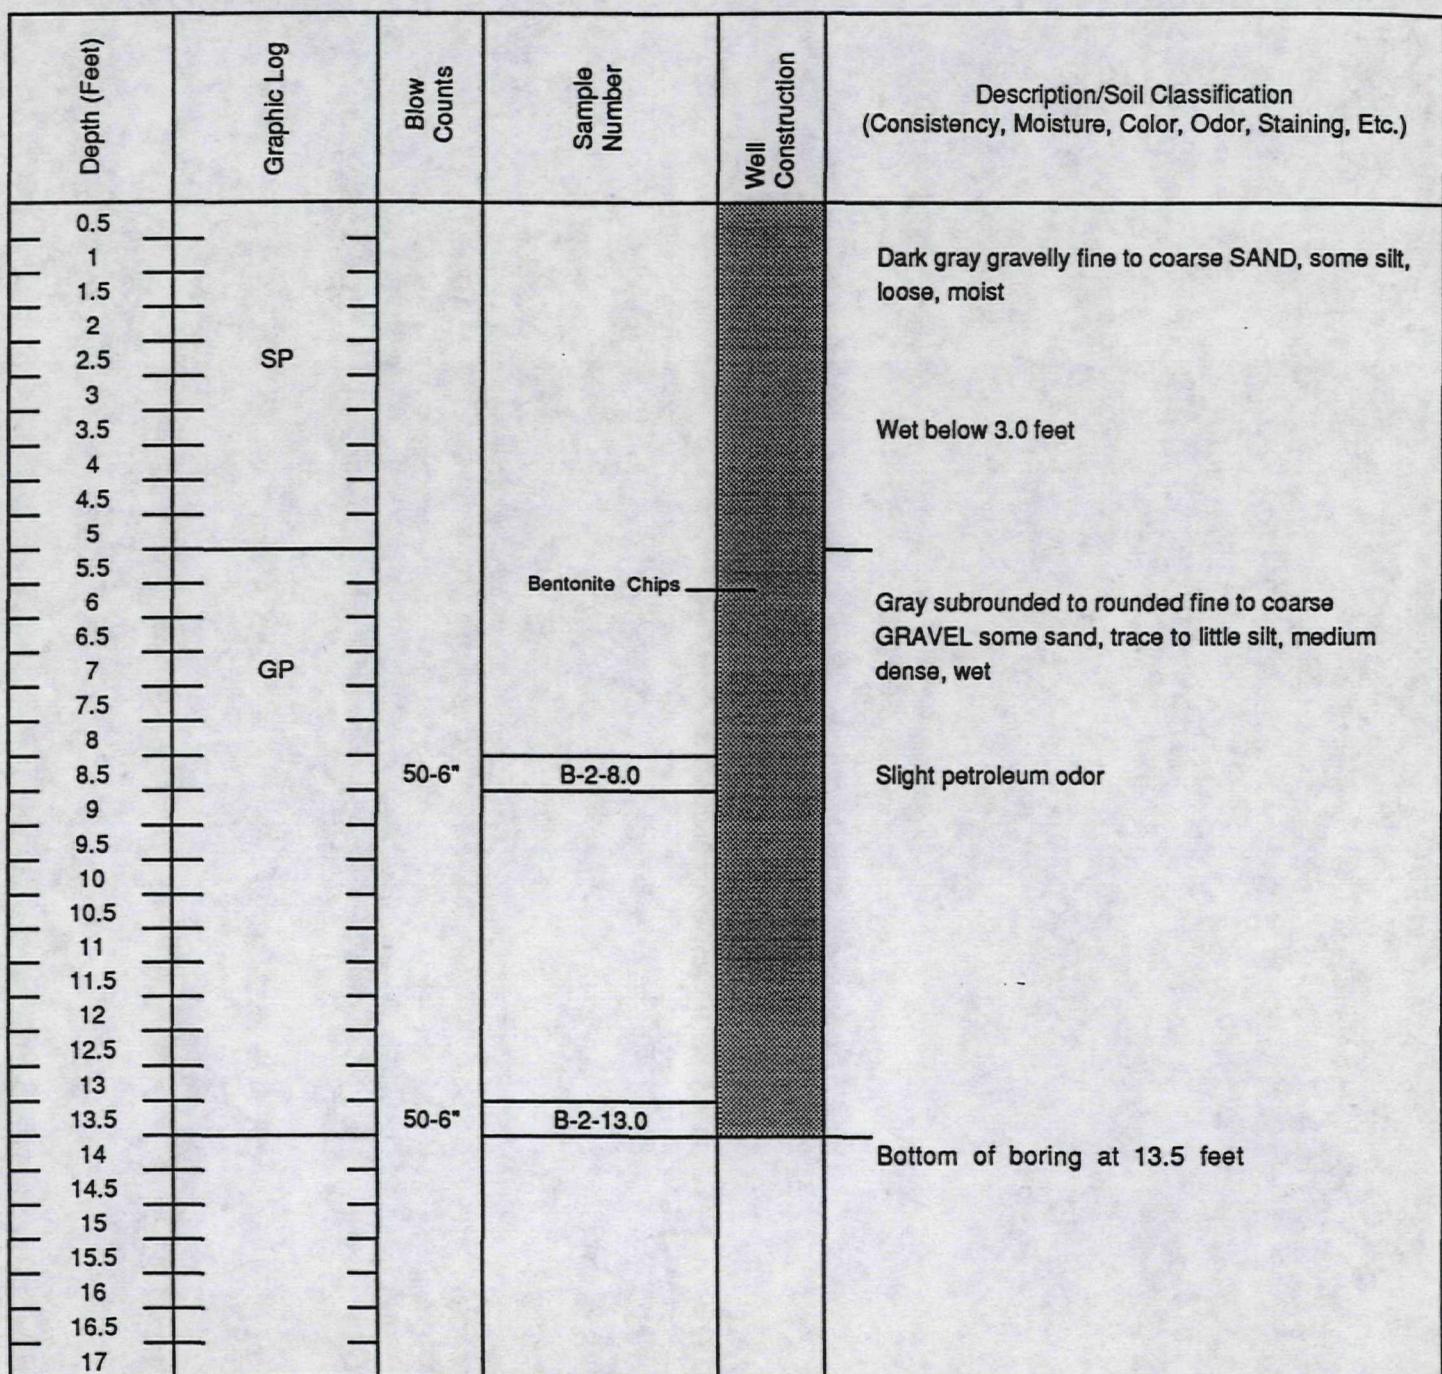



# OBSERVATION WELL


## PROJECT

FMC - YAKIMA

WELL NO.

V-1

NO.	SITE	COORDINATES	
19888	UPLAND INDUSTRIES	N 9898.113 E 11005.769	
EGUN	COMPLETED	PREPARED BY	REFERENCE POINT FOR MEASUREMENTS
11/14/87	11/14/87	R. BISIO	TOP OF RISER PIPE

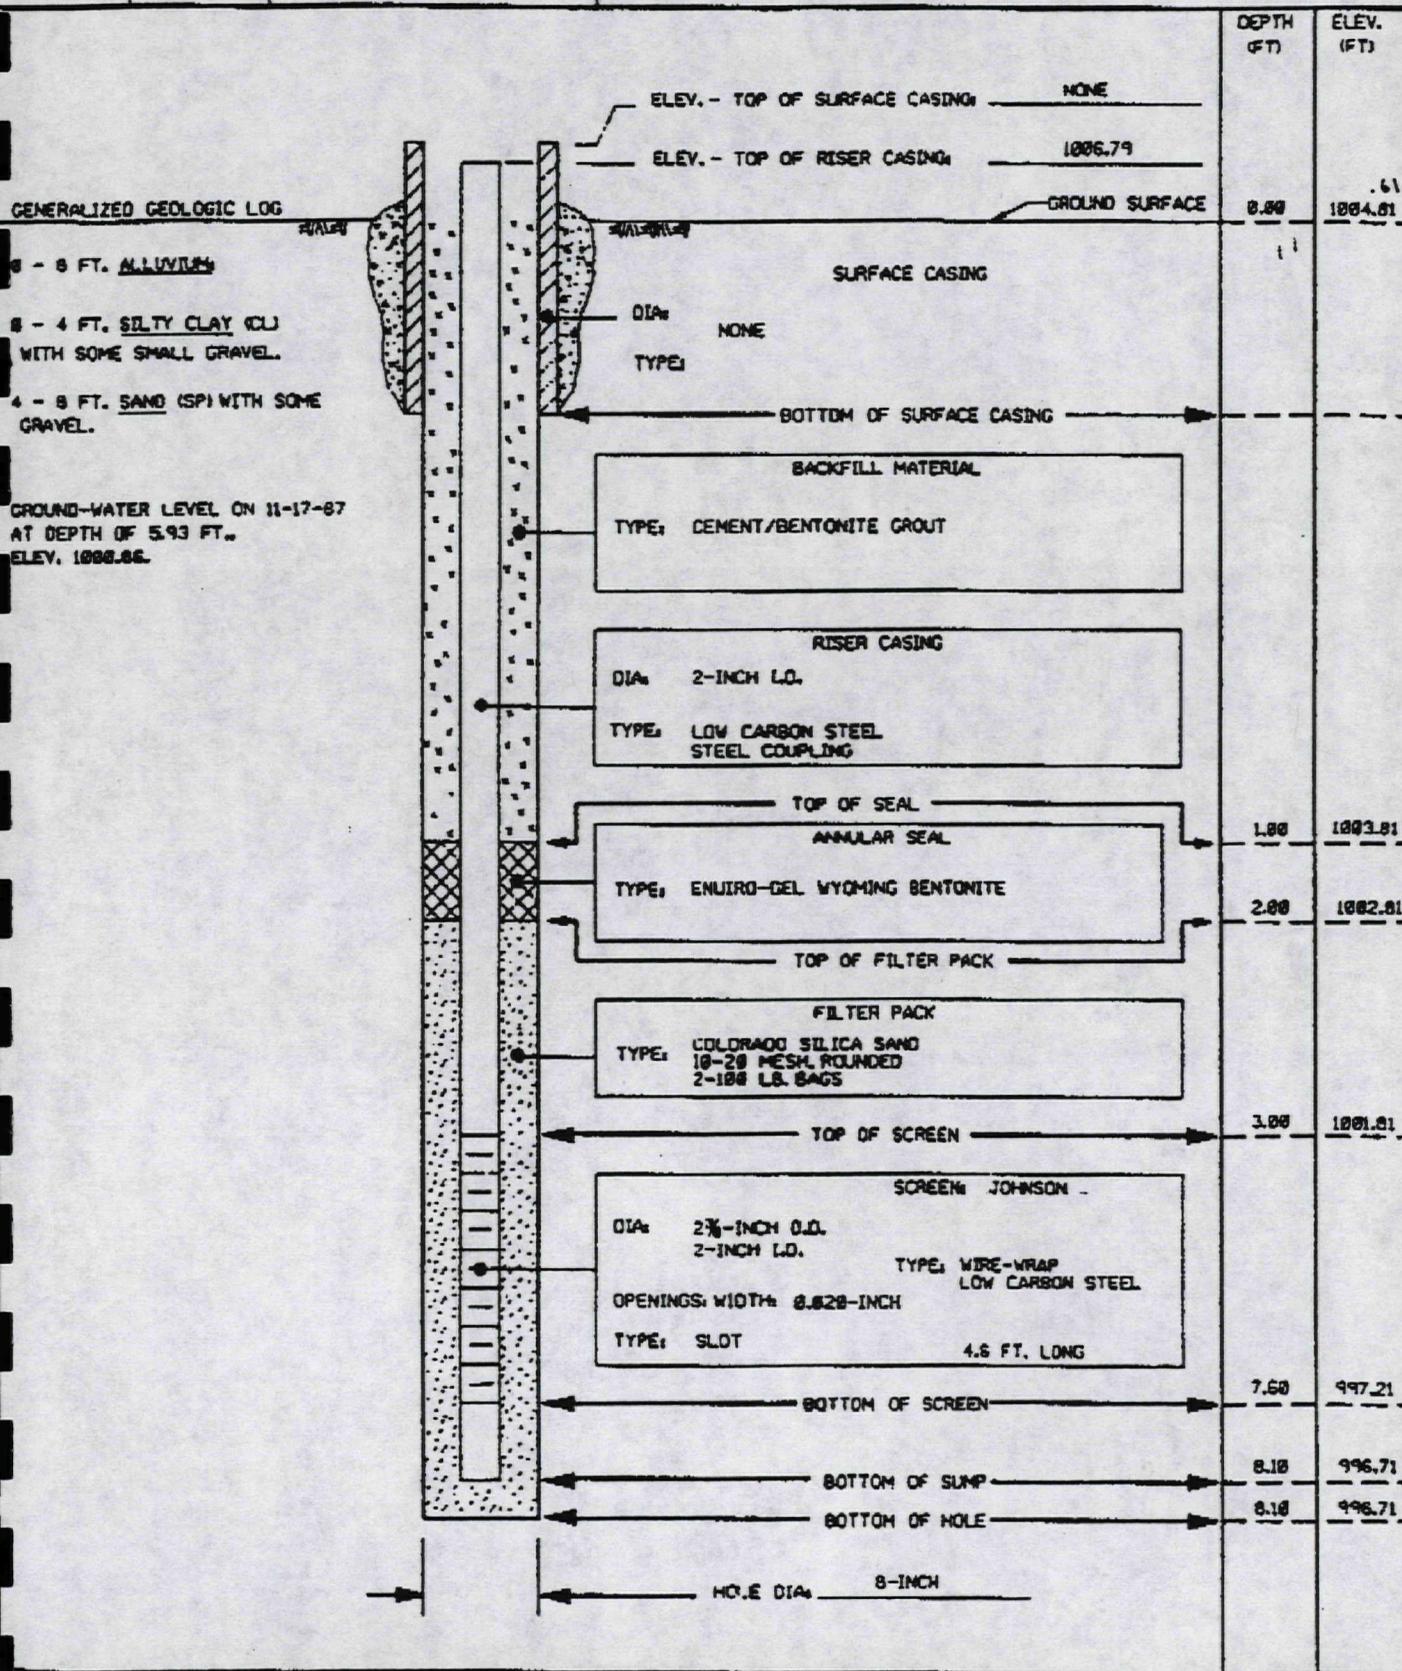



# OBSERVATION WELL

## PROJECT

FMC - YAKIMA

## WELL NO.

V-2

JOB NO.	SITE	COORDINATES	
BEGUN	COMPLETED	PREPARED BY	REFERENCE POINT FOR MEASUREMENTS
11/13/87	11/13/87	R. SISIO	TOP OF RISER CASING
			DEPTH (FT) ELEV. (FT)
		ELEV. - TOP OF SURFACE CASING: NONE	
		ELEV. - TOP OF RISER CASING: 1886.51	
GENERALIZED GEOLOGIC LOG		GROUND SURFACE	1884.38
8 - 2 FT. FILL, SAND AND GRAVEL			
2 - 8 FT. ALLUVIUM			
SANDY GRAVEL (GPM COBBLES TO 8-INCH DIAMETER, LOOSE)			
ATTEMPTED TO DRIVE WELL POINT BUT SCREEN DAMAGED AT 2.8 FT. CHANGED TO CABLE TOOL METHOD TO DRILL BORING.			
GROUND-WATER LEVEL ON 11-17-87 AT DEPTH OF 6.38 FT. ELEV. 1880.21			
		SURFACE CASING	
		DIA: NONE	
		TYPE:	
		BOTTOM OF SURFACE CASING	
		BACKFILL MATERIAL	
		TYPE: CEMENT/BENTONITE GROUT	
		RISER CASING	
		DIA: 2-INCH I.D.	
		TYPE: LOW CARBON STEEL STEEL COUPLING	
		TOP OF SEAL	
		ANNULAR SEAL	
		TYPE: ENVIRO-GEL WYOMING BENTONITE	
		TOP OF FILTER PACK	
		FILTER PACK	
		TYPE: COLORADO SILICA SAND 2 SACKS, 100 LB. EACH 18 TO 20 MESH, ROUNDED	
		TOP OF SCREEN	
		SCREEN: JOHNSON	
		DIA: 2 1/2-INCH O.D. 2-INCH I.D.	
		TYPE: WIRE-WRAP LOW CARBON STEEL	
		OPENINGS: WIDTH: 0.826-INCH	
		TYPE: SLOT	
		4.6 FT. LONG	
		BOTTOM OF SCREEN	
		7.50	996.88
		BOTTOM OF SUMP	
		8.00	996.38
		BOTTOM OF HOLE	
		8.00	996.38
		HOLE DIA: 8-INCH	

## RESOURCE PROTECTION WELL REPORT

START CARD NO. A12190

PROJECT NAME: F.M.C.  
 WELL IDENTIFICATION NO. n/a w-2  
 DRILLING METHOD: *st*  
 DRILLER: Rooney LaBrosse  
 DRILLING CONTRACTOR: Cascade Drilling, Inc.  
 SIGNATURE: *Rodney LaBrosse*  
 CONSULTING FIRM: ERM  
 REPRESENTATIVE: MIKE ARNOLD

COUNTY: Yakima  
 LOCATION NE 1/4 SW 1/4 Sec. 31 Twp 13N R 19E  
 STREET ADDRESS OF WELL: 4 WEST WASHINGTON AVE - YAKIMA  
 WATER LEVEL ELEVATION: N/A  
 GROUND SURFACE ELEVATION: N/A  
 INSTALLED: 8-24-95  
 DEVELOPED: *o*

533+

AS-BUILT

WELL DATA

FORMATION DESCRIPTION

abandonment  
clipped in place  
CONCRETE SURFACE SEAL

0 - 15 ft.  
clipped in place


BACKFILL

Bentchys

ft.

ft.

RECEIVE

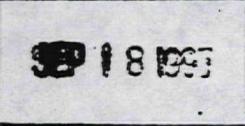DEPARTMENT OF ENERGY  
CENTRAL REGION

DEPTH OF BORING 15"

SCALE: \_\_\_\_\_

PAGE \_\_\_\_\_ OF \_\_\_\_\_

ECY 052-12 (Rev 11/94)

TOTAL F.05



# OBSERVATION WELL

## PROJECT

FMC - YAKIMA

WELL NO.

W-3

JOB NO. 19888	SITE UPLAND INDUSTRIES	COORDINATES N 9672.652 E 11292.898	
BEGUN 11/13/87	COMPLETED 11/13/87	PREPARED BY R. SISIO	REFERENCE POINT FOR MEASUREMENTS TOP OF RISER CASING

**GENERALIZED GEOLOGIC LOG**

ELEV. - TOP OF SURFACE CASING	DEPTH (FT)	ELEV. (FT)
NONE		
ELEV. - TOP OF RISER CASING 1086.23	8.88	1083.85
GROUND SURFACE		
SURFACE CASING		
DIA: NONE		
TYPE: CEMENT/BENTONITE GROUT		
BOTTOM OF SURFACE CASING		
BACKFILL MATERIAL		
RISER CASING		
DIA: 2-INCH I.D.		
TYPE: LOW CARBON STEEL STEEL COUPLING		
TOP OF SEAL	1.88	1082.85
ANNULAR SEAL		
TYPE: ENVIRO-GEL WYOMING BENTONITE		
TOP OF FILTER PACK	2.88	1081.85
FILTER PACK		
TYPE: COLORADO SILICA SAND 16-28 MESH, ROUNDED		
TOP OF SCREEN	2.98	1080.95
SCREEN: JOHNSON		
DIA: 2 1/2-INCH O.D. 2-INCH I.D.		
OPENINGS: WIDTH: 0.828-INCH		
TYPE: WIRE-WRAP LOW CARBON STEEL		
TYPE: SLOT		
4.5 FT. LONG		
BOTTOM OF SCREEN	7.58	995.35
BOTTOM OF SUMP	8.88	995.85
BOTTOM OF HOLE	8.88	995.85
HOLE DIA: 3-INCH		

GROUND-WATER LEVEL ON 11-17-87  
AT DEPTH OF 6.18 FT.  
ELEV. 1086.13.

## RESOURCE PROTECTION WELL REPORT

START CARD NO. A 12190


(4)

PROJECT NAME: F.M.C.  
 WELL IDENTIFICATION NO. n/a W-3  
 DRILLING METHOD: HSA  
 DRILLER: ROONEY LABROSSE  
 FIRM: Cascade Drilling, Inc.  
 SIGNATURE: Rodney Labrosse  
 CONSULTING FIRM: ERM  
 REPRESENTATIVE: MIKE ARNOLD

COUNTY: Yakima  
 LOCATION: NE 1/4 SW 1/4 Sec. 31 Twp 13 N R 19 E  
 STREET ADDRESS OF WELL: 4 WEST WASHINGTON AVE - YAKIMA  
 WATER LEVEL ELEVATION: N/A  
 GROUND SURFACE ELEVATION: N/A  
 INSTALLED: 8-24-95  
 DEVELOPED: 0

S334


AS-BUILT

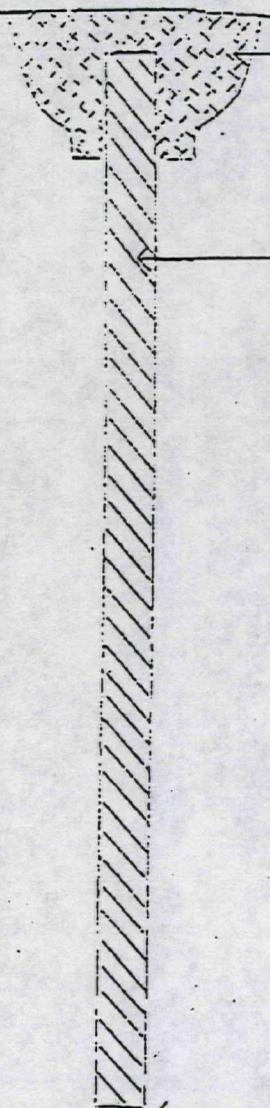

WELL DATA	
<i>Well abandonment</i>	
CONCRETE SURFACE SEAL	
BACKFILL	
<i>Bent chgs</i>	
DEPTH OF BORING <u>81"</u>	

FORMATION DESCRIPTION

0 - 8'  
*Bent chgs*

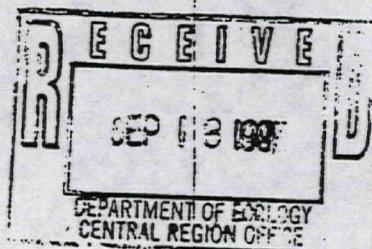ft.ft.

## OBSERVATION WELL

## PROJECT

FMC - YAKIMA


WELL NO.

W-4

NO.	SITE	COORDINATES
19888	UPLAND INDUSTRIES	N 9688.675 E 11227.688
BEGUN	COMPLETED	PREPARED BY
11/14/87	11/14/87	R. BISIO

## REFERENCE POINT FOR MEASUREMENTS

TOP OF RISER PIPE

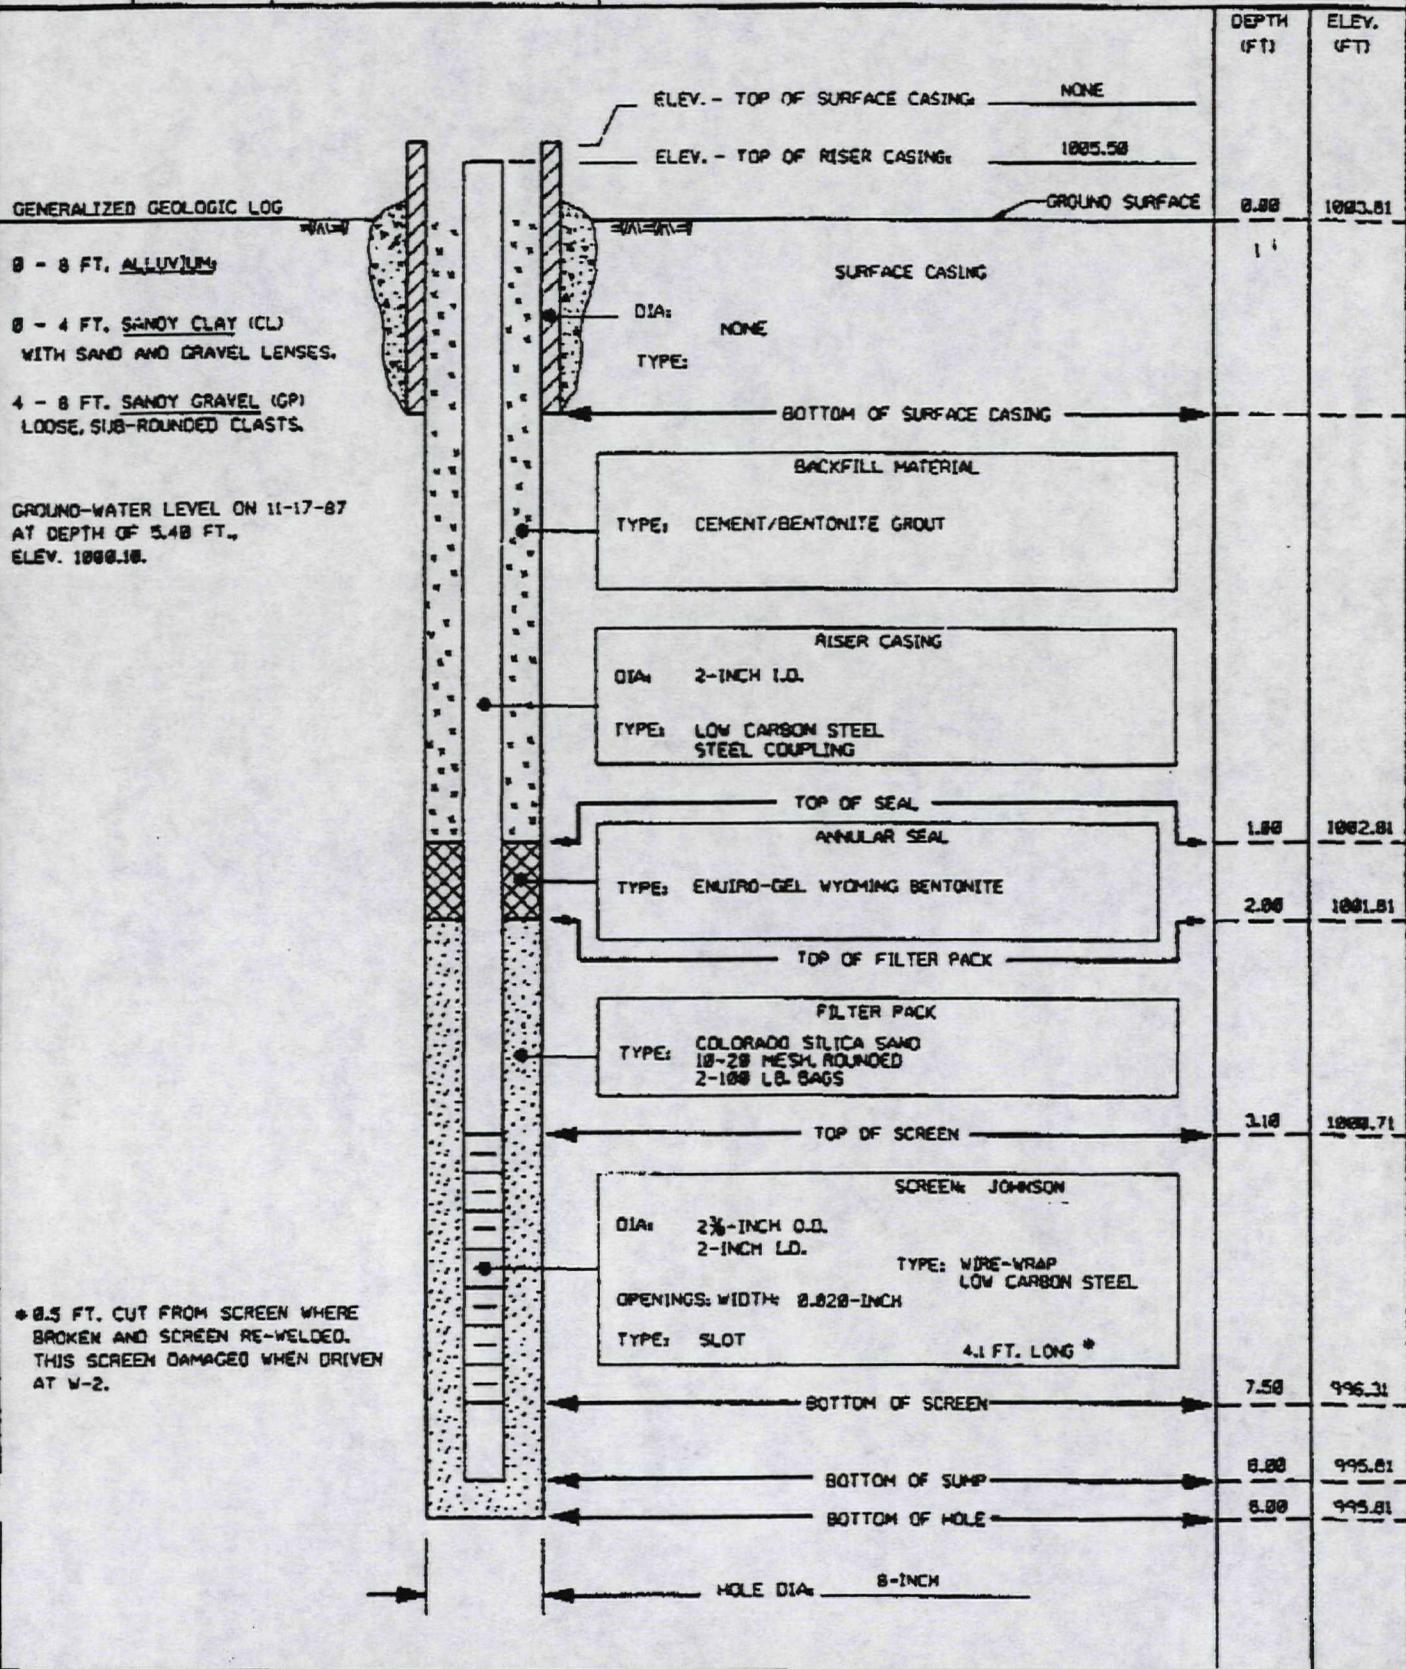


## PROJECT

FMC - YAKIMA

WELL NO.

W-5

JOB NO. 19888	SITE UPLAND INDUSTRIES	COORDINATES N 4596.268 E 11278.129	
BEGUN 11/14/87	COMPLETED 11/14/87	PREPARED BY R. BISIO	REFERENCE POINT FOR MEASUREMENTS TOP OF RISER CASING

			DEPTH (FT)
			ELEV. (FT)



# OBSERVATION WELL


PROJECT

FMC - YAKIMA

WELL NO.

V-6

BEGUN 11/14/87	COMPLETED 11/14/87	PREPARED BY R. BISIO REFERENCE POINT FOR MEASUREMENTS TOP OF RISER CASING

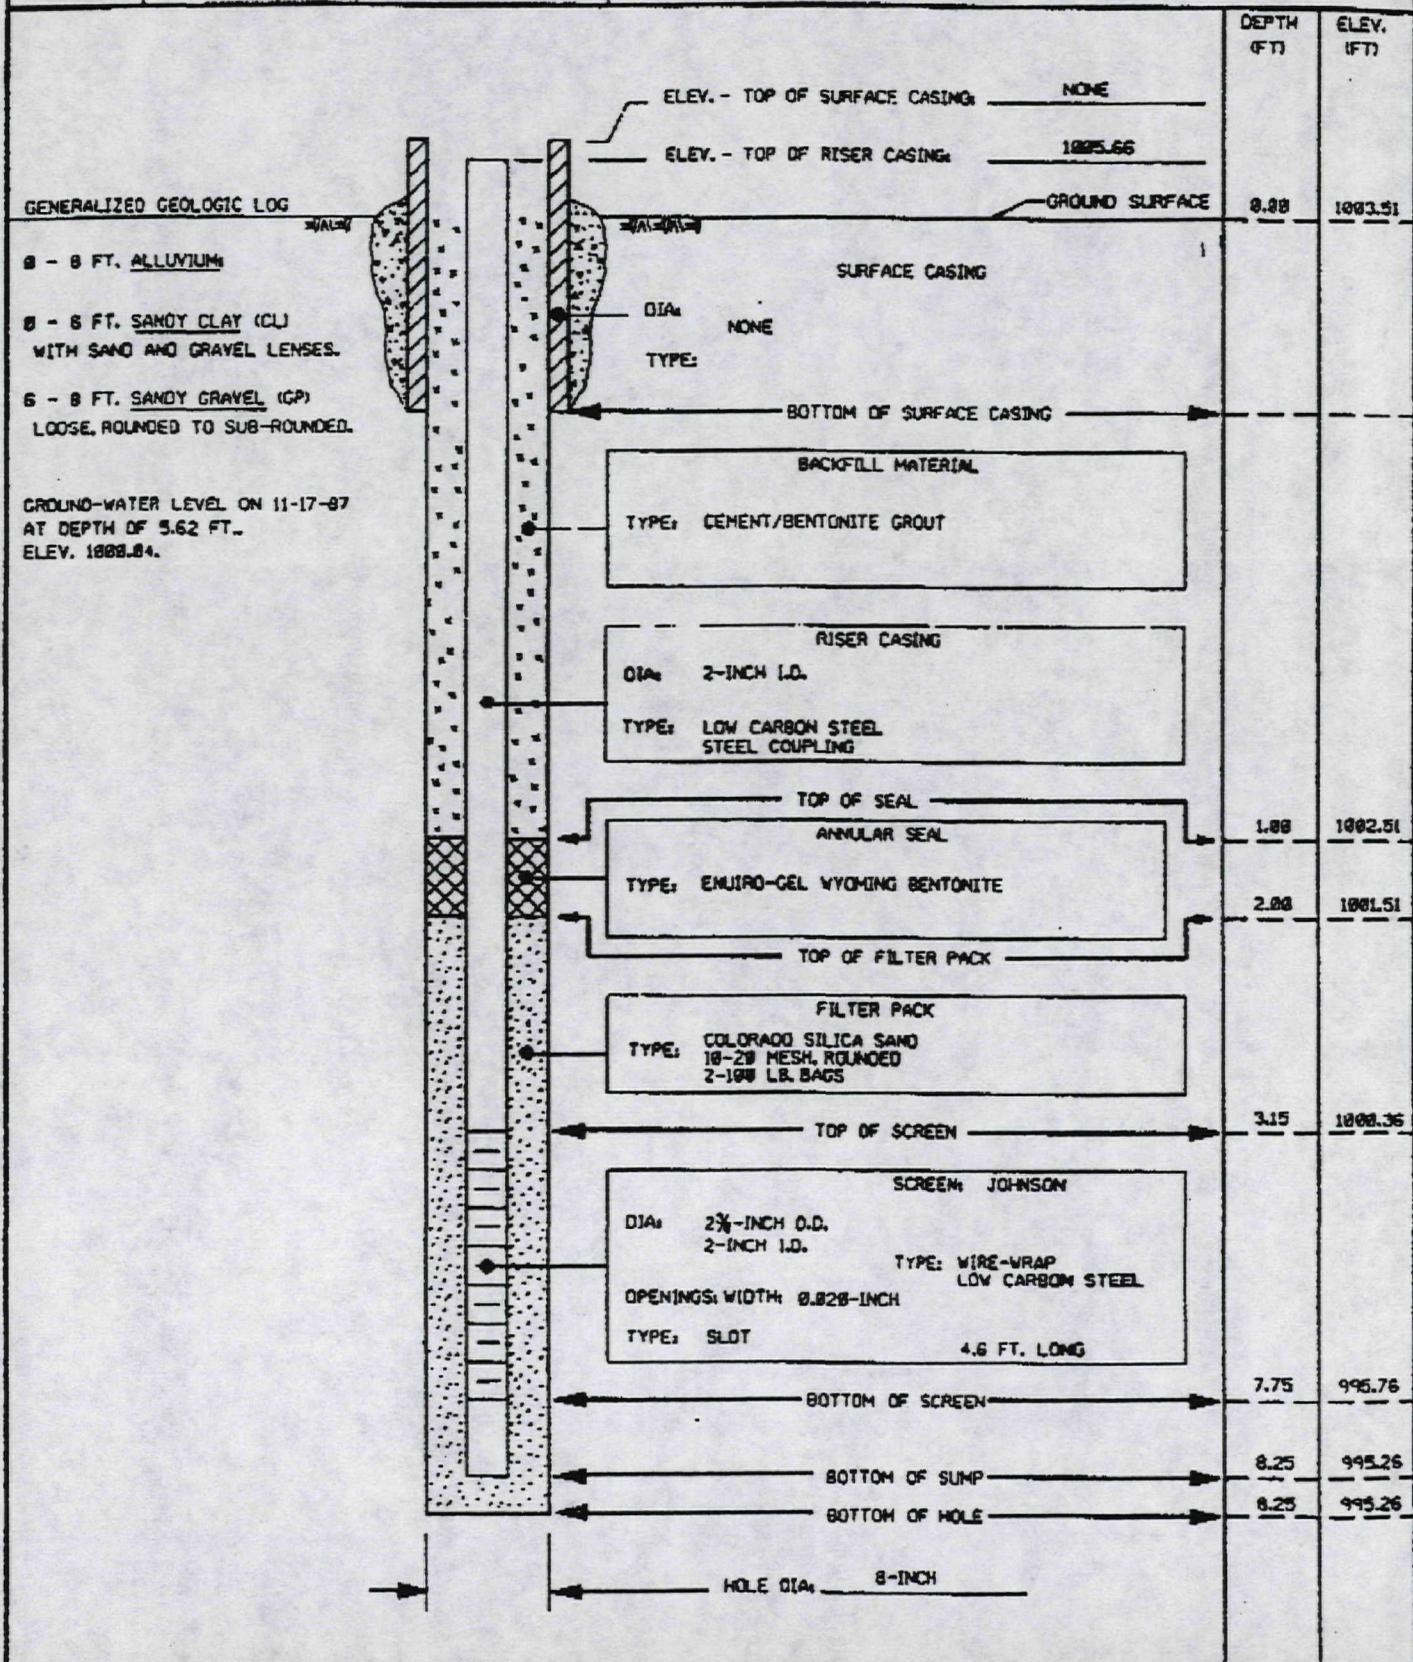



# OBSERVATION WELL

PROJECT

FMC-YAKIMA, WASHINGTON

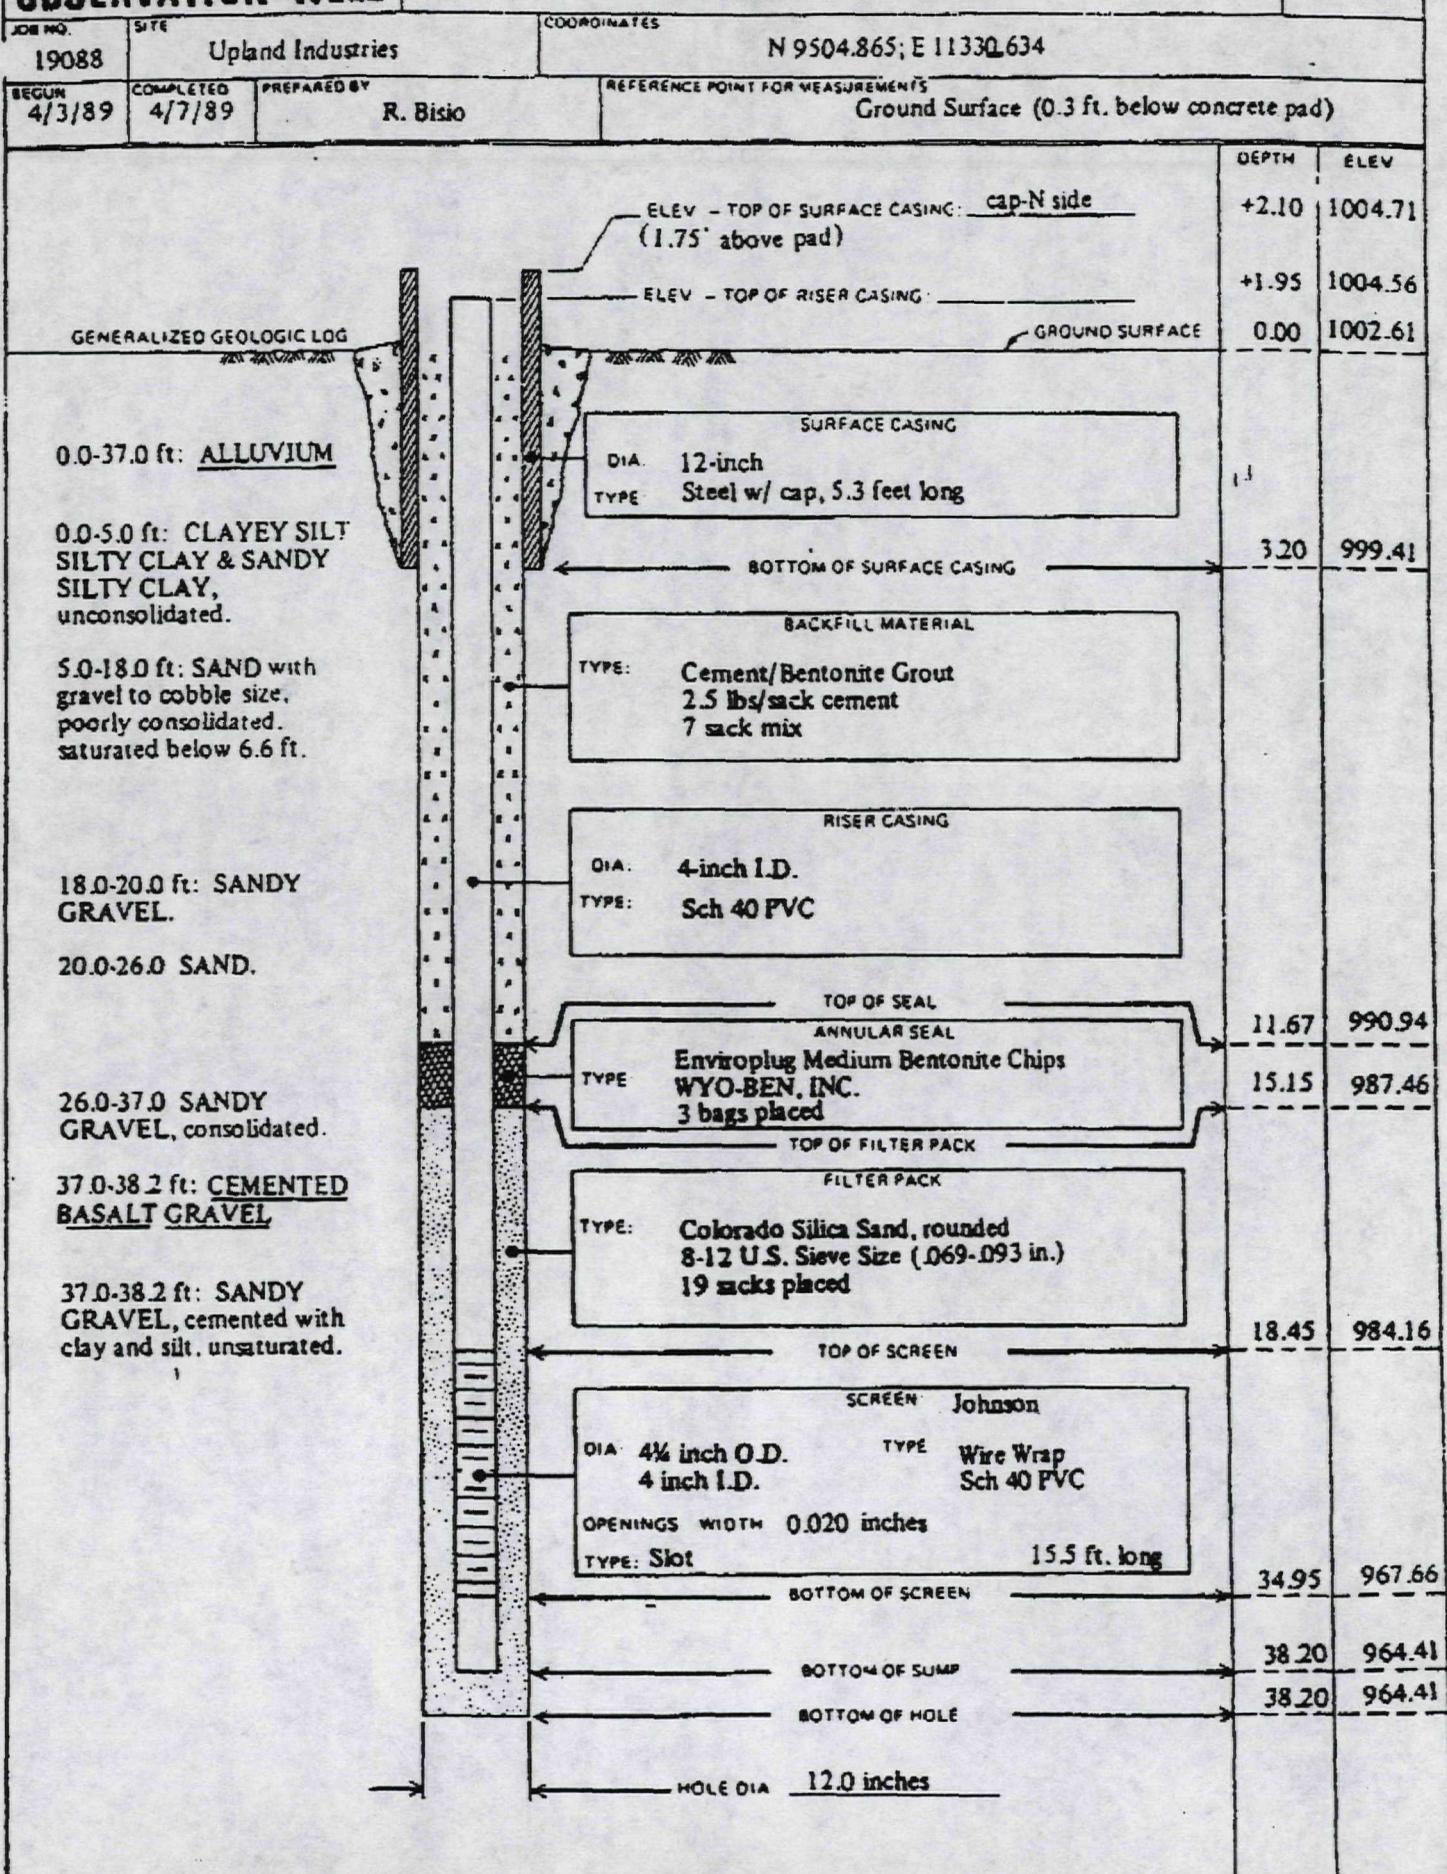
WELL NO  
W-7

Figure 2-7

**OBSERVATION WELL**

PROJECT

**FMC - YAKIMA**WELL NO  
**8A,B,C**JOB NO.  
19088SITE  
**UPLAND INDUSTRIES**

COORDINATES

N 9531.758; E 11317.044

BEGUN  
4-13-89COMPLETED  
4-14-89PREPARED BY  
**R. COOK**

REFERENCE POINT FOR MEASUREMENTS

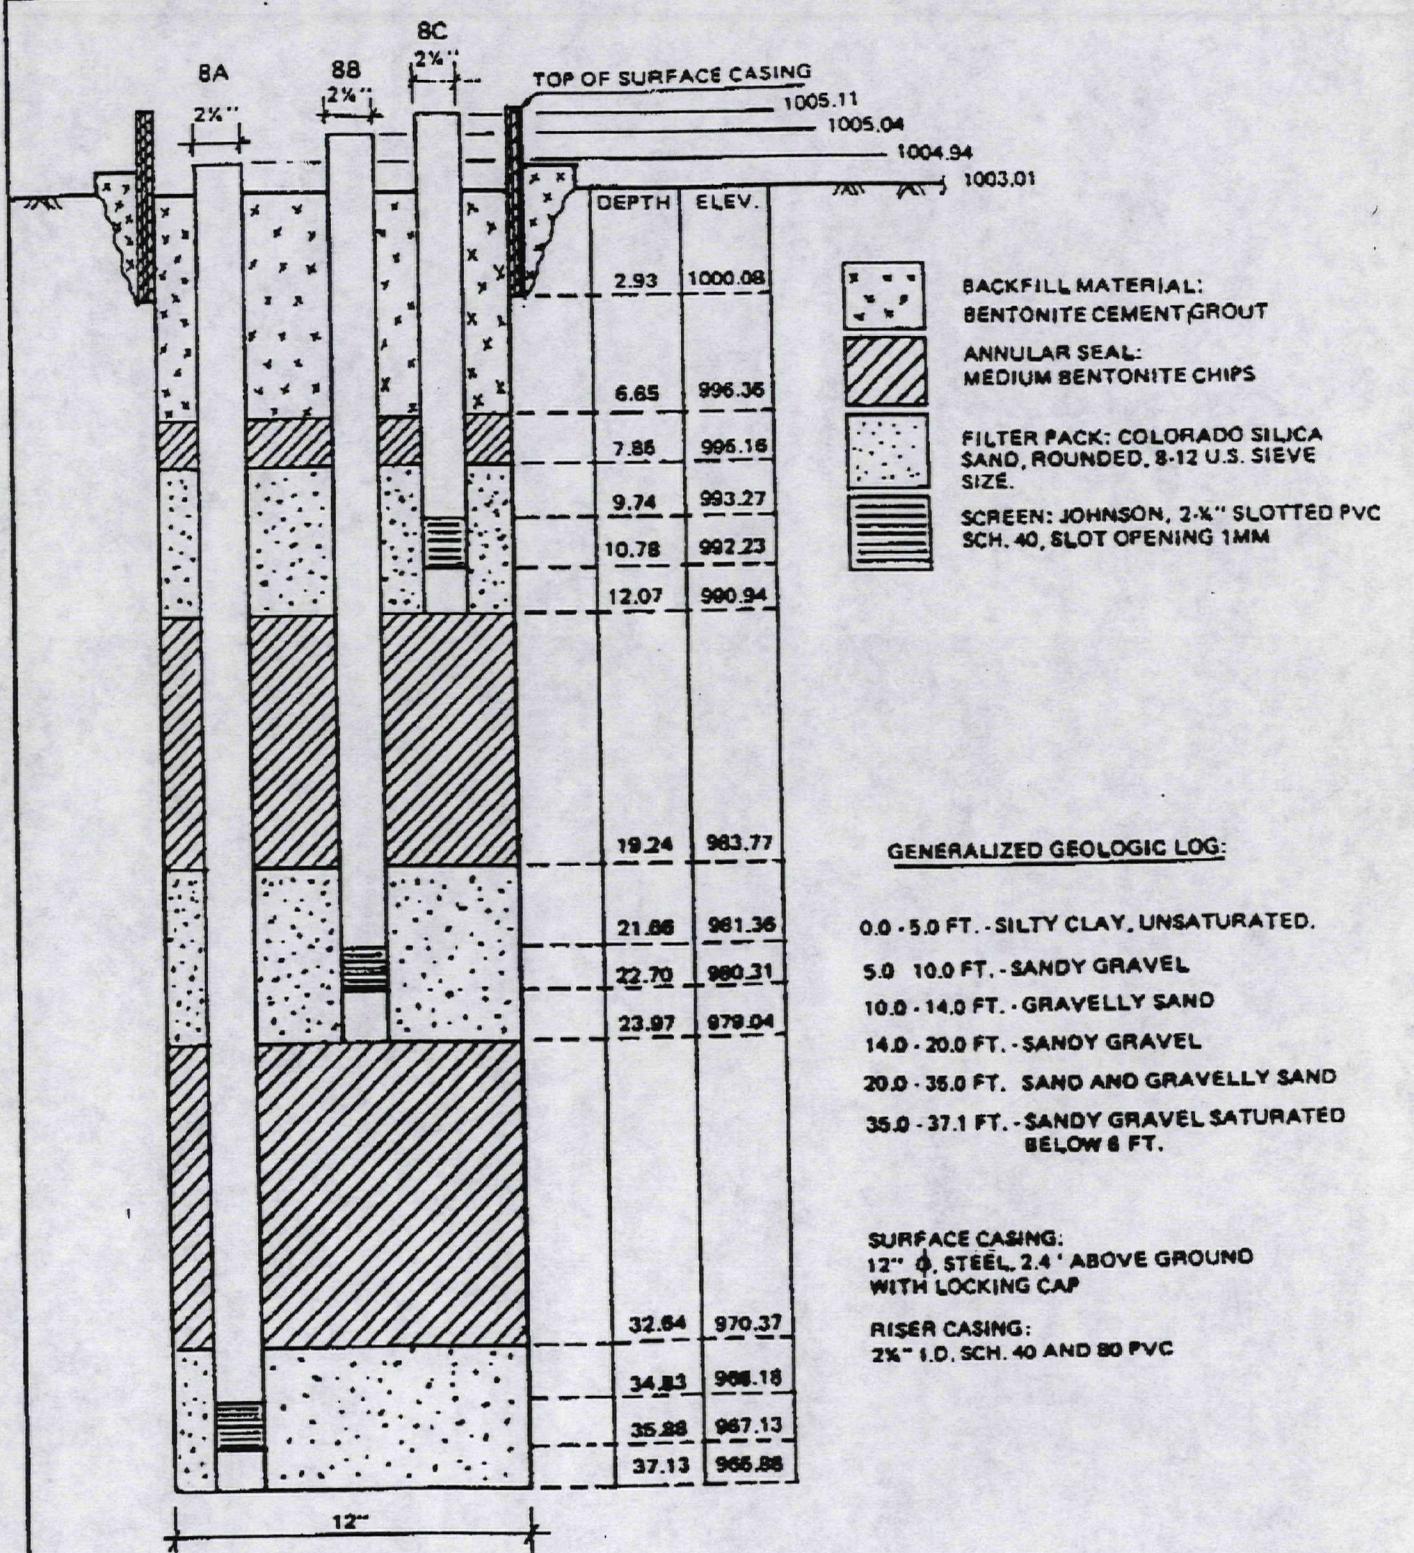
**TOP OF RISER CASING**

Figure 2.6



OBSERVATION WELL		PROJECT			WELL NO
O. 1980	SITE Upland Industries	COORDINATES			W-9a
BEGUN 7-21-90	COMPLETED 7-21-90	PREPARED BY R.P. BISIO	REFERENCE POINT FOR MEASUREMENTS Ground Surface		
				DEPTH	ELEV.
<p>ELEV. - TOP OF SURFACE CASING: _____</p> <p>ELEV. - TOP OF RISER CASING: _____</p> <p>GENERALIZED GEOLOGIC LOG</p> <p>0.0 - 39.0 ALLUVIUM</p> <p>0.0 - 1.0 CLAYEY SAND (SC)</p> <p>1.0 - 3.0 GRAVELLY CLAYEY SAND (SC)</p> <p>3.0 - 5.0 GRAVELLY SAND (SP)</p> <p>5.0 - 9.0 GRAVELLY SAND (SP)</p> <p>9.0 - 18.0 SANDY GRAVEL (GP)</p> <p>18.0 - 20.0 GRAVELLY SAND (SP)</p> <p>20.0 - 26.0 SANDY GRAVEL (GP)</p> <p>26.0 - 32.0 GRAVELLY SAND (SP)</p> <p>*7.0 - 39.0 SANDY GRAVEL (GP)</p> <p>39.0 - ? CEMENTED GRAVEL</p> <p>39.0 - CLAYEY SANDY GRAVEL (GC)</p>				GROUND SURFACE	0.00
<p>SURFACE CASING</p> <p>DIA: See log W-9a</p> <p>TYPE: _____</p> <p>BOTTOM OF SURFACE CASING</p>					3.00
<p>BACKFILL MATERIAL</p> <p>TYPE: See log W-9a.</p>					
<p>RISER CASING</p> <p>DIA: 0.17 I.D., 0.20 ft O.D.</p> <p>TYPE: Sch 40 PVC</p>					
<p>TOP OF SEAL</p> <p>ANNULAR SEAL</p> <p>ENERPAC plug, medium bentonite chips</p> <p>TYPE: WYO-BEN INC</p> <p>9 sacks placed</p>					14.90
<p>TOP OF FILTER PACK</p> <p>FILTER PACK</p> <p>TYPE: Colorado Silica Sand, rounded.</p> <p>10-20 U.S. sieve size.</p> <p>8.5 sacks placed</p>					20.25
<p>TOP OF SCREEN</p> <p>SCREEN: Shop manufactured</p> <p>DIA: 0.19' I.D. 0.20' O.D.</p> <p>TYPE: Slot 120° Sch 40 PVC I</p> <p>OPENINGS: WIDTH: 0.020 inches, 0.02' C/C</p> <p>TYPE: Slot 4.50 ft long</p>					31.70
<p>BOTTOM OF SCREEN</p>					36.20
<p>BOTTOM OF SUMP</p>					38.45
<p>BOTTOM OF HOLE</p>					38.50
<p>HOLE DIA. 12-inch</p>					

Centrifizers 1.20 ft long,  
0.5 ft diameter placed  
above and below screen.

EIGHTEEN

OBSERVATION WELL		PROJECT	WELL NO.	
JOB NO.	SITE	EMC YAKIMA	W-9b	
19008	Upland Industries	COORDINATES		
BEGUN	COMPLETED	PREPARED BY	REFERENCE POINT FOR MEASUREMENTS	
7-21-90	7-22-90	R.P. BISIO	Ground Surface	
<p>GENERALIZED GEOLOGIC LOG</p> <p>See W-9a for geologic log</p> <p>ELEV. - TOP OF SURFACE CASING: _____</p> <p>ELEV. - TOP OF RISER CASING: _____</p> <p>2.10 GROUND SURFACE 0.00</p> <p>SURFACE CASING DIA: 8-inch TYPE: Steel pipe w/ locking cap</p> <p>BOTTOM OF SURFACE CASING 3.00</p> <p>BACKFILL MATERIAL TYPE: Cement / Bentonite Grout 2.5 lbs bentonite/sack cement 6 bags placed.</p> <p>RISER CASING DIA: 0.17 I.D., 0-20 ft O.D. TYPE: Sch 40 PVC</p> <p>TOP OF SEAL TYPE: Euroseal medium bentonite chips WYO-BEN INC.</p> <p>TOP OF FILTER PACK TYPE: Colorado Silica Sand, rounded 10-20 U.S. Sieve Size 6 sacks placed.</p> <p>SCREEN: Slot manufactured DIA: 0.19 I.D. 0.20 O.D. OPENINGS: WIDTH 0.020 inches, 0.02 I.C. TYPE: Slot</p> <p>BOTTOM OF SCREEN</p> <p>BOTTOM OF SUMP</p> <p>BOTTOM OF HOLE</p> <p>HOLE DIA: 12-inch</p> <p>DEPTH ELEV.</p>				



# OBSEvation WELL

PROJECT

FMC YAKIMA

WELL NO.

W-10

NO.	SITE 19000 UPLAND INDUSTRIES	COORDINATES		
BEGUN	COMPLETED 7-11-90	PREPARED BY R. BISIO	REFERENCE POINT FOR MEASUREMENTS Ground Surface	
				DEPTH ft
				ELEV. ft
<p><b>GENERALIZED GEOLOGIC LOG</b></p> <ul style="list-style-type: none"> <li>0.0 - 24.9 <u>ALLUVIUM</u></li> <li>0.0 - 2.0 ft CLAYEY SAND, topsoil.</li> <li>2.0 - 9.0 SILTY SAND saturated below</li> <li>9.0 - 12.0 GRAVELLY SAND</li> <li>12.0 - 14.0 SAND, medium grained.</li> <li>14.0 16.0 SANDY GRAVEL</li> <li>16.0 - 24.0 SAND with silt and gravel</li> <li>24.0 - 25.0 SANDY GRAVEL</li> </ul> <p>Centralizers 1.20' long, 0.5' diameter placed above and below screen.</p>				
<p>ELEV. - TOP OF SURFACE CASING: _____</p> <p>ELEV. - TOP OF RISER CASING: _____</p> <p>1.75' GROUND SURFACE</p> <p><b>SURFACE CASING</b></p> <p>DIA: 8-inch TYPE: steel pipe w/ locking cap.</p> <p>BOTTOM OF SURFACE CASING</p> <p><b>BACKFILL MATERIAL</b></p> <p>TYPE: Cement/Bentonite Grout 2.5 lbs bentonite / sack cement 3 sacks placed</p> <p><b>RISER CASING</b></p> <p>DIA: 0.17 I.D.; 0.20 O.D TYPE: Sch 40 PVC</p> <p>TOP OF SEAL</p> <p>ANNULAR SEAL Europlug Medium Bentonite Clay TYPE: WYO-BEN INC. 1 sack placed</p> <p>TOP OF FILTER PACK</p> <p><b>FILTER PACK</b></p> <p>TYPE: Colorado Silica Sand, rounded 10-20 U.S. Sieve Size 8 sacks placed</p> <p>TOP OF SCREEN</p> <p><b>SCREEN:</b> Shop manufactured</p> <p>DIA: 0.19 I.D. 0.20 O.D OPENINGS: WIDTH: 0.020 inches, 0.02' G/C TYPE: Slot 4.25' long</p> <p>BOTTOM OF SCREEN</p> <p>BOTTOM OF SUMP</p> <p>BOTTOM OF MOLE</p> <p>HOLE DIA: 8 inches</p>				0.00
				3.00
				13.80
				15.10
				16.24
				22.52
				24.92
				24.92



## OBSEVATION WELL

PROJECT

FMG - YAKIMA

WELL NO.

W-11


WELL NO.	SITE	UPLAND INDUSTRIES	COORDINATES
----------	------	-------------------	-------------

BEGUN	COMPLETED	PREPARED BY
-------	-----------	-------------

7-13-90	7-13-90	R. BISIO
---------	---------	----------

REFERENCE POINT FOR MEASUREMENTS

Ground Surface

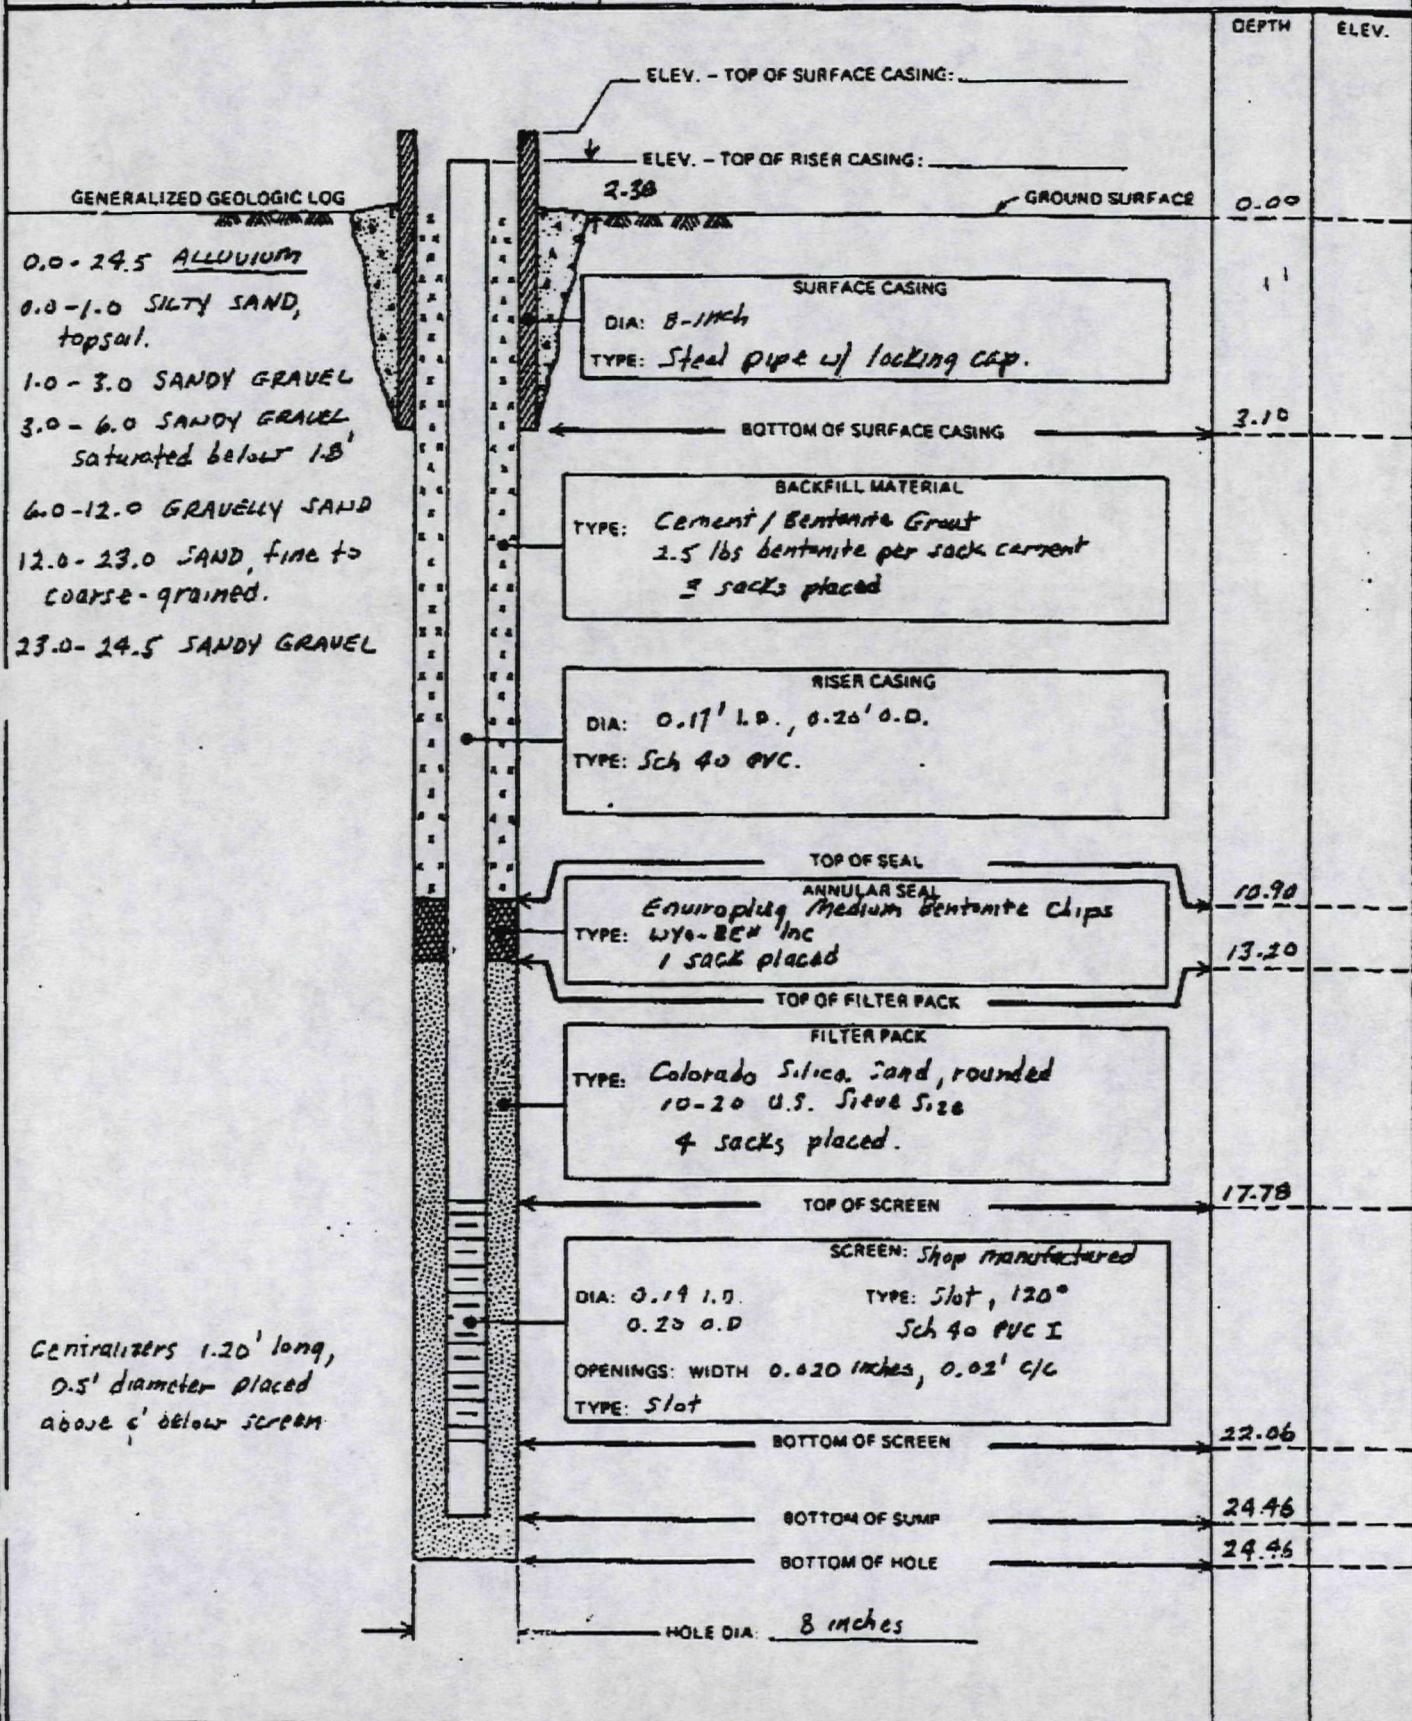

## RESOURCE PROTECTION WELL REPORT

START CARD NO. A12190

PROJECT NAME: F.M.C.  
 WELL IDENTIFICATION NO. W/A MU-11  
 DRILLING METHOD: R.D. ROONEY LA BROSSE  
Cascade Drilling, Inc.  
 SIGNATURE:  
 CONSULTING FIRM: ERM  
 REPRESENTATIVE: MIKE ARNOLD

COUNTY: Yakima  
 LOCATION NE 1/4 Sub 1/4 Sec 31 Twp 13 N R 19 E  
 STREET ADDRESS OF WELL: 4 WEST WASHINGTON AVE - YAKIMA  
 WATER LEVEL ELEVATION: N/A Surface  
 GROUND SURFACE ELEVATION: N/A  
 INSTALLED:  
 DEVELOPED:

S334

AS-BUILT

## WELL DATA

## FORMATION DESCRIPTION


Well abandonment

CONCRETE SURFACE SEAL

0 - 24 ft.  
clipped in place

BACKFILL

6"  
Bent chips

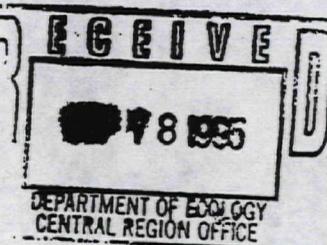ft.ft.

DEPTH OF BORING 24"

ALE: \_\_\_\_\_

PAGE        OF       

ECY 050-12 (Rev. 11/94)

TOTAL PGS

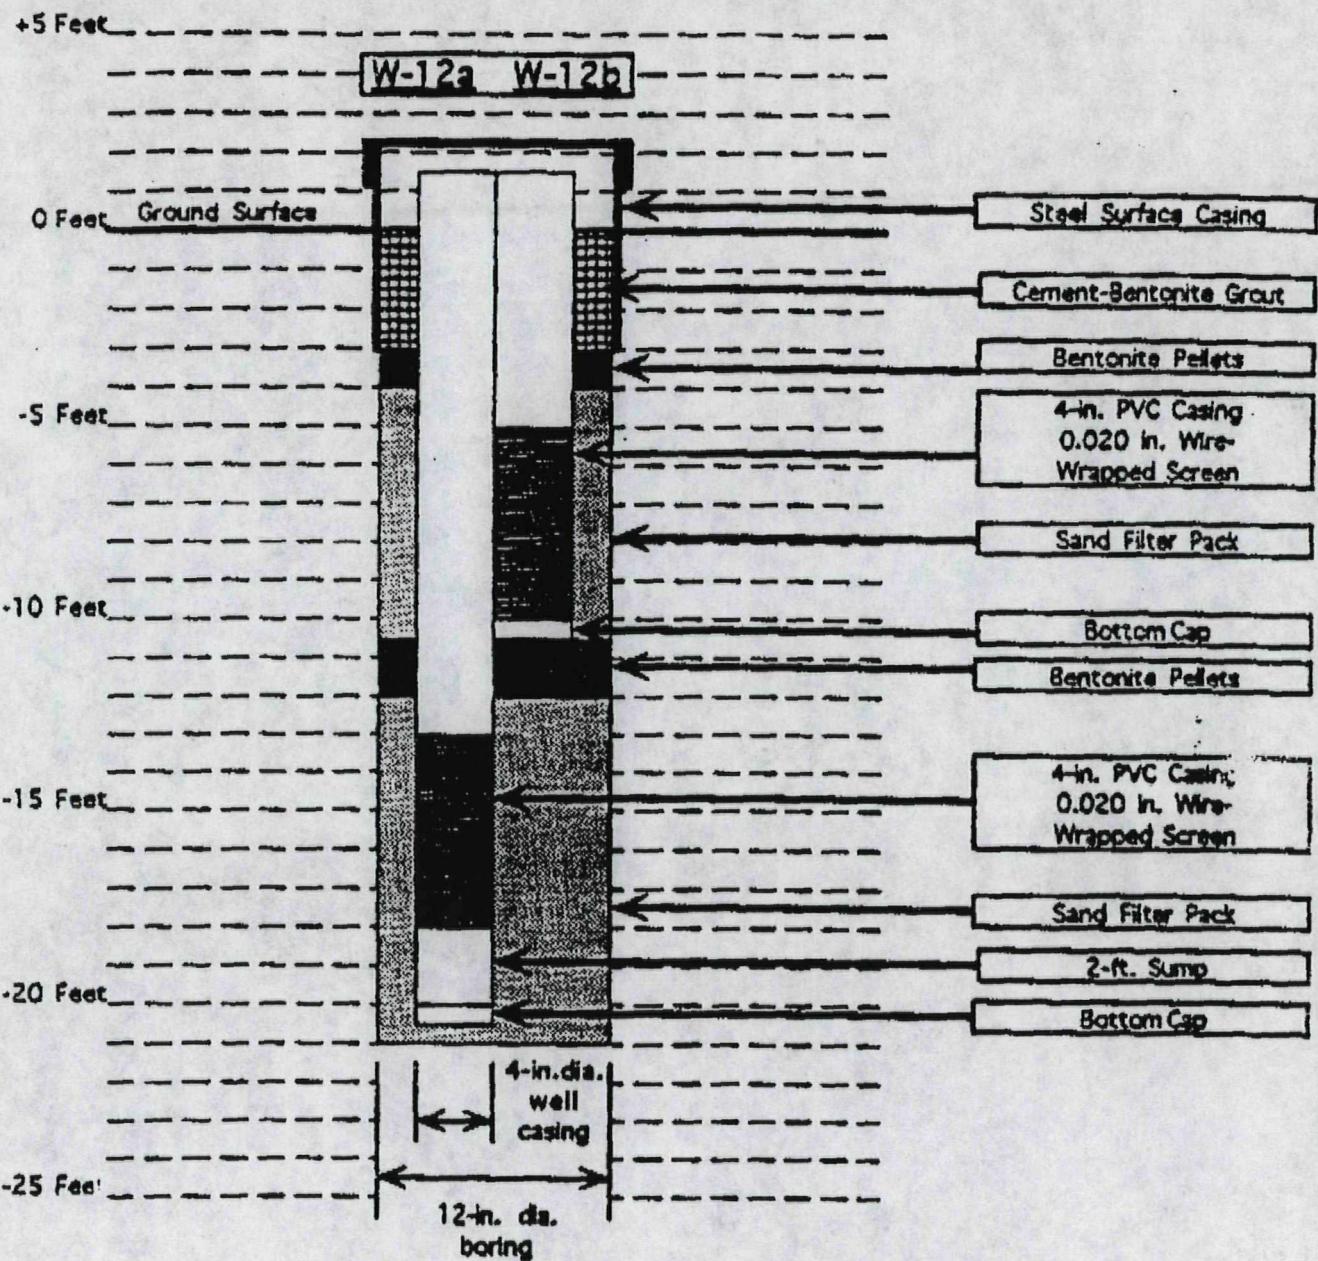



FIGURE 2.  
SCHEMATIC DIAGRAM  
OF PROPOSED  
MONITORING WELLS  
NOT TO SCALE

# RESOURCE PROTECTION WELL REPORT

START CARD NO. R-19692

PROJECT NAME: Fmc  
 WELL IDENTIFICATION NO. 12 A+B  
 DRILLING METHOD: Cable Tool  
 DRILLER: Dale Bigham  
 FIRM: Oregon Drilling  
 SIGNATURE: Dale Bigham  
 CONSULTING FIRM: Bechtel  
 REPRESENTATIVE: Sandy Lawson

COUNTY: Yakima  
 LOCATION: SW 1/4 Sec 31 Twp 13 R 19  
 STREET ADDRESS OF WELL: 4 Washington Ave Yakim.  
 WATER LEVEL ELEVATION: 3,5  
 GROUND SURFACE ELEVATION:  
 INSTALLED: 7/21/93  
 DEVELOPED: 7/22/93

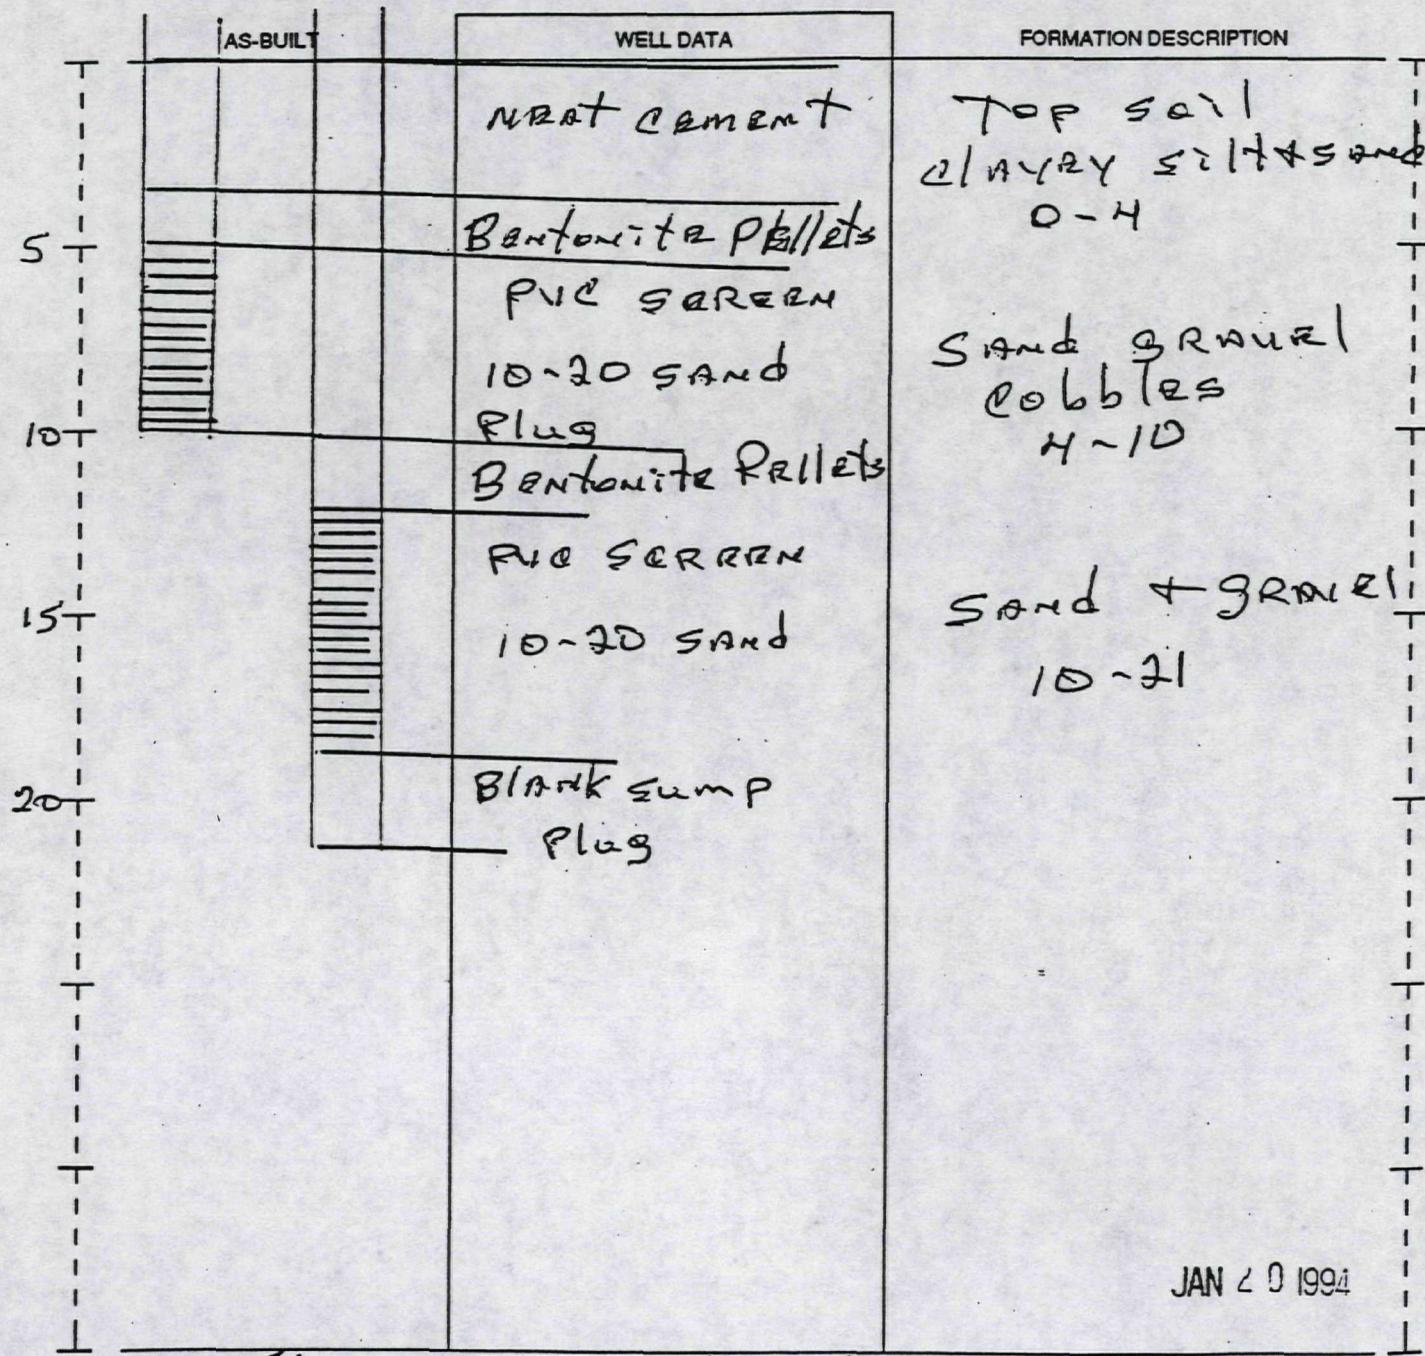

SCALE: 1" = 5'

PAGE 1 OF 1

## Environmental Resources Management

## Drilling Log

Project Ground Water Monit Owner FMC  
 Location Yakima Project Number 1005  
 Boring Number W-13 Total Depth of Auger 16 ft Auger Diameter 4.25 ID  
 Surface Elevation \_\_\_\_\_ Water Level: Initial 4.62 ft 24-hrs. \_\_\_\_\_  
 Total Depth of Soil Sampler \_\_\_\_\_ Total Depth of Ground Water Sampler \_\_\_\_\_  
 Ground Water Sample Interval(s) \_\_\_\_\_  
 Drilling Company Cascade Drilling Method HSA  
 Driller Steve Butler Log By Tim Lewallen Date Drilled 6/27/94

Sketch Map

Notes

See Attached Site Map

Depth (Feet)	Graphic Log and USCS Designation	FID (ppm)	PID (ppm)	Sample Interval	Soil Description and Observations (Color, Texture, Structures, Odor, Foreign Matter)	
					CL	ML
0					0-3'	Black silty clay loam
5					3-5'	Dark brown silt with fine gravel
10					5-8'	Brown fine to medium sand with fine gravel, wet
14.5					8-	Brown fine to medium sand, wet
15	GP				14.5-	Fine to coarse gravel with some fine to coarse sand



## MONITORING WELL INSTALLATION REPORT

ERM

WELL NUMBER: W-13

INSTALLATION DATE: 6/27/94

PROJECT NAME: FMC GWM

SURFACE ELEVATION:  
(FT ABOVE MSL)ADDRESS: 4 West Washington Av.  
Yakima, WATOP OF CASING:  
(FT ABOVE MSL)

TYPE OF WELL: Monitoring well


SURVEYED

INSTALLATION

WELL LOCATION:

CONTRACTOR: Cascade Drilling Co.

SITE MANAGER:

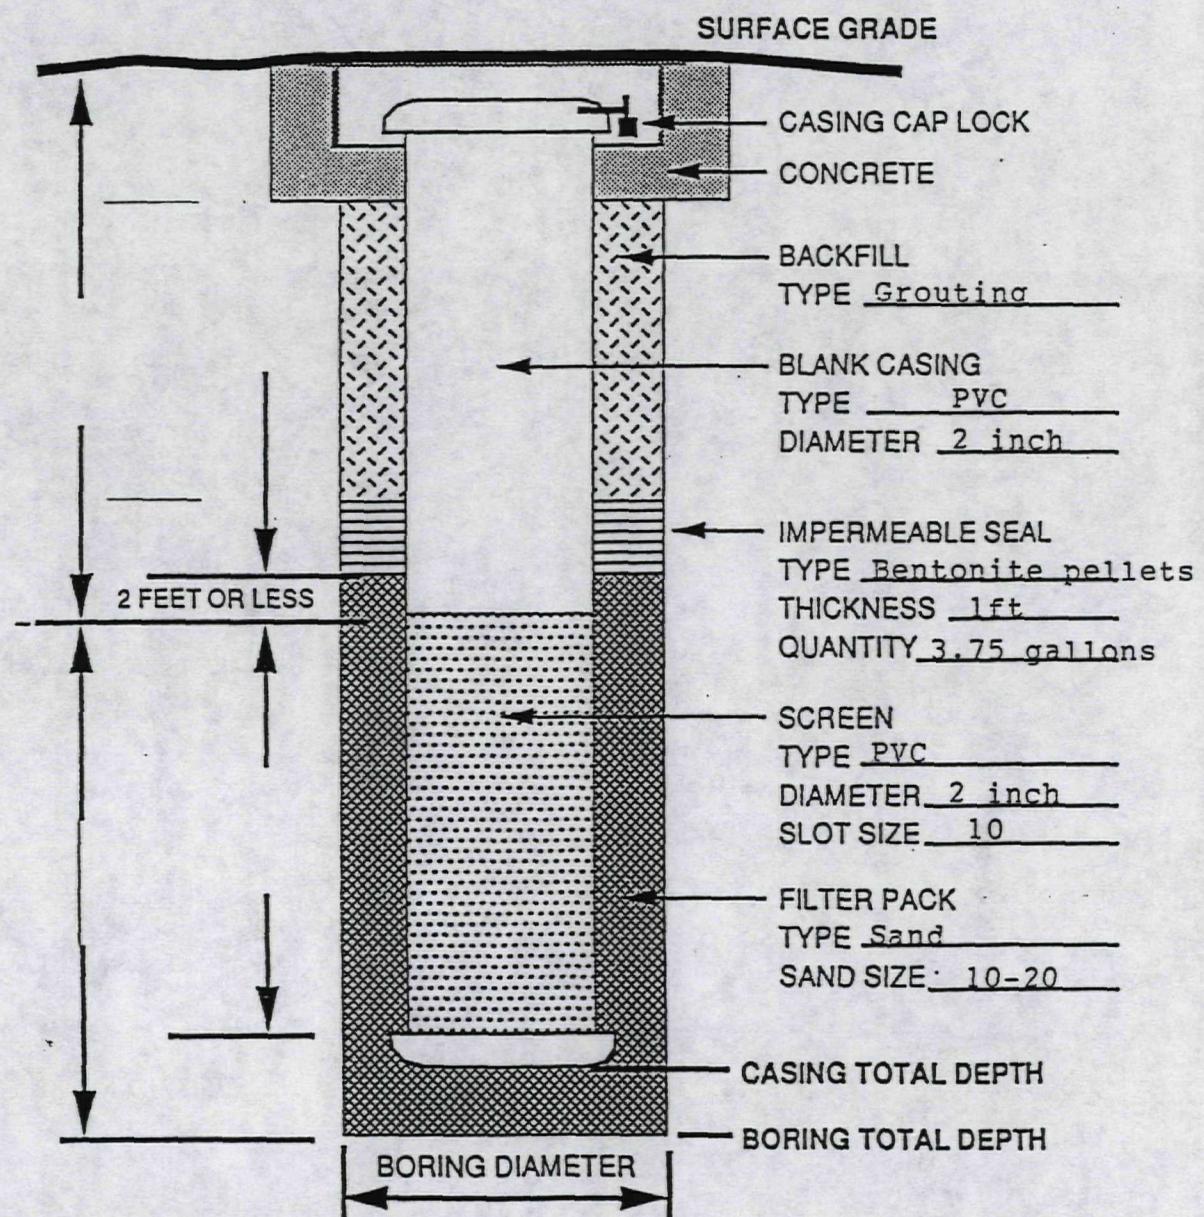

## RESOURCE PROTECTION WELL REPORT

W-13



PROJECT NAME: FVIC  
 WELL IDENTIFICATION NO. ABN 564  
 DRILLING METHOD: AUGER  
 DRILLER: STEVE BUTLER  
 FIRM: Cascade Drilling, Inc.  
 SIGNATURE: STEVE BUTLER  
 CONSULTING FIRM: ERIN  
 REPRESENTATIVE: DON CLABAUGH

START CARD NO. R18785

COUNTY: YAKIMA  
 LOCATION: NE 1/4 SW 1/4 Sec 31 Twp 13 N R 19 E  
 STREET ADDRESS OF WELL: 4 WEST WA Ave

WATER LEVEL ELEVATION: 8'  
 GROUND SURFACE ELEVATION: N/A  
 INSTALLED: 6-27-94  
 DEVELOPED: 6-28-94

4282

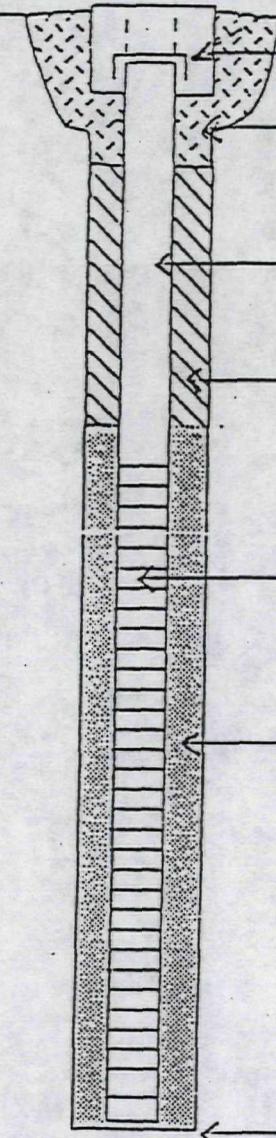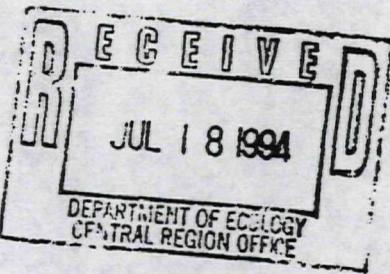AS-BUILT	WELL DATA	FORMATION DESCRIPTION
	<p>WELL COVER</p> <p>CONCRETE SURFACE SEAL DEPTH = 1/ft</p> <p>PVC BLANK <u>2" x 6"</u></p> <p>BACKFILL <u>2 ft.</u> TYPE: <u>CHIPS</u></p> <p>PVC SCREEN <u>2" x 10'</u> SLOT SIZE: <u>.010</u></p> <p>GRAVEL PACK <u>12 ft.</u> MATERIAL: <u>10-20 SAND</u></p> <p>WELL DEPTH <u>15"</u></p>	<p><u>0 - 4 ft.</u> <u>SILTY CLAY &amp; COBBLES</u></p> <p><u>4 - 8 ft.</u> <u>SILT &amp; GRAVEL</u></p> <p><u>8 - 15 ft.</u> <u>SILTY SAND</u></p>
		
SCALE: 1" = _____	PAGE _____ OF _____	

## Environmental Resources Management

## Drilling Log

Project Ground Water Monit. Owner FMC  
 Location Yakima Project Number 1005  
 Boring Number W-14 Total Depth of Auger 16 ft Auger Diameter 4.25 ID  
 Surface Elevation \_\_\_\_\_ Water Level: Initial \_\_\_\_\_ 24-hrs. 5.93 ft  
 Total Depth of Soil Sampler \_\_\_\_\_ Total Depth of Ground Water Sampler \_\_\_\_\_  
 Ground Water Sample Interval(s) \_\_\_\_\_  
 Drilling Company Cascade Drilling Method HSA  
 Driller Steve Butler Log By Tim Lewallen Date Drilled 6/27/94

Sketch Map

Notes

See Attached Site Map

Depth (Feet)	Graphic Log and USCS Designation	FID (ppm)	PID (ppm)	Sample Interval	Soil Description and Observations (Color, Texture, Structures, Odor, Foreign Matter)
0					0-1.5' Brown silty clay loam
	CL				1.5-4.5' Brown silty clay loam with medium gravel
5	SW				4.5-5.5' Brown medium sand with fine gravel
	SP				5.5-8' Fine to medium sand with fine to coarse gravel
10	GP				8-9.5' Fine to coarse sand with fine gravel, wet
	SP GP				9.5-14' Coarse gravel with fine to coarse sand, wet
15					14-14.5' Medium to coarse sand with fine to coarse gravel
					14.5-15' Coarse gravel with medium to coarse sand, wet

## MONITORING WELL INSTALLATION REPORT

WELL NUMBER: W-14

INSTALLATION DATE: 6/27/94

PROJECT NAME: FMC GWM

SURFACE ELEVATION:  
(FT ABOVE MSL)ADDRESS: 4 West Washington Av.  
Yakima, WATOP OF CASING:  
(FT ABOVE MSL)

TYPE OF WELL: Monitoring well


SURVEYED

INSTALLATION

WELL LOCATION:

CONTRACTOR: Cascade Drilling Co.

SITE MANAGER:

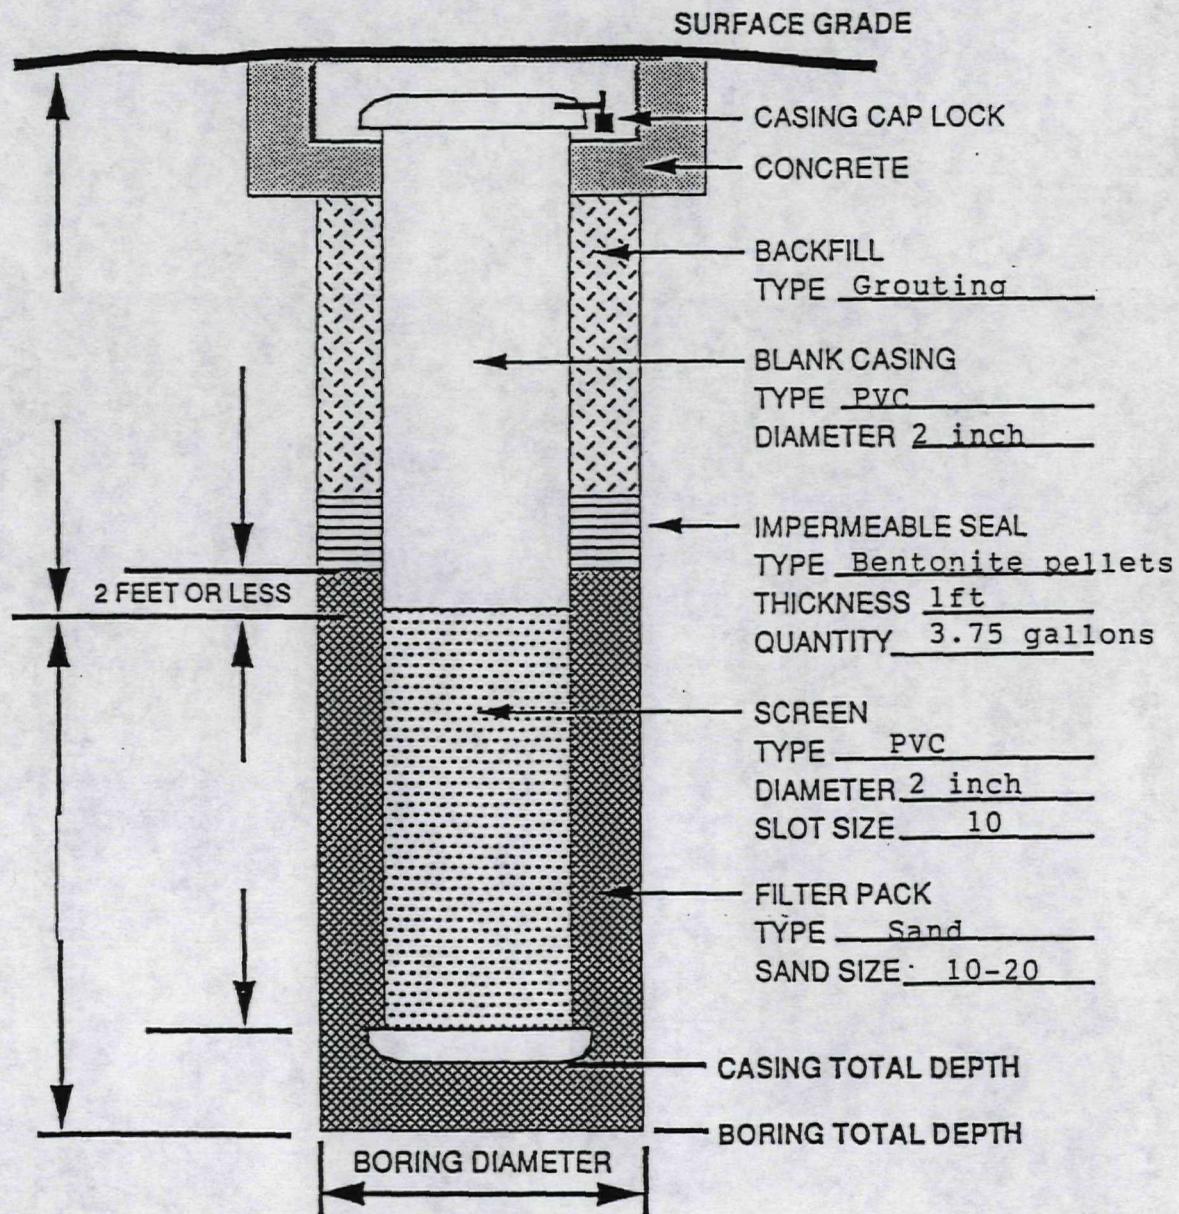

## RESOURCE PROTECTION WELL REPORT

START CARD NO. R18785

PROJECT NAME: FMC  
 WELL IDENTIFICATION NO. ABN 56-5  
 DRILLING METHOD: AUGER  
 DRILLER: STEVE BUTLER  
 FIRM: Cascade Drilling, Inc.  
 SIGNATURE: STC.B.  
 CONSULTING FIRM: FPM  
 REPRESENTATIVE: DON CLABAUGH

COUNTY: YAKIMA  
 LOCATION: NE SW 1/4 Sec 31 Twp 13 N R 19 E  
 STREET ADDRESS OF WELL: 410 WEST WA. AVE  
 WATER LEVEL ELEVATION: 8'  
 GROUND SURFACE ELEVATION: N/A  
 INSTALLED: 6-27-94  
 DEVELOPED: 6-28-94

4282

AS-BUILT	WELL DATA	FORMATION DESCRIPTION
	<p>WELL COVER    CONCRETE SURFACE SEAL    DEPTH = 1/ft</p> <p>PVC BLANK <u>2 "x 6'</u></p> <p>BACKFILL <u>2</u> ft.    TYPE: <u>CHIPS</u></p> <p>PVC SCREEN <u>2 "x 10'</u>    SLOT SIZE: <u>.010</u></p> <p>GRAVEL PACK <u>12</u> ft.    MATERIAL: <u>10-20 SAND</u></p> <p>WELL DEPTH <u>15'</u> "</p>	<p><u>0 - 4</u> ft.  <u>SILTY CLAY &amp; COBBLES</u></p> <p><u>4 - 8</u> ft.  <u>SILT &amp; GRAVEL</u></p> <p><u>8 - 15</u> ft.  <u>SILTY SAND</u></p>

**ERM-WEST**

Environmental Resources Management

FMC - Yakima


Job #2672.03

Drilling Log

Project Former Pesticide Facility Location Yakima, WA  
 Owner FMC Project Number 2672.03  
 Well/Boring No. MW-15 Total Depth 15.3 Diameter 10"  
 Surface Elevation \_\_\_\_\_ Water Level: Initial N/A Ref. Pt. N/A  
 Screen: Dia. 2" Length 10' Slot Size .010"  
 Casing: Dia. 2" Length 5' Type PVC  
 Drilling Company Cascade Drilling Drilling Method Hollow stem auger  
 Driller Rodney La Brosse Log by AMA Date Drilled 08/24/95

Sketch Map

Notes

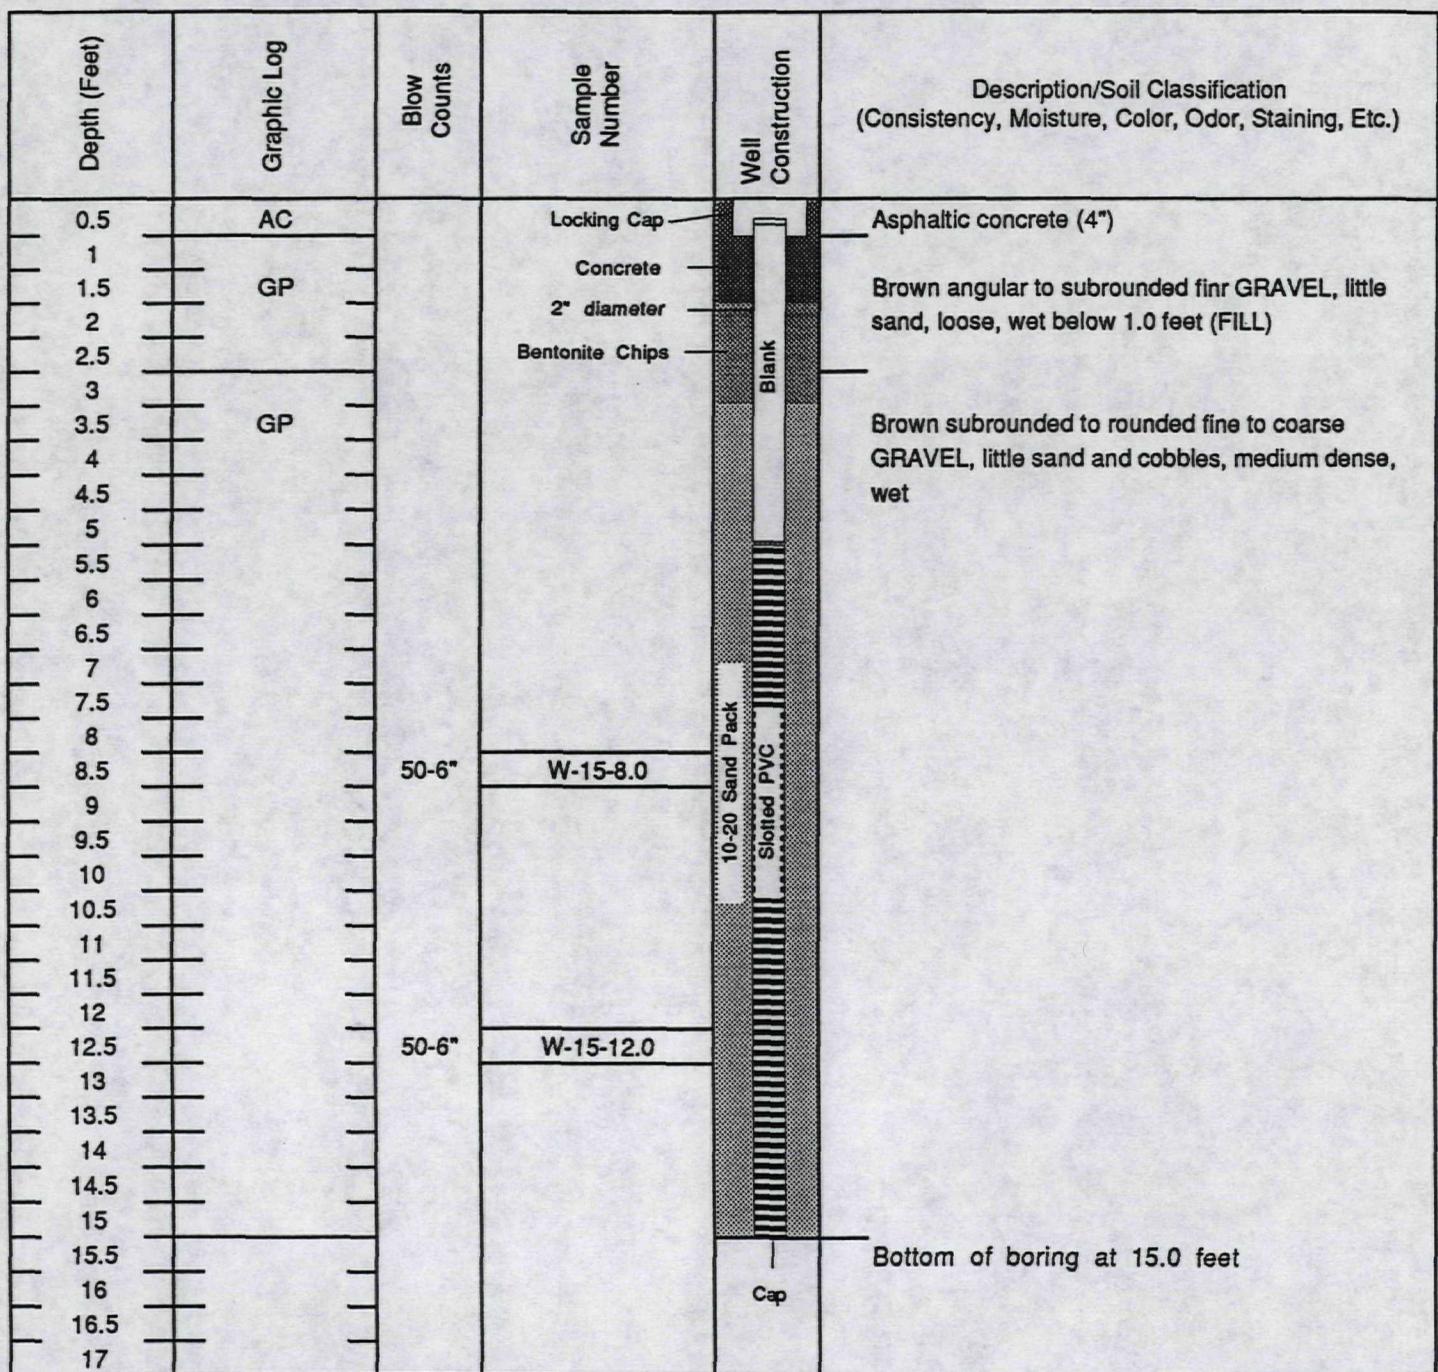

**ERM-WEST**

Environmental Resources Management

FMC - Yakima


Job #2672.03

Drilling Log

Project Former Pesticide Facility Location Yakima, WA  
 Owner FMC Project Number 2672.03  
 Well/Boring No. MW-16 Total Depth 15.9' Diameter 10"  
 Surface Elevation \_\_\_\_\_ Water Level: Initial N/A Ref. Pt. N/A  
 Screen: Dia. 2" Length 10' Slot Size .010"  
 Casing: Dia. 2" Length 6' Type PVC  
 Drilling Company Cascade Drilling  
 Driller Rodney La Brosse Log by AMA Date Drilled 08/24/95

Sketch Map

Notes

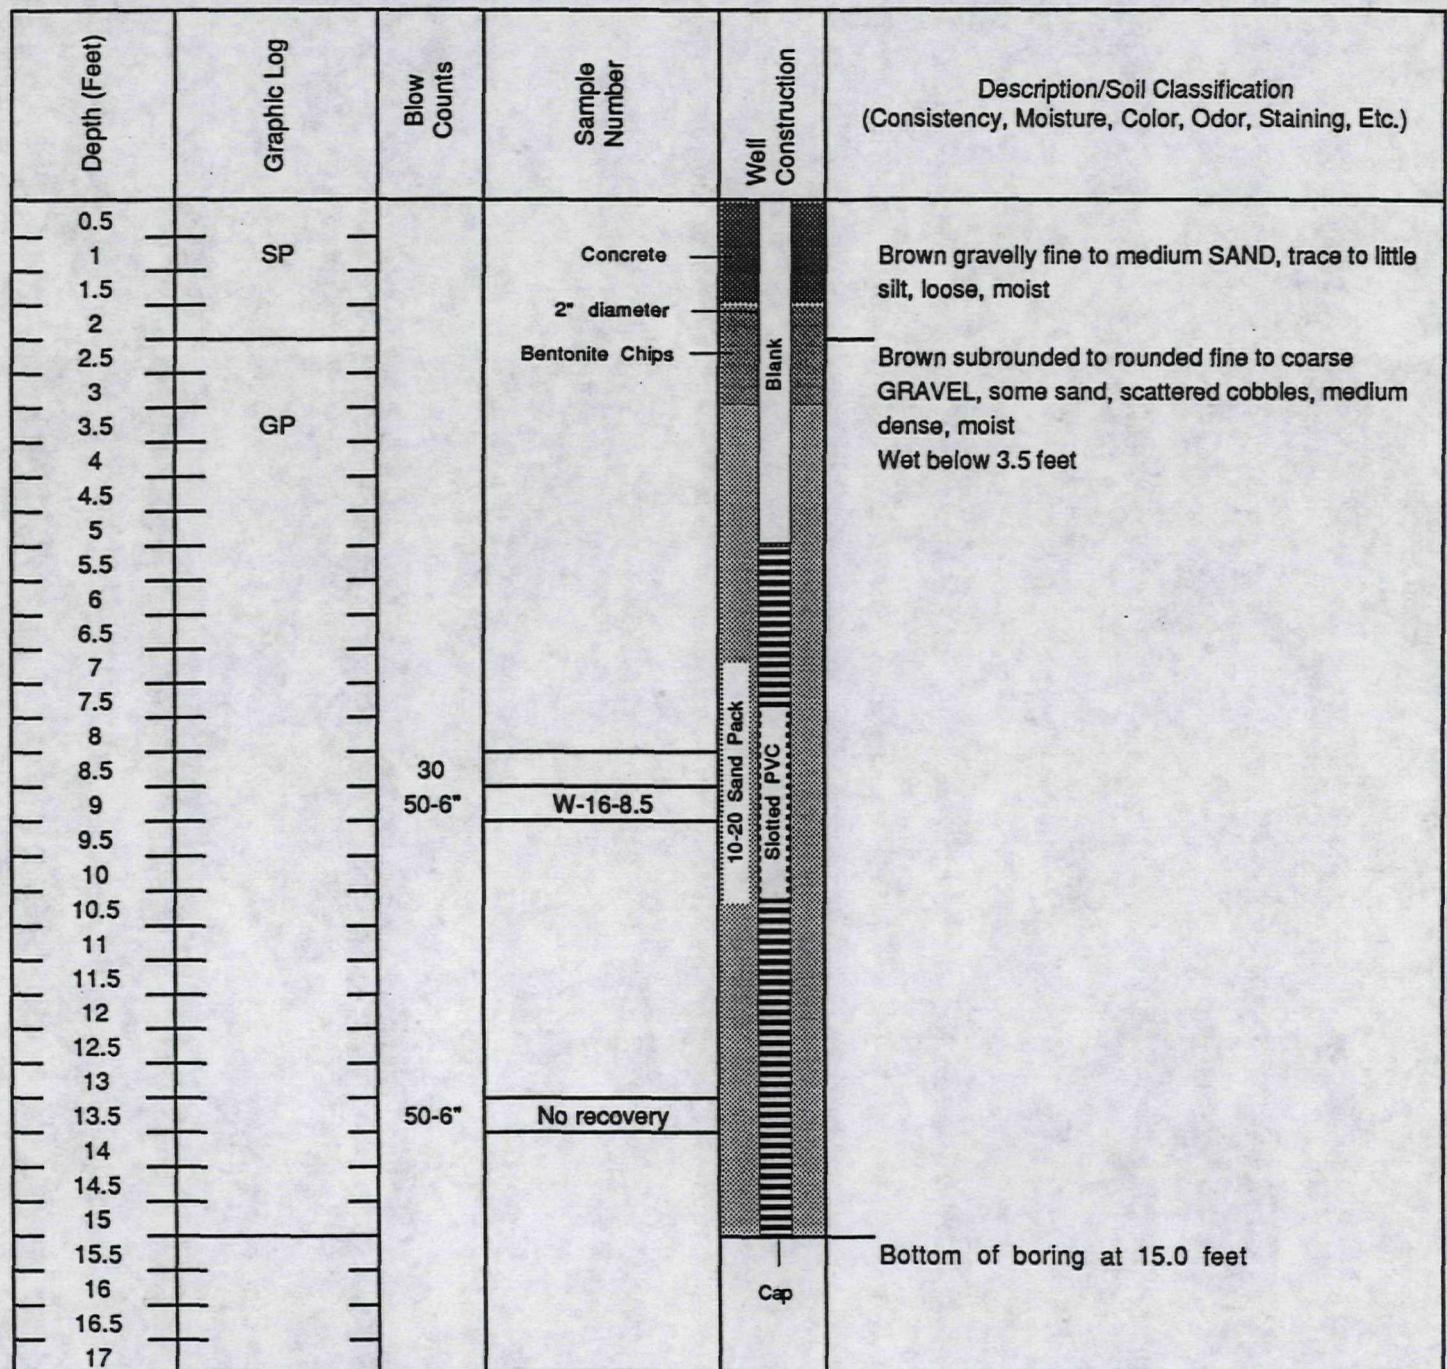

**ERM-WEST**


Environmental Resources Management

**FMC - Yakima**  
**Job #2672.03**  
**Drilling Log**

Project Former Pesticide Facility Location Yakima, WA  
 Owner FMC Project Number 2672.03  
 Well/Boring No. MW-17 Total Depth 16.2' Diameter 10"  
 Surface Elevation \_\_\_\_\_ Water Level: Initial N/A Ref. Pt. N/A  
 Screen: Dia. 2" Length 10' Slot Size .010"  
 Casing: Dia. 2" Length 6.5' Type PVC  
 Drilling Company Cascade Drilling  
 Driller Rodney La Brosse Log by AMA Date Drilled 08/24/95

Sketch Map

Notes

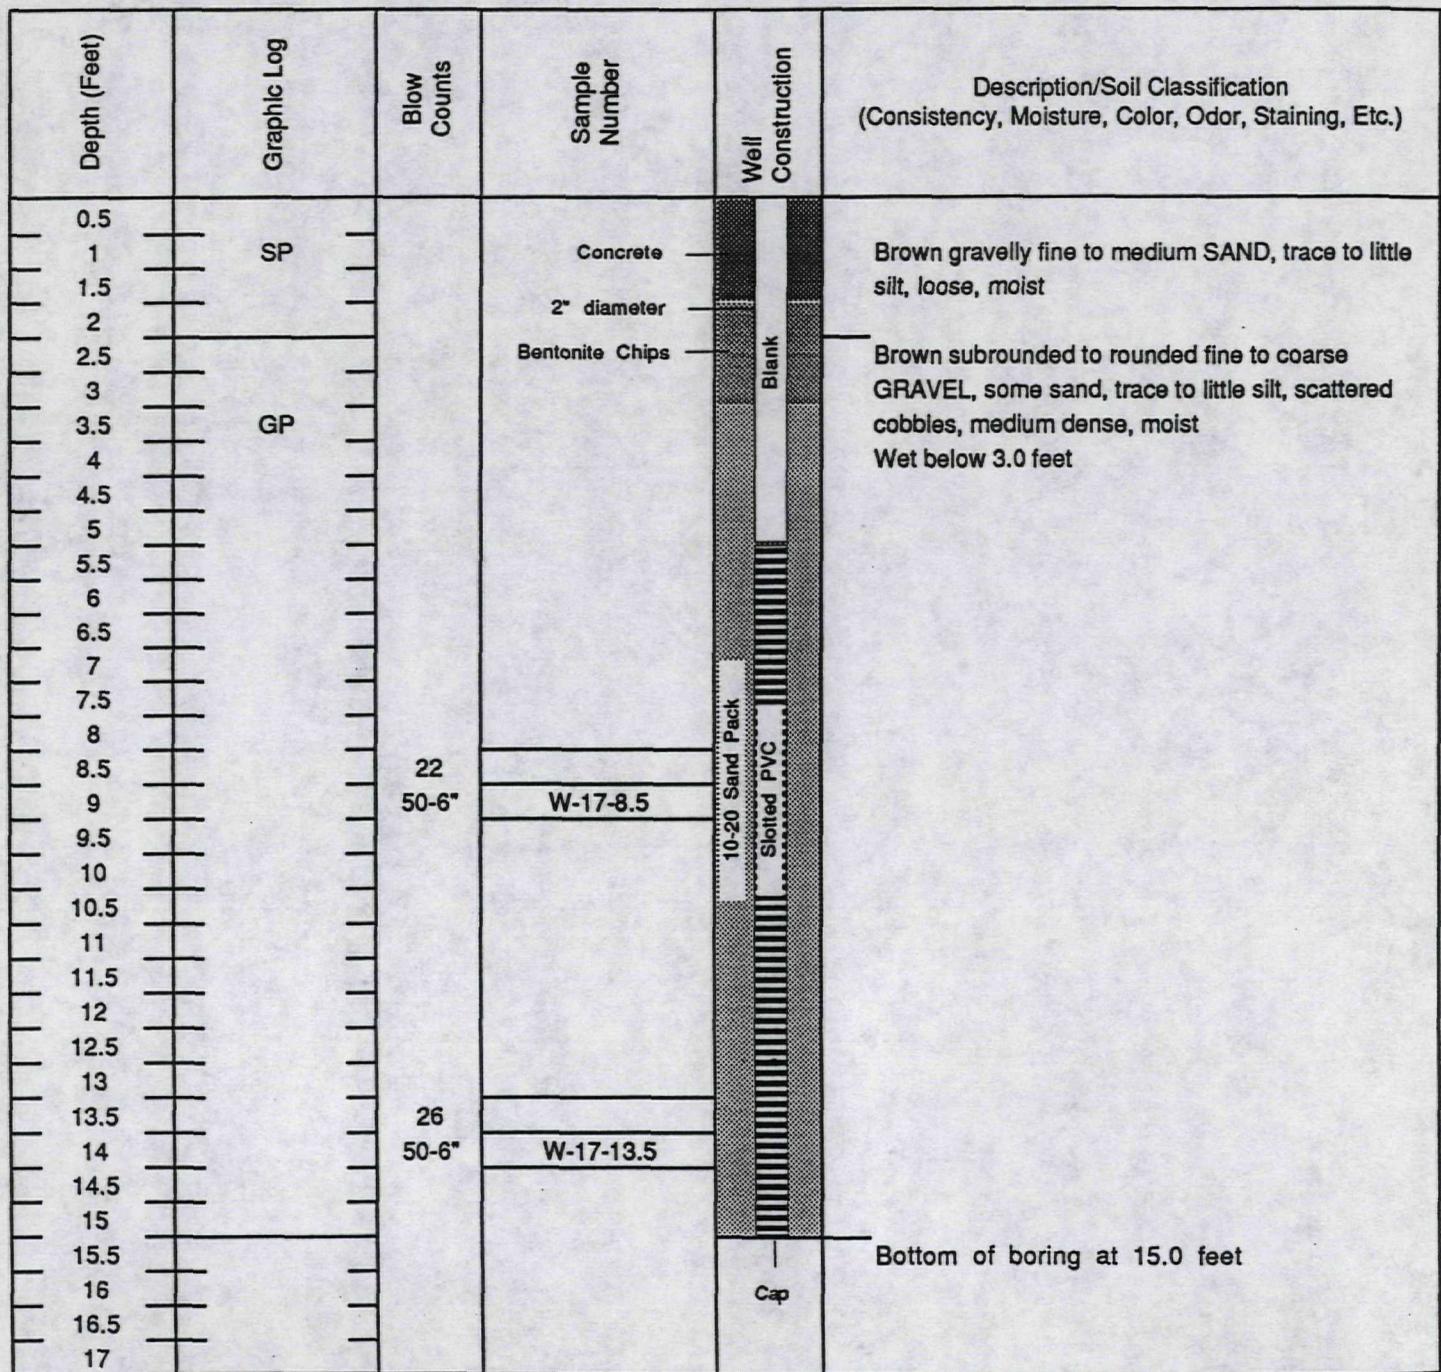

## **Appendix C**

## APPENDIX C



### *HELP MODEL OUTPUT*

\*\*\*\*\*  
\*\*\*\*\*  
\*\*  
\*\*  
\*\* HYDROLOGIC EVALUATION OF LANDFILL PERFORMANCE \*\*  
\*\* HELP MODEL VERSION 3.01 (14 OCTOBER 1994) \*\*  
\*\* DEVELOPED BY ENVIRONMENTAL LABORATORY \*\*  
\*\* USAE WATERWAYS EXPERIMENT STATION \*\*  
\*\* FOR USEPA RISK REDUCTION ENGINEERING LABORATORY \*\*  
\*\*  
\*\*  
\*\*\*\*\*  
\*\*\*\*\*

PRECIPITATION DATA FILE: C:\HELP3\PREYAK.D4  
TEMPERATURE DATA FILE: C:\HELP3\TEMPYAK.D7  
SOLAR RADIATION DATA FILE: C:\HELP3\SRYAK.D13  
EVAPOTRANSPIRATION DATA: C:\HELP3\ETYAKIMA.D11  
SOIL AND DESIGN DATA FILE: C:\HELP3\DATA10.D10  
OUTPUT DATA FILE: C:\HELP3\YAKK.OUT

TIME: 15:12 DATE: 10/27/1997

\*\*\*\*\*  
\*\*\*\*\*

TITLE: FMCYAKIMA

\*\*\*\*\*  
\*\*\*\*\*

NOTE: INITIAL MOISTURE CONTENT OF THE LAYERS AND SNOW WATER WERE  
COMPUTED AS NEARLY STEADY-STATE VALUES BY THE PROGRAM.

LAYER 1

-----

TYPE 1 - VERTICAL PERCOLATION LAYER

MATERIAL TEXTURE NUMBER 6

THICKNESS = 36.00 INCHES  
POROSITY = 0.4530 VOL/VOL  
FIELD CAPACITY = 0.1900 VOL/VOL  
WILTING POINT = 0.0850 VOL/VOL  
INITIAL SOIL WATER CONTENT = 0.1472 VOL/VOL

EFFECTIVE SAT. HYD. COND. = 0.720000011000E-03 CM/SEC  
NOTE: SATURATED HYDRAULIC CONDUCTIVITY IS MULTIPLIED BY 1.34  
FOR ROOT CHANNELS IN TOP HALF OF EVAPORATIVE ZONE.

LAYER 2

TYPE 1 - VERTICAL PERCOLATION LAYER

MATERIAL TEXTURE NUMBER 4

THICKNESS = 36.00 INCHES  
POROSITY = 0.4370 VOL/VOL  
FIELD CAPACITY = .01050 VOL/VOL  
WILTING POINT = 0.0470 VOL/VOL  
INITIAL SOIL WATER CONTENT = 0.1165 VOL/VOL  
EFFECTIVE SAT. HYD. COND. = 0.170000002000E-02 CM/SEC

LAYER 3

TYPE 1 - VERTICAL PERCOLATION LAYER

MATERIAL TEXTURE NUMBER 8

THICKNESS = 24.00 INCHES  
POROSITY = 0.4630 VOL/VOL  
FIELD CAPACITY = 0.2320 VOL/VOL  
WILTING POINT = 0.1160 VOL/VOL  
INITIAL SOIL WATER CONTENT = 0.2121 VOL/VOL  
EFFECTIVE SAT. HYD. COND. = 0.36999994000E-03 CM/SEC

GENERAL DESIGN AND EVAPORATIVE ZONE DATA

NOTE: SCS RUNOFF CURVE NUMBER WAS COMPUTED FROM DEFAULT  
SOIL DATA BASE USING SOIL TEXTURE # 6 WITH BARE  
GROUND CONDITIONS, A SURFACE SLOPE OF 1% AND  
A SLOPE LENGTH OF 70. FEET.

SCS RUNOFF CURVE NUMBER = 86.30  
FRACTION OF AREA ALLOWING RUNOFF = 100.0 PERCENT  
AREA PROJECTED ON HORIZONTAL PLANE = 0.100 ACRES  
EVAPORATIVE ZONE DEPTH = 24.0 INCHES  
INITIAL WATER IN EVAPORATIVE ZONE = 3.020 INCHES  
UPPER LIMIT OF EVAPORATIVE STORAGE = 10.872 INCHES  
LOWER LIMIT OF EVAPORATIVE STORAGE = 2.040 INCHES  
INITIAL SNOW WATER = 0.000 INCHES

INITIAL WATER IN LAYER MATERIALS = 14.583 INCHES  
TOTAL INITIAL WATER = 14.583 INCHES  
TOTAL SUBSURFACE INFLOW = 0.00 INCHES/YEAR

#### EVAPOTRANSPIRATION AND WEATHER DATA

---

NOTE: EVAPOTRANSPIRATION DATA WAS OBTAINED FROM  
YAKIMA WASHINGTON

MAXIMUM LEAF AREA INDEX = 0.50  
START OF GROWING SEASON (JULIAN DATE) = 108  
END OF GROWING SEASON (JULIAN DATE) = 292  
AVERAGE ANNUAL WIND SPEED = 7.10 MPH  
AVERAGE 1ST QUARTER RELATIVE HUMIDITY = 70.00 %  
AVERAGE 2ND QUARTER RELATIVE HUMIDITY = 49.00 %  
AVERAGE 3RD QUARTER RELATIVE HUMIDITY = 49.00 %  
AVERAGE 4TH QUARTER RELATIVE HUMIDITY = 73.00 %

NOTE: PRECIPITATION DATA FOR YAKIMA WASHINGTON  
WAS ENTERED FROM THE DEFAULT DATA FILE.

NOTE: TEMPERATURE DATA WAS SYNTHETICALLY GENERATED USING  
COEFFICIENTS FOR YAKIMA WASHINGTON

NORMAL MEAN MONTHLY TEMPERATURE (DEGREES FAHRENHEIT)

JAN/JUL	FEB/AUG	MAR/SEP	APR/OCT	MAY/NOV	JUN/DEC
28.20	36.10	41.90	49.20	57.30	64.50
70.40	68.60	60.90	49.90	38.20	31.50

NOTE: SOLAR RADIATION DATA WAS SYNTHETICALLY GENERATED USING  
COEFFICIENTS FOR YAKIMA WASHINGTON

STATION LATITUDE = 46.34 DEGREES

\*\*\*\*\*

MONTHLY TOTALS (IN INCHES) FOR YEAR 1974

JAN/JUL FEB/AUG MAR/SEP APR/OCT MAY/NOV JUN/DEC

PRECIPITATION        1.67  0.85  1.21  1.46  0.80  0.12  
                      0.18  0.00  0.02  0.45  0.30  1.14

RUNOFF              0.938  0.000  0.000  0.023  0.000  0.000  
                      0.000  0.000  0.000  0.000  0.000  0.000

EVAPOTRANSPIRATION        0.647  1.032  1.598  1.342  1.379  0.157  
                      0.154  0.023  0.020  0.023  0.670  0.581

PERCOLATION THROUGH        0.0229  0.0194  0.0204  0.0188  0.0183  0.0168  
LAYER 3                0.0168  0.0160  0.0148  0.0147  0.0137  0.0135

\*\*\*\*\*

\*\*\*\*\*

ANNUAL TOTALS FOR YEAR 1974

	INCHES	CU. FEET	PERCENT
PRECIPITATION	8.20	2976.601	100.00
RUNOFF	0.961	348.804	11.72
EVAPOTRANSPIRATION	7.626	2768.176	93.00
PERC./LEAKAGE THROUGH LAYER 3	0.206154	74.834	2.51
CHANGE IN WATER STORAGE	-0.593	-215.214	-7.23
SOIL WATER AT START OF YEAR	14.583	5293.605	
SOIL WATER AT END OF YEAR	13.990	5078.391	
SNOW WATER AT START OF YEAR	0.000	0.000	0.00
SNOW WATER AT END OF YEAR	0.000	0.000	0.00
ANNUAL WATER BUDGET BALANCE	0.0000	0.001	0.00

\*\*\*\*\*

\*\*\*\*\*  
MONTHLY TOTALS (IN INCHES) FOR YEAR 1975

JAN/JUL FEB/AUG MAR/SEP APR/OCT MAY/NOV JUN/DEC

PRECIPITATION	2.28	1.16	0.49	0.40	0.23	0.22
	0.18	2.10	0.00	0.79	0.43	0.55

RUNOFF	0.387	0.822	0.010	0.000	0.000	0.000
	0.000	0.077	0.000	0.000	0.000	0.067

EVAPOTRANSPIRATION	0.548	0.828	1.554	0.649	0.331	0.135
	0.193	1.762	0.368	0.500	0.432	0.332

PERCOLATION THROUGH LAYER 3	0.0131	0.0114	0.0121	0.0113	0.0108	0.0104
	0.0104	0.0100	0.0094	0.0094	0.0088	0.0089

\*\*\*\*\*  
\*\*\*\*\*  
\*\*\*\*\*

ANNUAL TOTALS FOR YEAR 1975

	INCHES	CU. FEET	PERCENT
PRECIPITATION	8.83	3205.292	100.00
RUNOFF	1.364	495.056	15.44
EVAPOTRANSPIRATION	7.635	2771.350	86.46
PERC./LEAKAGE THROUGH LAYER 3	0.125833	45.677	1.43
CHANGE IN WATER STORAGE	-0.294	-106.794	-3.33
SOIL WATER AT START OF YEAR	13.990	5078.391	
SOIL WATER AT END OF YEAR	13.696	4971.597	
SNOW WATER AT START OF YEAR	0.000	0.000	0.00
SNOW WATER AT END OF YEAR	0.000	0.000	0.00
ANNUAL WATER BUDGET BALANCE	0.0000	0.002	0.00

\*\*\*\*\*  
\*\*\*\*\*

\*\*\*\*\*  
MONTHLY TOTALS (IN INCHES) FOR YEAR 1976

JAN/JUL FEB/AUG MAR/SEP APR/OCT MAY/NOV JUN/DEC

PRECIPITATION	0.56	0.78	0.70	0.33	0.09	0.69
	0.26	0.50	0.13	0.07	0.00	0.07

RUNOFF	0.059	0.000	0.000	0.000	0.000	0.000
	0.000	0.000	0.000	0.000	0.000	0.000

EVAPOTRANSPIRATION	0.481	0.540	0.788	0.875	0.118	0.495
	0.480	0.275	0.218	0.170	0.035	0.048

PERCOLATION THROUGH LAYER 3	0.0089	0.0076	0.0082	0.0078	0.0078	0.0076
	0.0077	0.0075	0.0072	0.0073	0.0070	0.0071

\*\*\*\*\*  
ANNUAL TOTALS FOR YEAR 1976

	INCHES	CU. FEET	PERCENT
PRECIPITATION	4.18	1517.340	100.00
RUNOFF	0.059	21.458	1.41
EVAPOTRANSPIRATION	4.523	1641.689	108.20
PERC./LEAKAGE THROUGH LAYER 3	0.091848	33.341	2.20
CHANGE IN WATER STORAGE	-0.494	-179.147	-11.81
SOIL WATER AT START OF YEAR	13.696	4971.597	
SOIL WATER AT END OF YEAR	13.202	4792.450	
SNOW WATER AT START OF YEAR	0.000	0.000	0.00
SNOW WATER AT END OF YEAR	0.000	0.000	0.00
ANNUAL WATER BUDGET BALANCE	0.0000	-0.001	0.00

\*\*\*\*\*

\*\*\*\*\*

MONTHLY TOTALS (IN INCHES) FOR YEAR 1977

JAN/JUL FEB/AUG MAR/SEP APR/OCT MAY/NOV JUN/DEC

PRECIPITATION        0.12  0.31  0.62  0.01  0.64  0.50  
                    0.00  1.16  0.89  0.17  0.70  2.80

RUNOFF              0.000  0.000  0.000  0.000  0.000  0.000  
                    0.000  0.000  0.000  0.000  0.000  1.620

EVAPOTRANSPIRATION        0.131  0.049  0.916  0.008  0.553  0.625  
                    0.000  0.620  1.065  0.392  0.286  0.563

PERCOLATION THROUGH        0.0070  0.0063  0.0069  0.0066  0.0066  0.0064  
LAYER 3              0.0067  0.0066  0.0063  0.0065  0.0062  0.0064

\*\*\*\*\*

\*\*\*\*\*

ANNUAL TOTALS FOR YEAR 1977

	INCHES	CU. FEET	PERCENT
PRECIPITATION	7.92	2874.961	100.00
RUNOFF	1.620	587.910	20.45
EVAPOTRANSPIRATION	5.207	1890.056	65.74
PERC./LEAKAGE THROUGH LAYER 3	0.078526	28.505	0.99
CHANGE IN WATER STORAGE	1.015	368.488	12.82
SOIL WATER AT START OF YEAR	13.202	4792.450	
SOIL WATER AT END OF YEAR	13.929	5056.279	
SNOW WATER AT START OF YEAR	0.000	0.000	0.00
SNOW WATER AT END OF YEAR	0.288	104.659	3.64

ANNUAL WATER BUDGET BALANCE      0.0000      0.002      0.00

\*\*\*\*\*

\*\*\*\*\*

MONTHLY TOTALS (IN INCHES) FOR YEAR 1978

JAN/JUL FEB/AUG MAR/SEP APR/OCT MAY/NOV JUN/DEC

PRECIPITATION      2.27    1.33    0.52    0.91    0.28    0.32  
                      0.29    0.38    0.64    0.00    0.76    0.32

RUNOFF      1.455    0.299    0.014    0.000    0.000    0.000  
                      0.000    0.000    0.000    0.000    0.000    0.000

EVAPOTRANSPIRATION      0.526    0.830    1.735    0.763    0.385    0.388  
                      0.488    0.432    0.736    0.000    0.339    0.560

PERCOLATION THROUGH  
LAYER 3      0.0063    0.0057    0.0063    0.0060    0.0061    0.0059  
                      0.0061    0.0061    0.0059    0.0060    0.0058    0.0060

\*\*\*\*\*

\*\*\*\*\*

ANNUAL TOTALS FOR YEAR 1978

	INCHES	CU. FEET	PERCENT
PRECIPITATION	8.02	2911.261	100.00
RUNOFF	1.768	641.871	22.05
EVAPOTRANSPIRATION	7.181	2606.651	89.54
PERC./LEAKAGE THROUGH LAYER 3	0.072205	26.211	0.90
CHANGE IN WATER STORAGE	-1.001	-363.472	-12.49
SOIL WATER AT START OF YEAR	13.929	5056.279	
SOIL WATER AT END OF YEAR	13.216	4797.466	
SNOW WATER AT START OF YEAR	0.288	104.659	3.59

SNOW WATER AT END OF YEAR	0.000	0.000	0.00
ANNUAL WATER BUDGET BALANCE	0.0000	0.001	0.00

\*\*\*\*\*

\*\*\*\*\*

#### AVERAGE MONTHLY VALUES IN INCHES FOR YEARS 1974 THROUGH 1978

JAN/JUL FEB/AUG MAR/SEP APR/OCT MAY/NOV JUN/DEC

##### PRECIPITATION

TOTALS	1.38	0.89	0.71	0.62	0.41	0.37
	0.18	0.83	0.34	0.30	0.44	0.98

STD. DEVIATIONS	0.99	0.39	0.29	0.57	0.30	0.23
	0.11	0.82	0.40	0.32	0.31	1.09

##### RUNOFF

TOTALS	0.568	0.224	0.005	0.005	0.000	0.000
	0.000	0.015	0.000	0.000	0.000	0.337

STD. DEVIATIONS	0.620	0.359	0.007	0.010	0.000	0.000
	0.000	0.034	0.000	0.000	0.000	0.717

##### EVAPOTRANSPIRATION

TOTALS	0.467	0.656	1.318	0.727	0.553	0.360
	0.263	0.622	0.481	0.217	0.352	0.417

STD. DEVIATIONS	0.197	0.382	0.433	0.481	0.487	0.213
	0.214	0.674	0.419	0.222	0.231	0.230

##### PERCOLATION/LEAKAGE THROUGH LAYER 3

TOTALS	0.0116	0.0101	0.0108	0.0101	0.0100	0.0094
	0.0095	0.0093	0.0087	0.0088	0.0083	0.0084

STD. DEVIATIONS	0.0068	0.0057	0.0058	0.0053	0.0050	0.0045
	0.0044	0.0041	0.0036	0.0036	0.0032	0.0031

\*\*\*\*\*

\*\*\*\*\*  
AVERAGE ANNUAL TOTALS & (STD. DEVIATIONS) FOR YEARS 1974 THROUGH 1978

	INCHES	CU. FEET	PERCENT
PRECIPITATION	7.43 ( 1.851)	2697.1	100.00
RUNOFF	1.154 ( 0.6845)	419.02	15.536
EVAPOTRANSPIRATION	6.434 ( 1.4645)	2335.58	86.596
PERCOLATION/LEAKAGE THROUGH FROM LAYER 3	0.11491 ( 0.05505)	41.714	1.54661
CHANGE IN WATER STORAGE	-0.273 ( 0.7650)	-99.23	-3.679

\*\*\*\*\*

\*\*\*\*\*  
PEAK DAILY VALUES FOR YEARS 1974 THROUGH 1978

	(INCHES)	(CU. FT.)
PRECIPITATION	1.40	508.200
RUNOFF	1.620	587.9096
PERCOLATION/LEAKAGE THROUGH LAYER 3	0.000863	0.31333
SNOW WATER	2.15	780.9247
MAXIMUM VEG. SOIL WATER (VOL/VOL)		0.1943
MINIMUM VEG. SOIL WATER (VOL/VOL)		0.0822

\*\*\*\*\*

\*\*\*\*\*  
FINAL WATER STORAGE AT END OF YEAR 1978

LAYER (INCHES) (VOL/VOL)

1 4.4942 0.1248

2 4.0430 0.1123

3 4.6789 0.1950

SNOW WATER 0.000

\*\*\*\*\*  
\*\*\*\*\*